


DW4
B-54

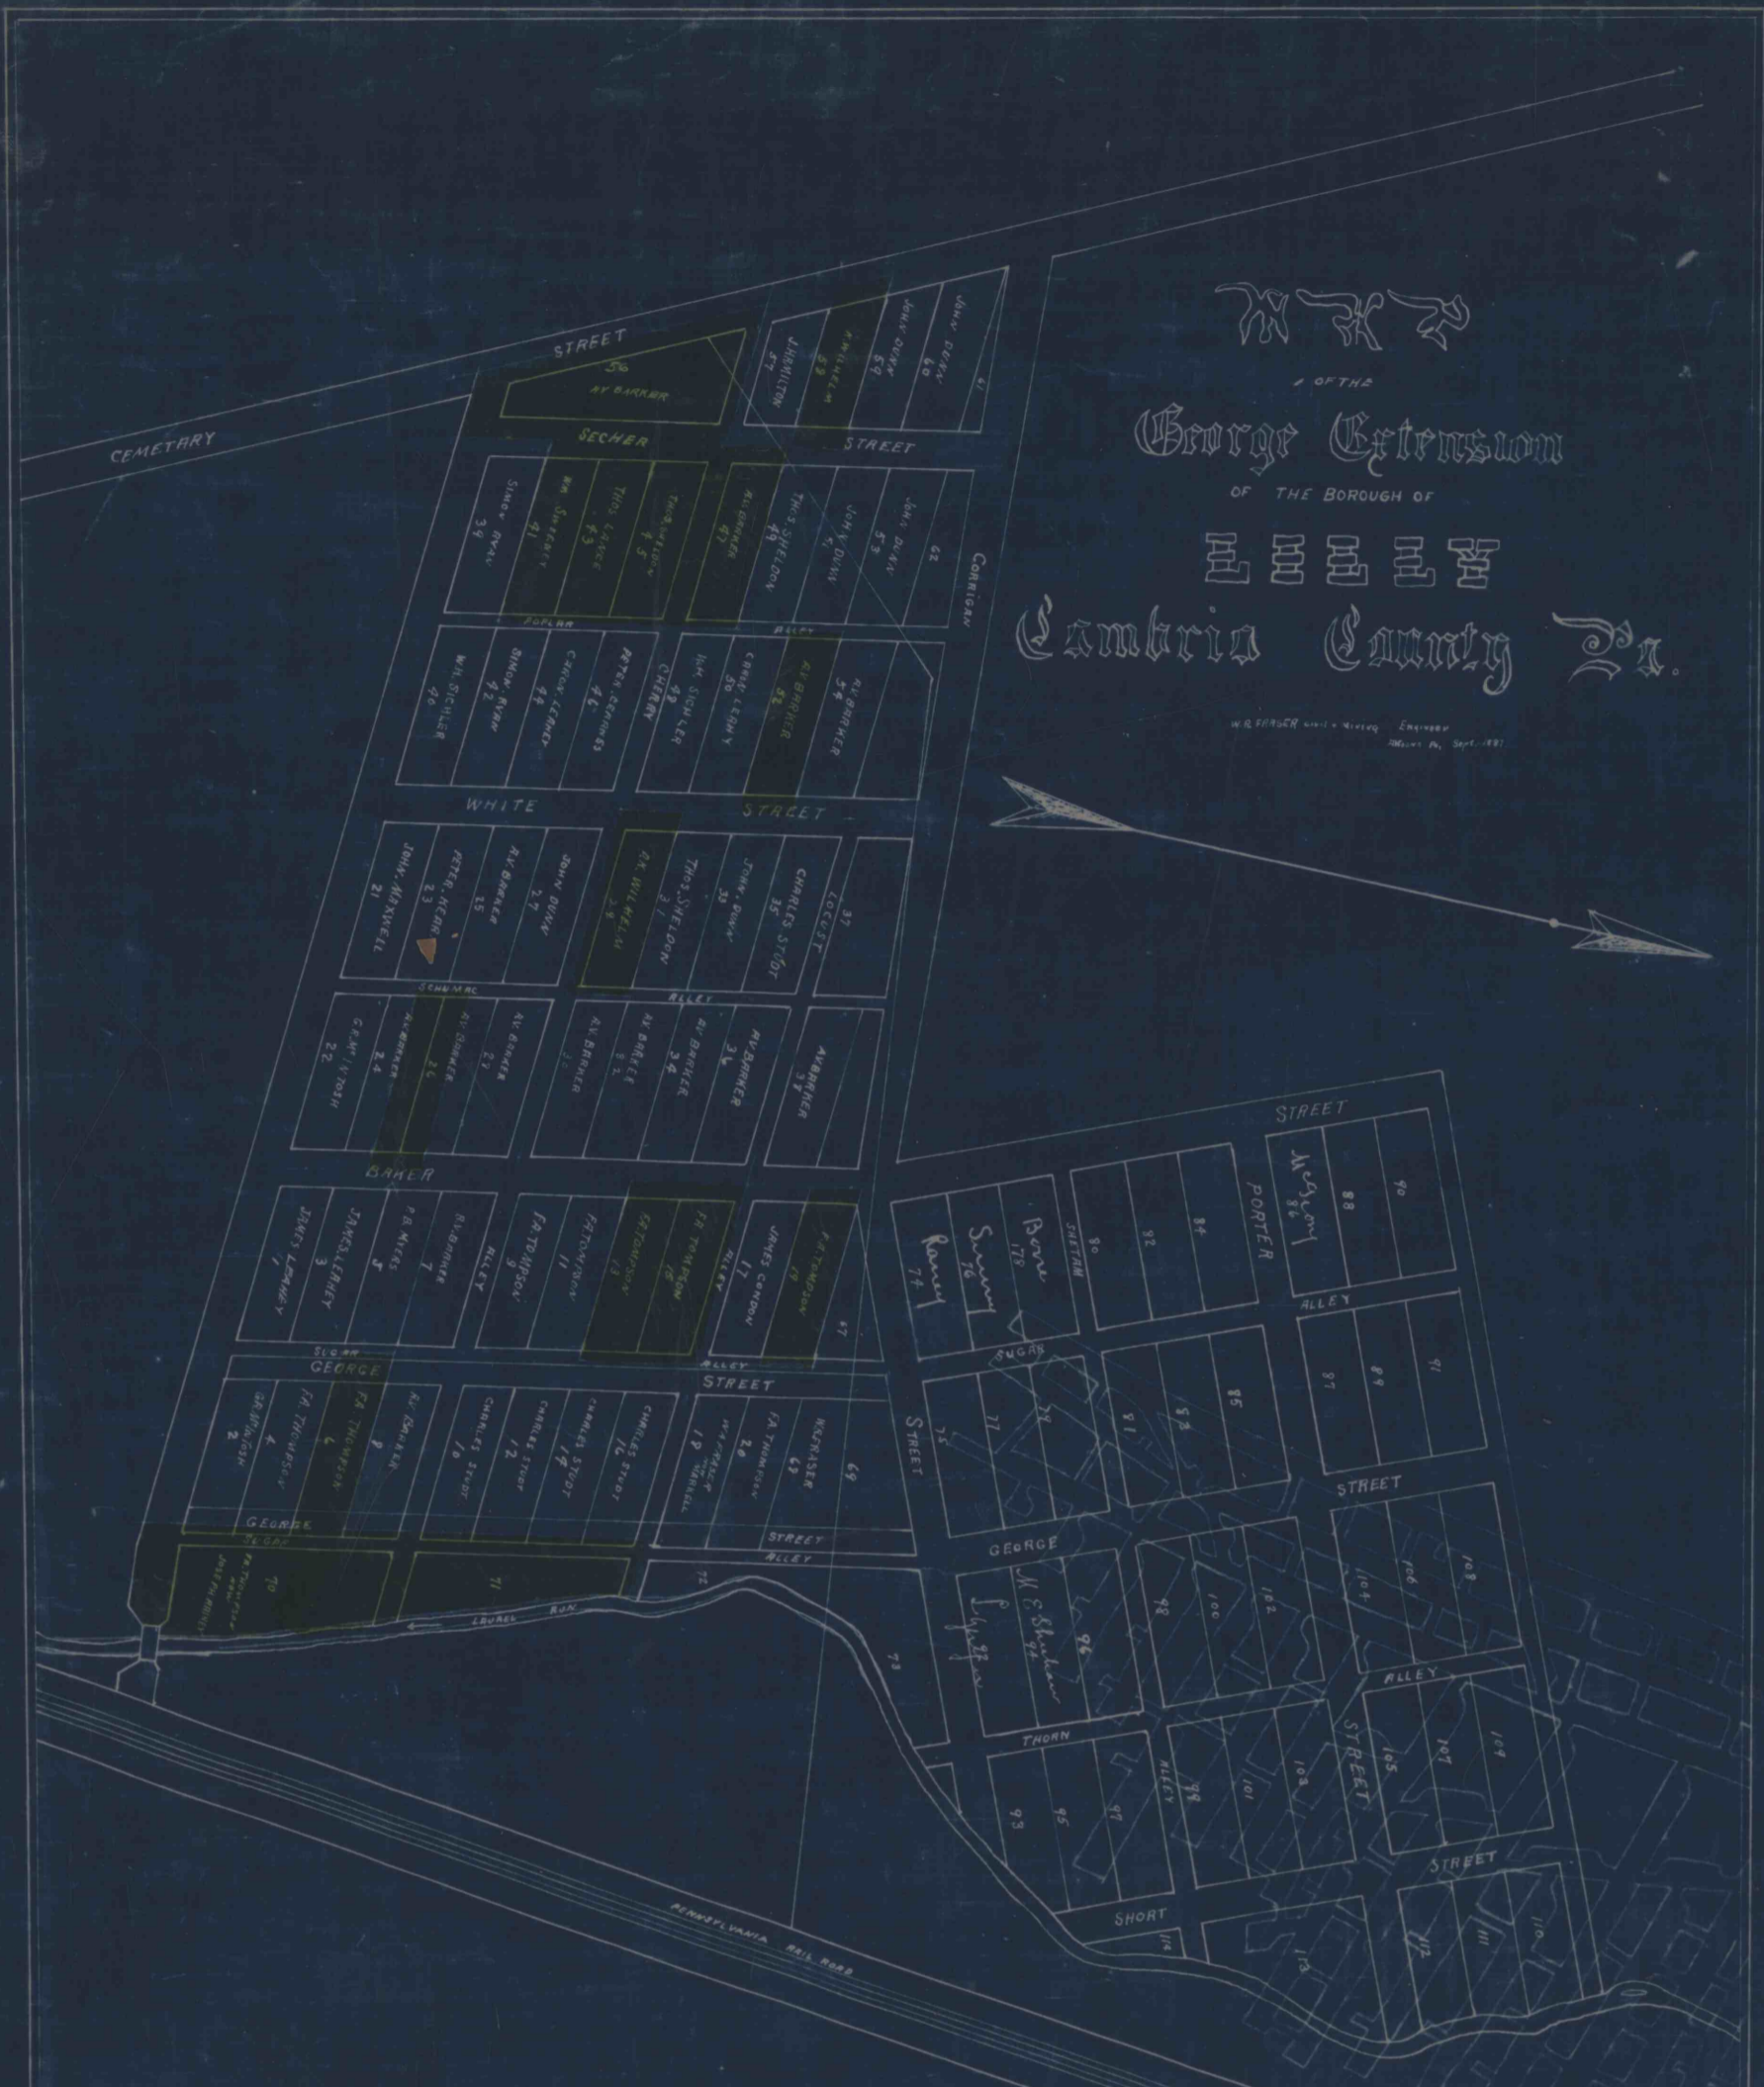

OF THE
George Extension
 OF THE BOROUGH OF
LILLY
 Cambria County Pa.

W. B. FROBER Surveyor & Engineer
 Done at Pa. Sept. 1881

To the Honorable the Judges of the Quarter Sessions Court of Cambria Co

The petition of the undersigned citizens and lot owners of the George Extension of Lilly Borough in said County respectfully represent:

That in Surveying and laying out lots in said Extension to said Borough two Streets - GEORGE and BARKER were laid out together and adjacent to each other without an alley intervening and it is inconvenient to said Citizens and lot owners thereof in that owners of lots building on either Street could erect stubs and out buildings on same street that residences were erected and create and become nuisances and that their convenience would greatly be promoted by allowing said George Street to an alley of fourteen feet in width to be known as Sugar Alley and making what is now known as Sugar Alley on draft of said Extension a Street of thirty three feet in width to be known as George Street or in other words to move the block of lots lying East of George Street West of Sugar Alley North of Church Street and South of Corrihan Street twenty one feet to the West and reverse the relative positions of George Street and Sugar Alley Acopy of said draft is here onto attached, the red lines showing the proposed change

The petitioners therefore pray that George Street and Sugar Alley in said George Extension of Lilly Borough may be altered in manner as aforesaid and they will &c.

- G. R. McIntosh
- F. A. Thompson
- Charles Sudt
- John Meckel
- Joseph Baines
- W. B. Frazier
- W. Barker
- Peter B. Lloyd

W. B. Frazier
 Lilly lots
 P

DW4
 B-54