

W. R. Fraser


George Extension

OF THE BOROUGH OF

Lilly

Cambria County Pa.

W. R. FRASER Civil + Mining Engineer
Williamsburg, Pa., Sept. 1887.

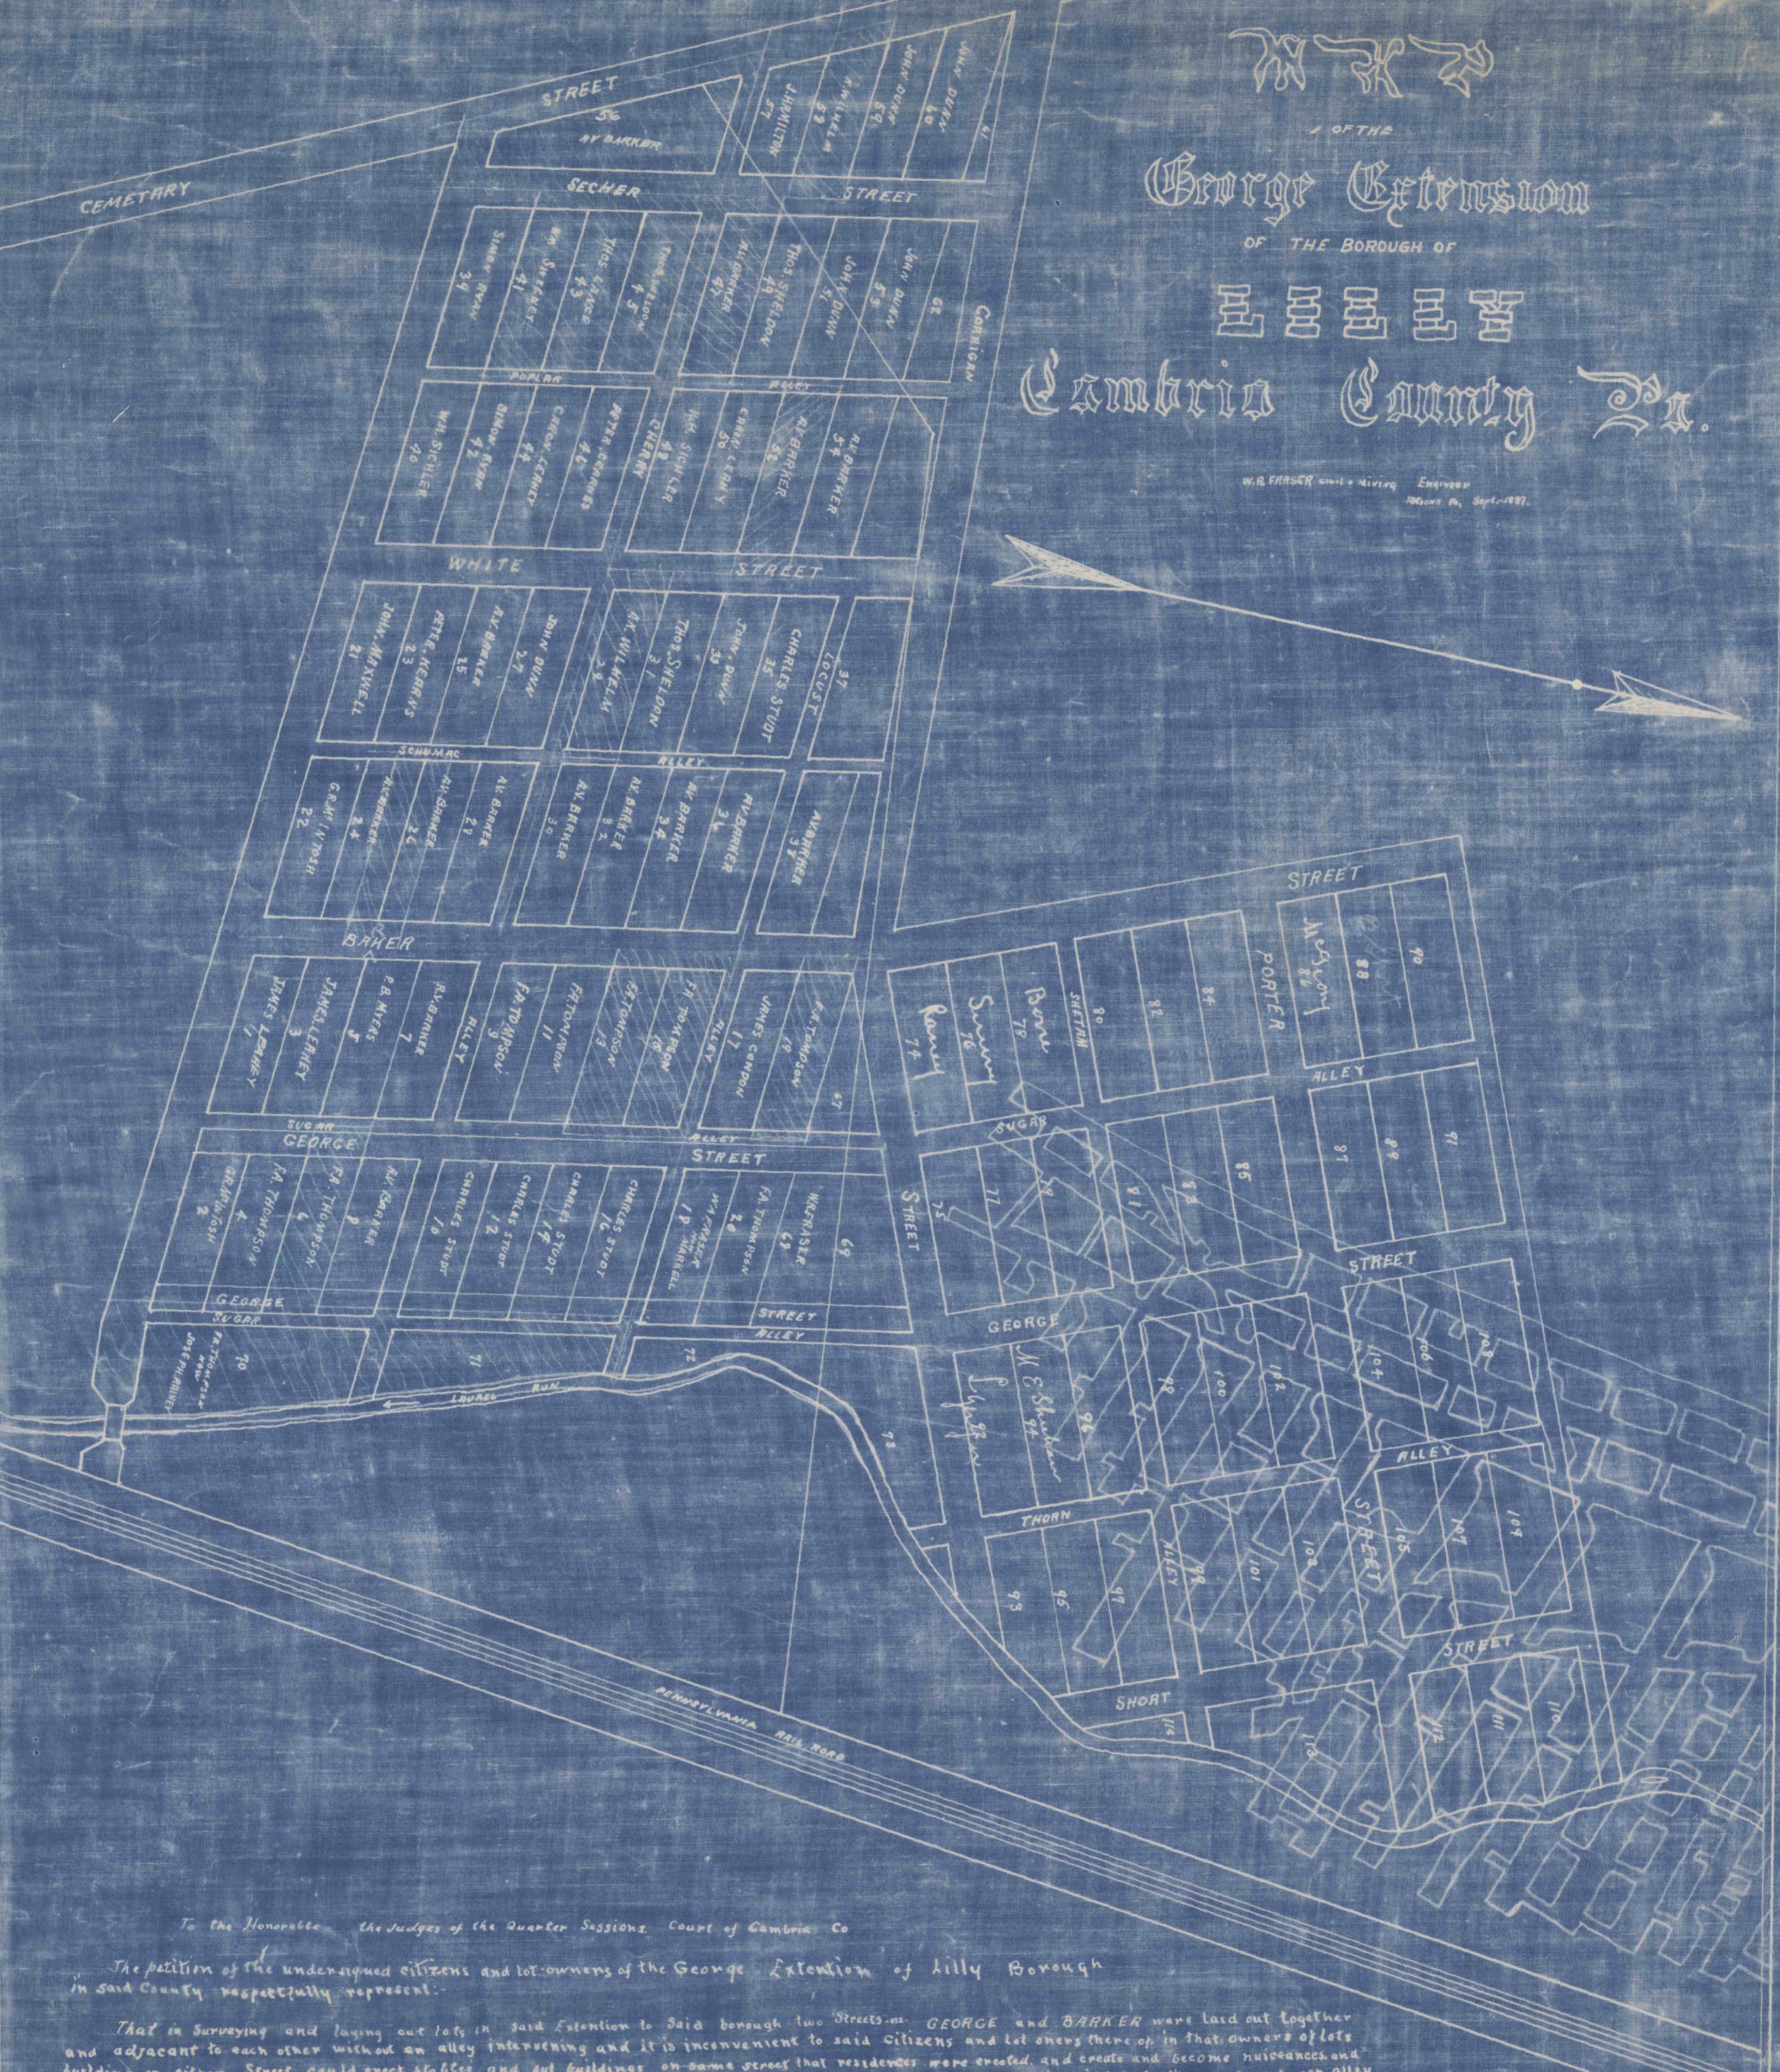

To the Honorable the Judges of the Quarter Sessions, Court of Cambria Co.

The petition of the undersigned citizens and lot owners of the George Extension of Lilly Borough in said County respectfully represent:

That in Surveying and laying out lots in said Extension to said borough two Streets viz. GEORGE and BARKER were laid out together and adjacent to each other without an alley intervening and it is inconvenient to said citizens and lot owners thereof that owners of lots building on either Street could erect stables, and out buildings on same street that residence were erected, and create and become nuisances and that their convenience would greatly promoted by altering said George Street to an alley of fourteen feet in width to be known as Sugar Alley and making what is now known as Sugar Alley on draft of said Extension a Street of thirty three feet in width to be known as George Street or in other words to move the block of lots laying East of George Street West of Sugar Alley North of Church Street and South of Cornigan Street twenty one feet to the West and reverse the relative positions of George Street and Sugar Alley. A copy of said draft is hereunto attached, the red lines showing the proposed change.

The petitioners therefore pray that George Street and Sugar Alley in said George Extension of Lilly Borough may be altered in manner as aforesaid and they will be so

G. R. McIntosh

F. A. Thompson

Charles Stodd

John McNeil

Joseph Brainer

W. R. Fraser

W. J. Barker

P. C. B. May