


4950

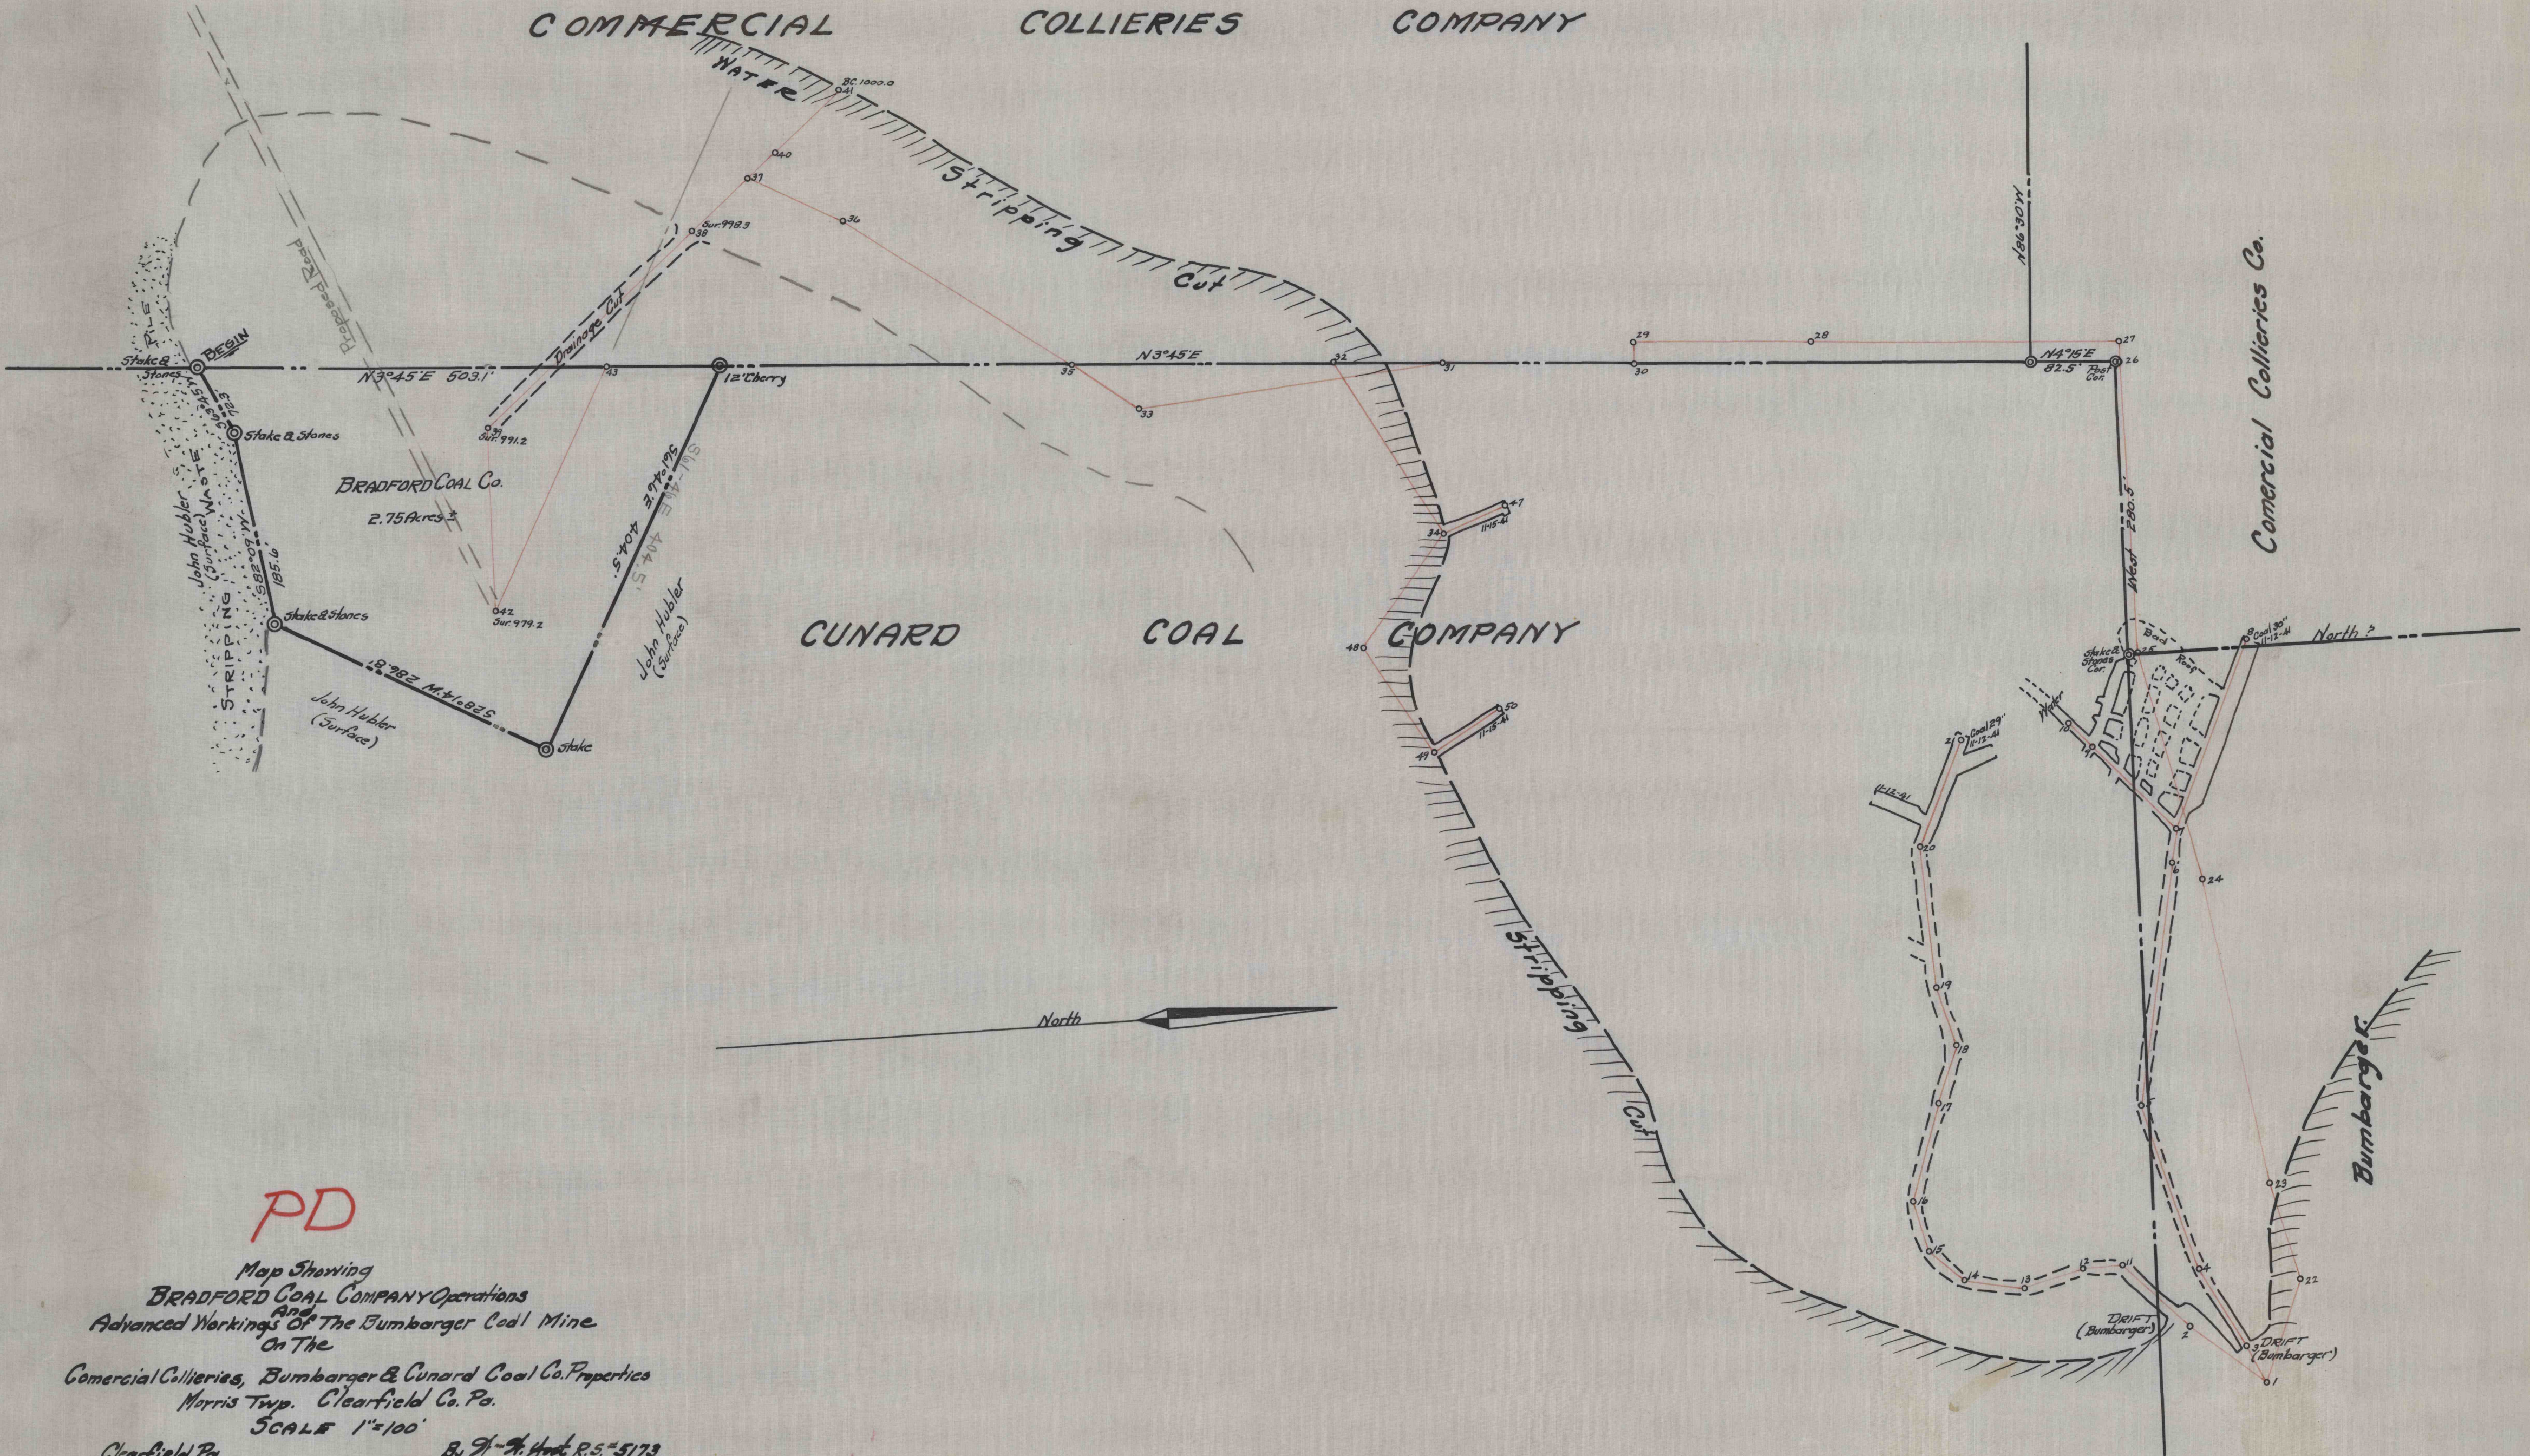

PD

Map Showing
 BRADFORD COAL COMPANY Operations
 and
 Advanced Workings of The Bumbarger Coal Mine
 on The
 Commercial Collieries, Bumbarger & Cunard Coal Co. Properties
 Morris Twp. Clearfield Co. Pa.
 SCALE 1"=100'

Clearfield Pa
 Nov. 20, 1941
 By J. H. Hunt R.S. 5173

Bk Y-255
 1168

Datum floored

4950

BD 1168