


4983

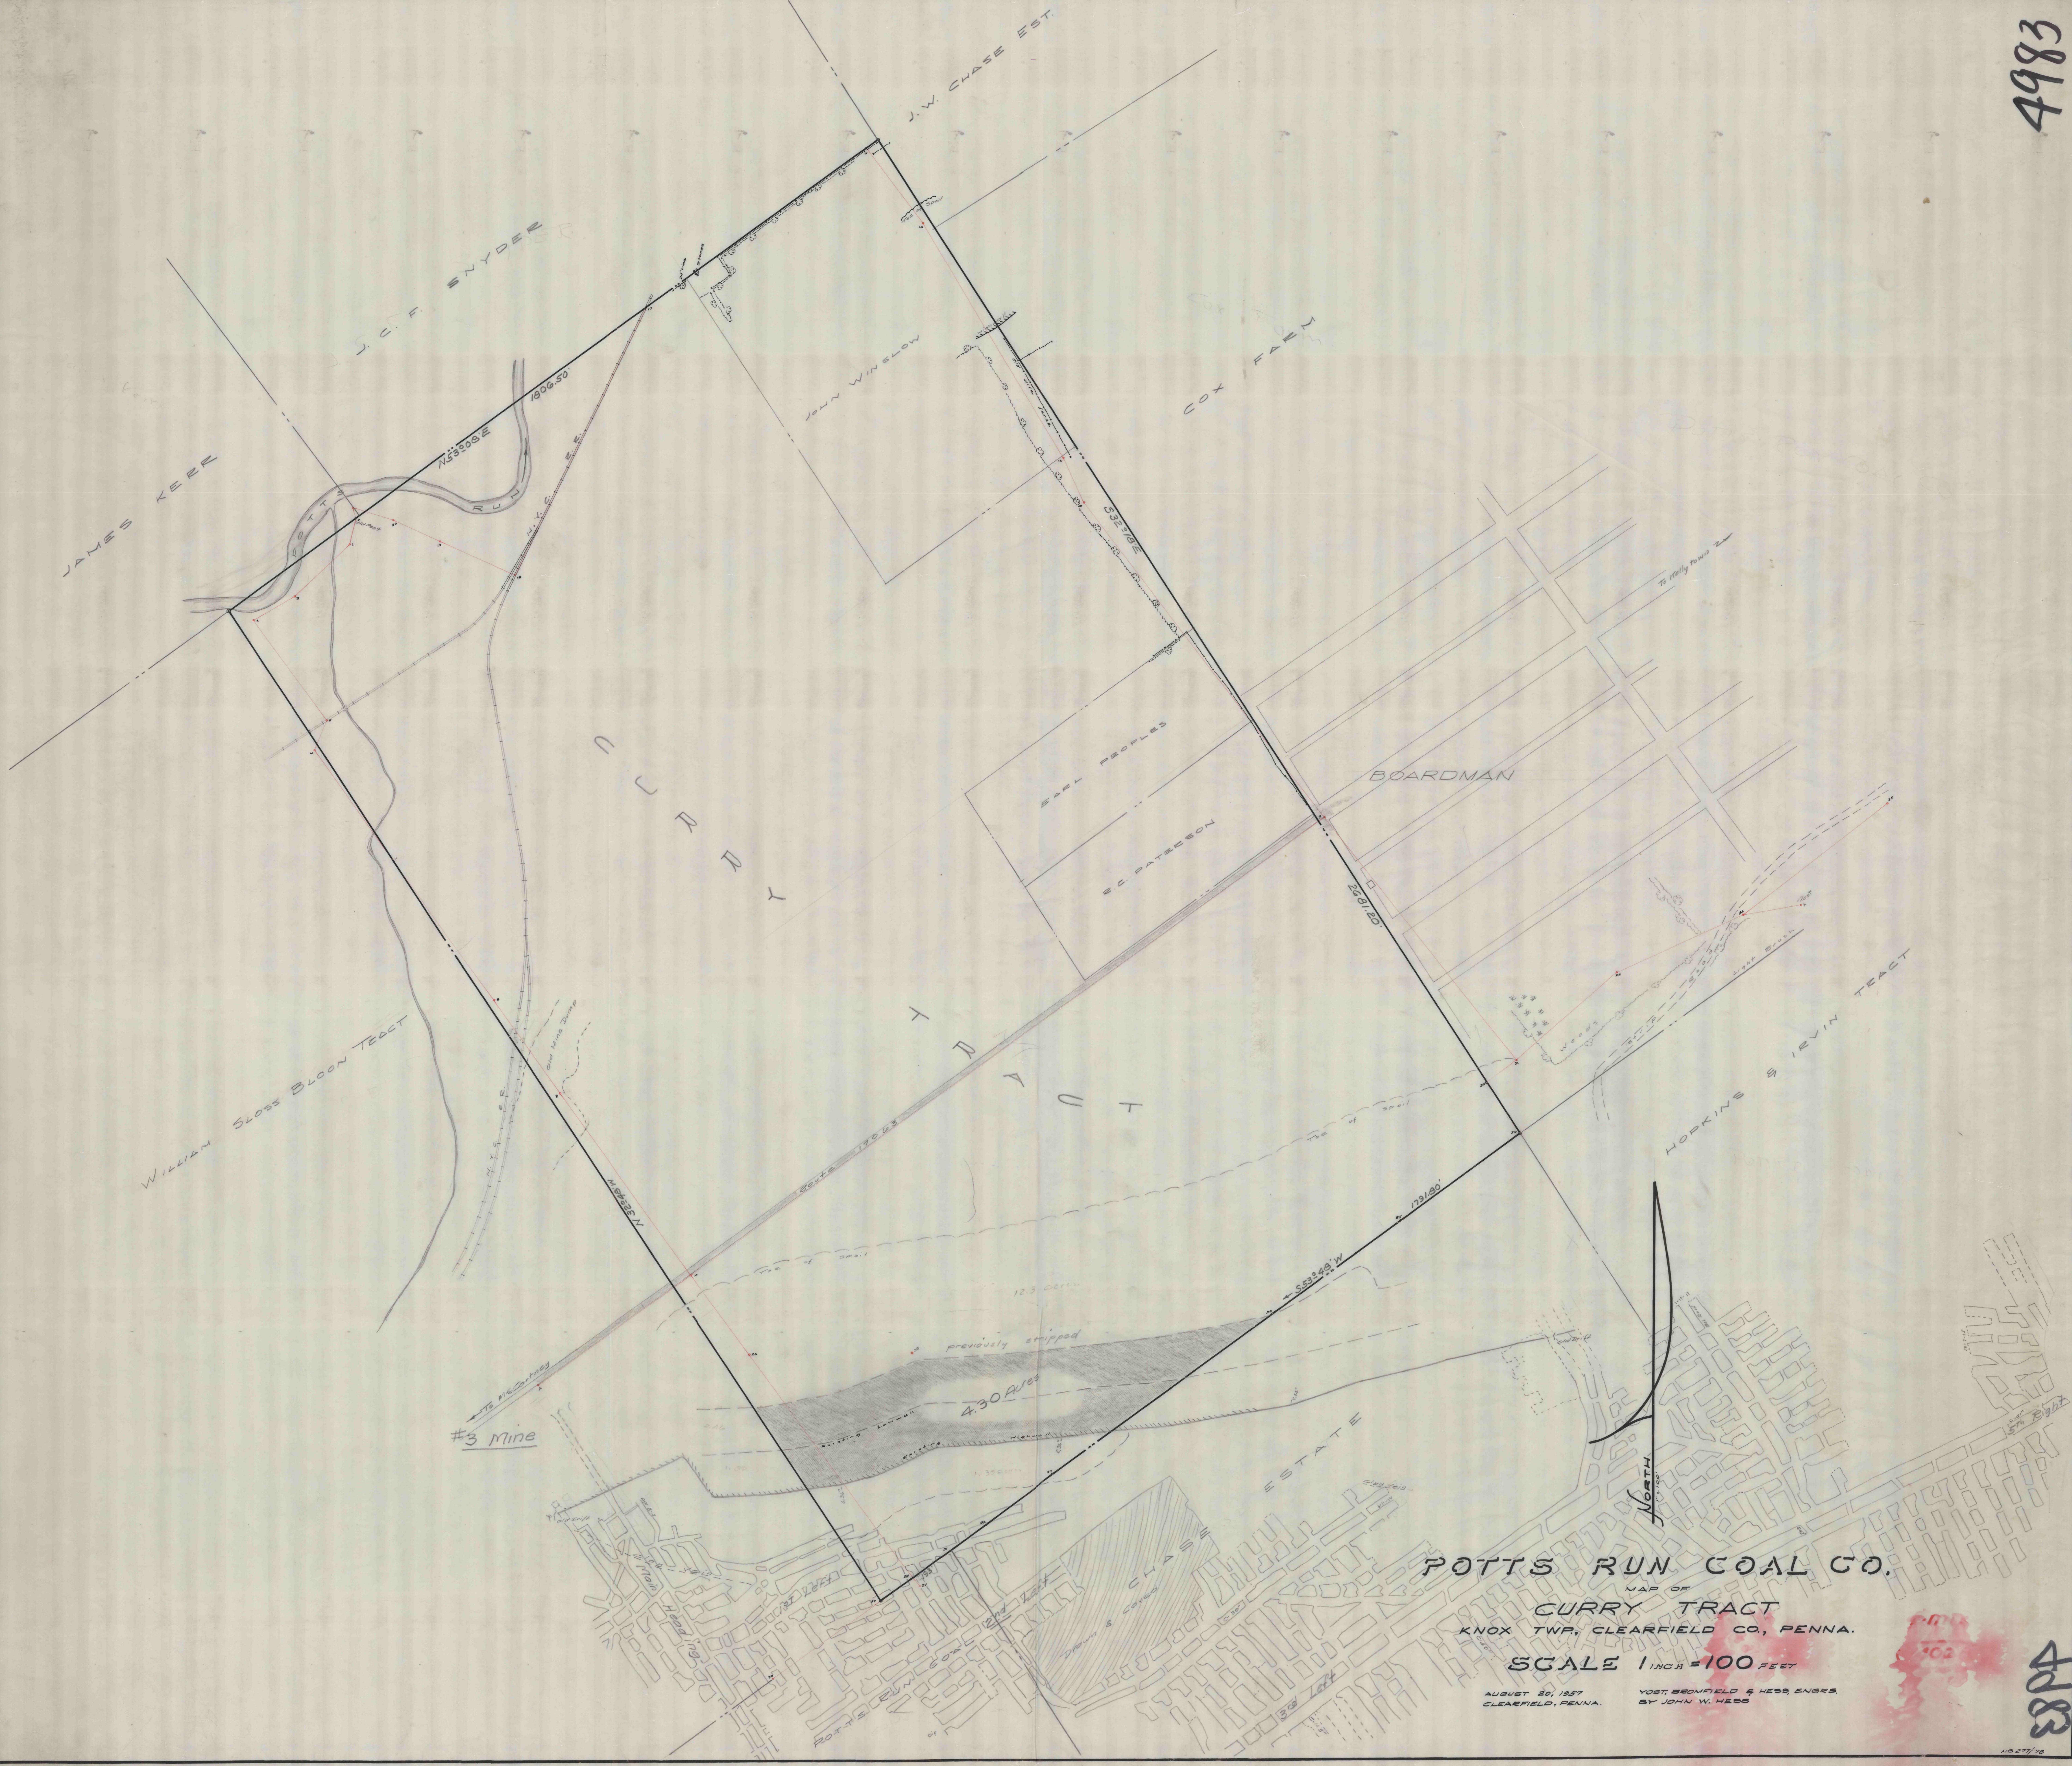

POTTS RUN COAL CO.
 MAP OF
 CURRY TRACT
 KNOX TWP., CLEARFIELD CO., PENNA.
 SCALE 1 INCH = 100 FEET

AUGUST 20, 1887
 CLEARFIELD, PENNA.
 BY JOHN W. HESS

4983

NO. 272/78