

8-1-08

JOHN PORTER

J. B. NORRIS

SOFT CLAY MINE OF BICKFORD FIRE BRICK CO. NEAR CURWENSVILLE, PA.

OCTOBER, 1908.

H. J. Hinterleitner Eng.

SCALE 100 FT. = 1 IN.


CLARK NORRIS

Reservation.

JAMES B. SMITH.

VORICE CLARK

MILTON MCCLURE

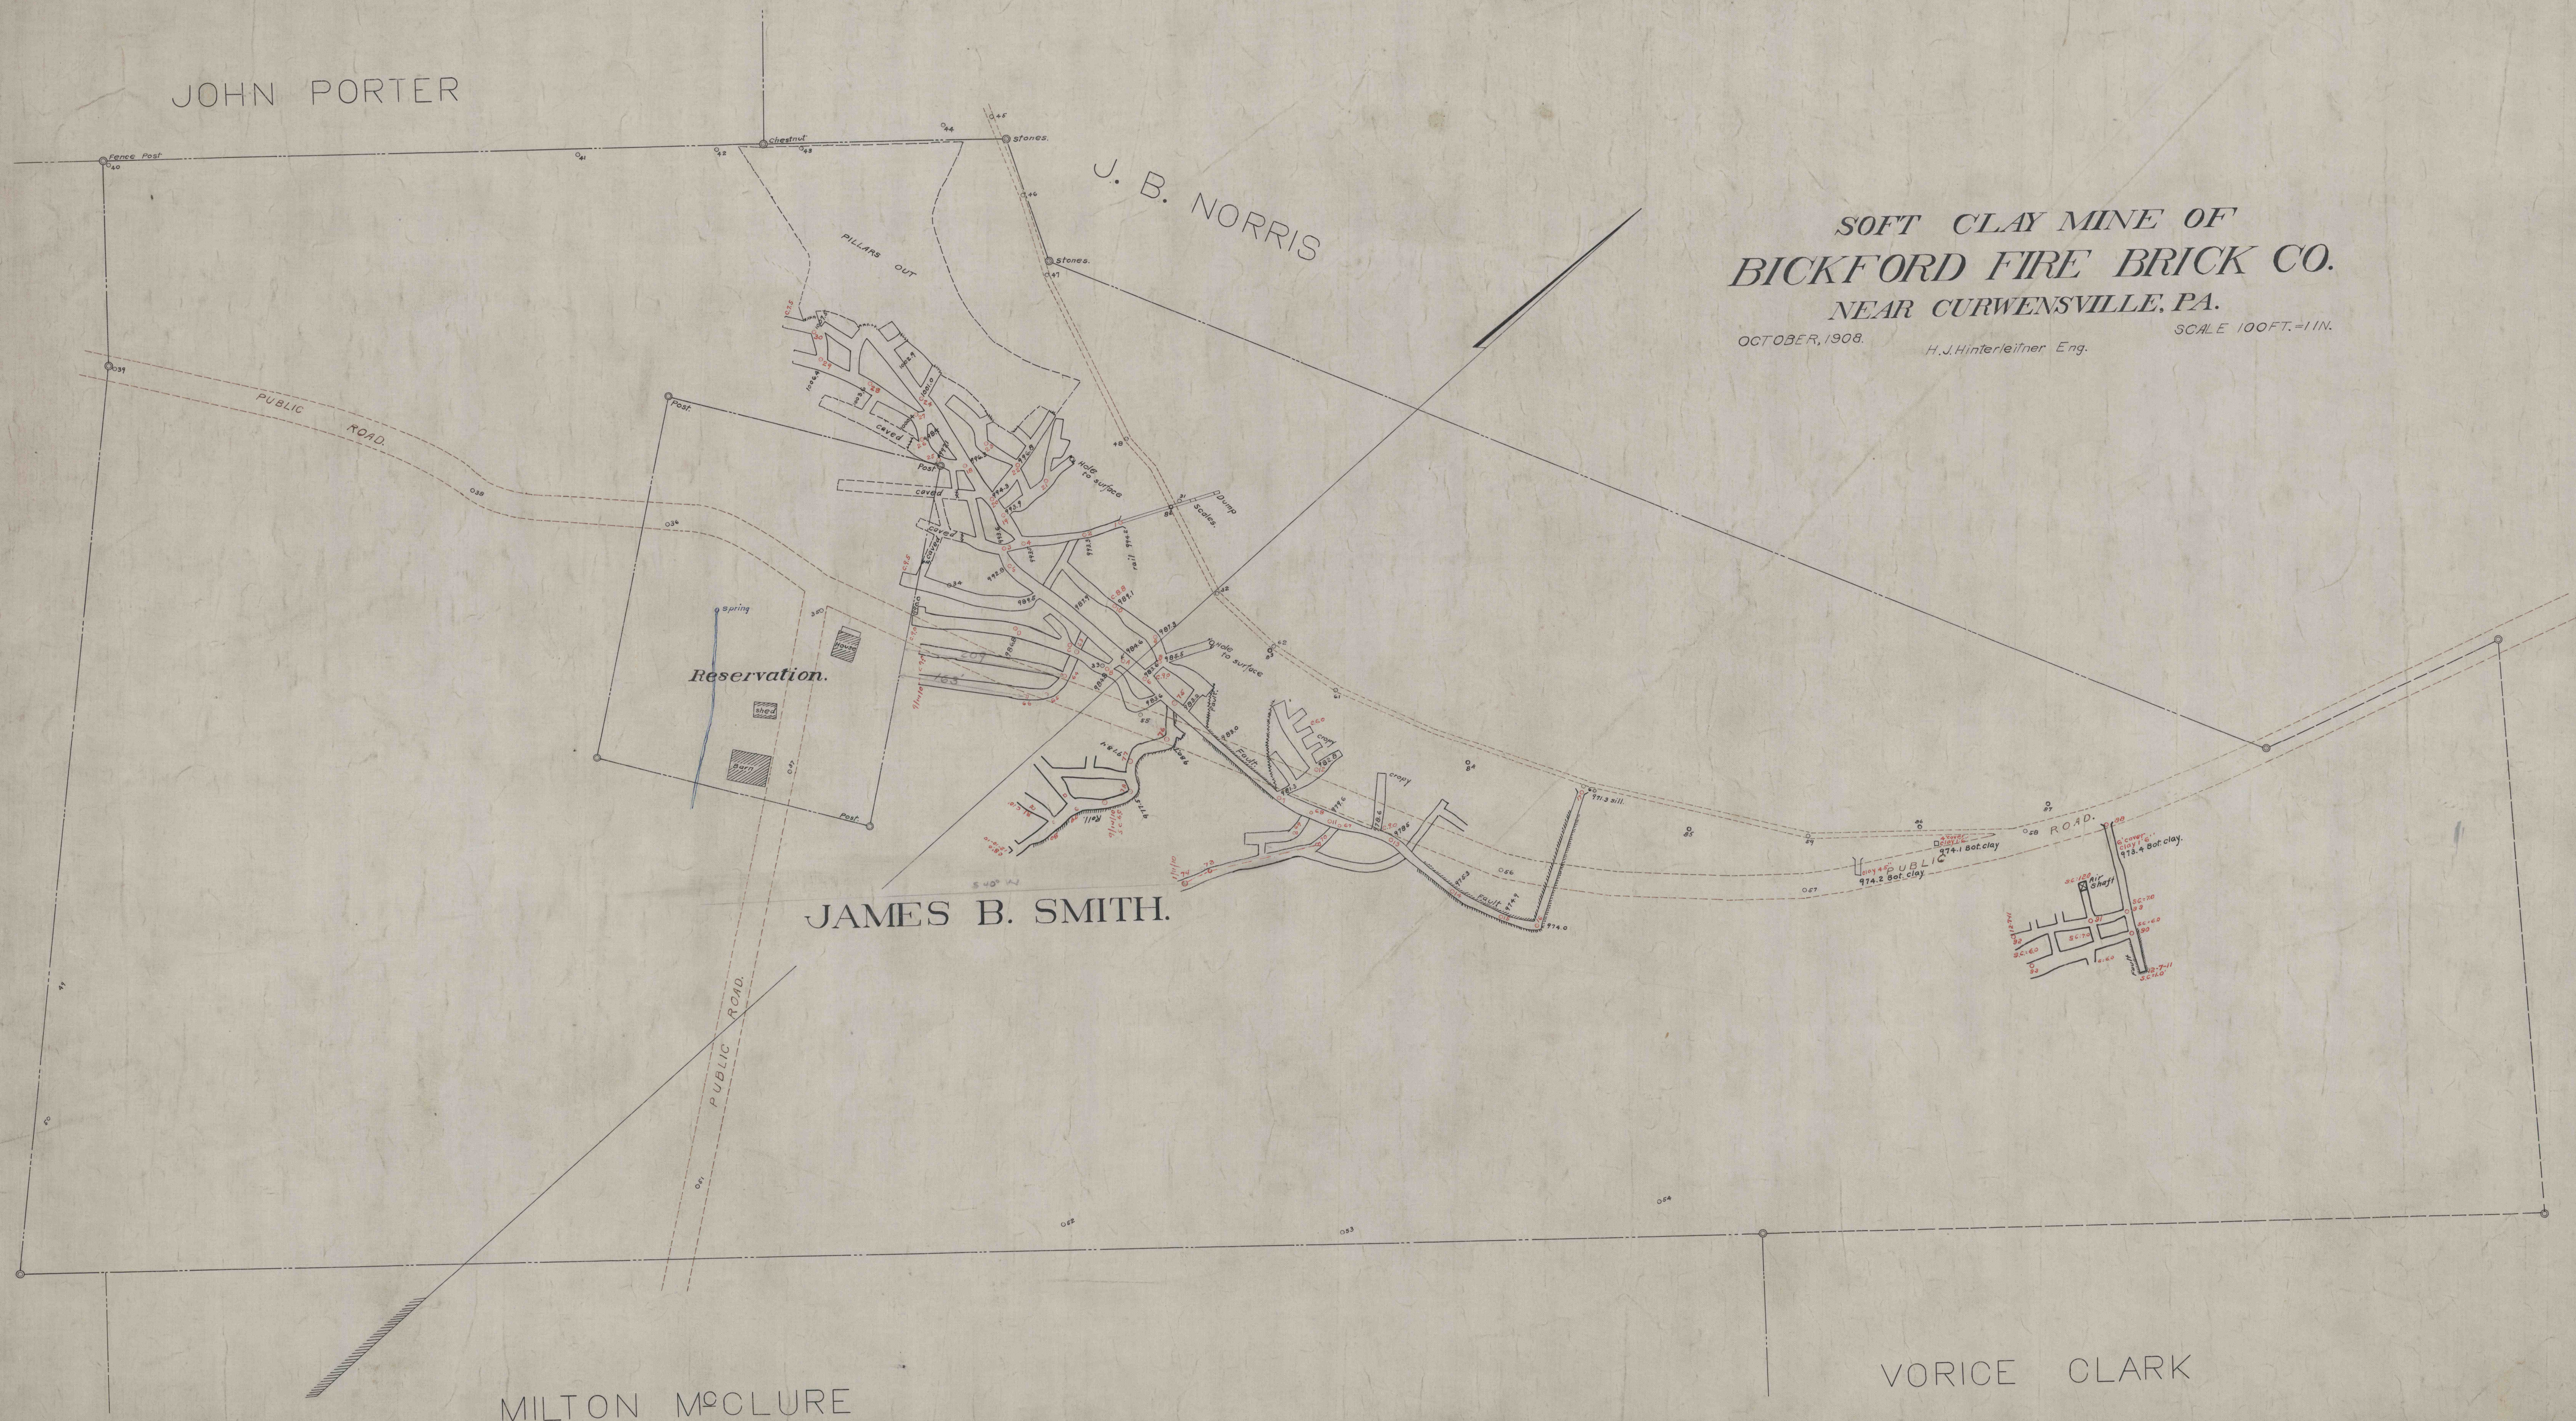

2001-N-
50-2-8