


SPENCER

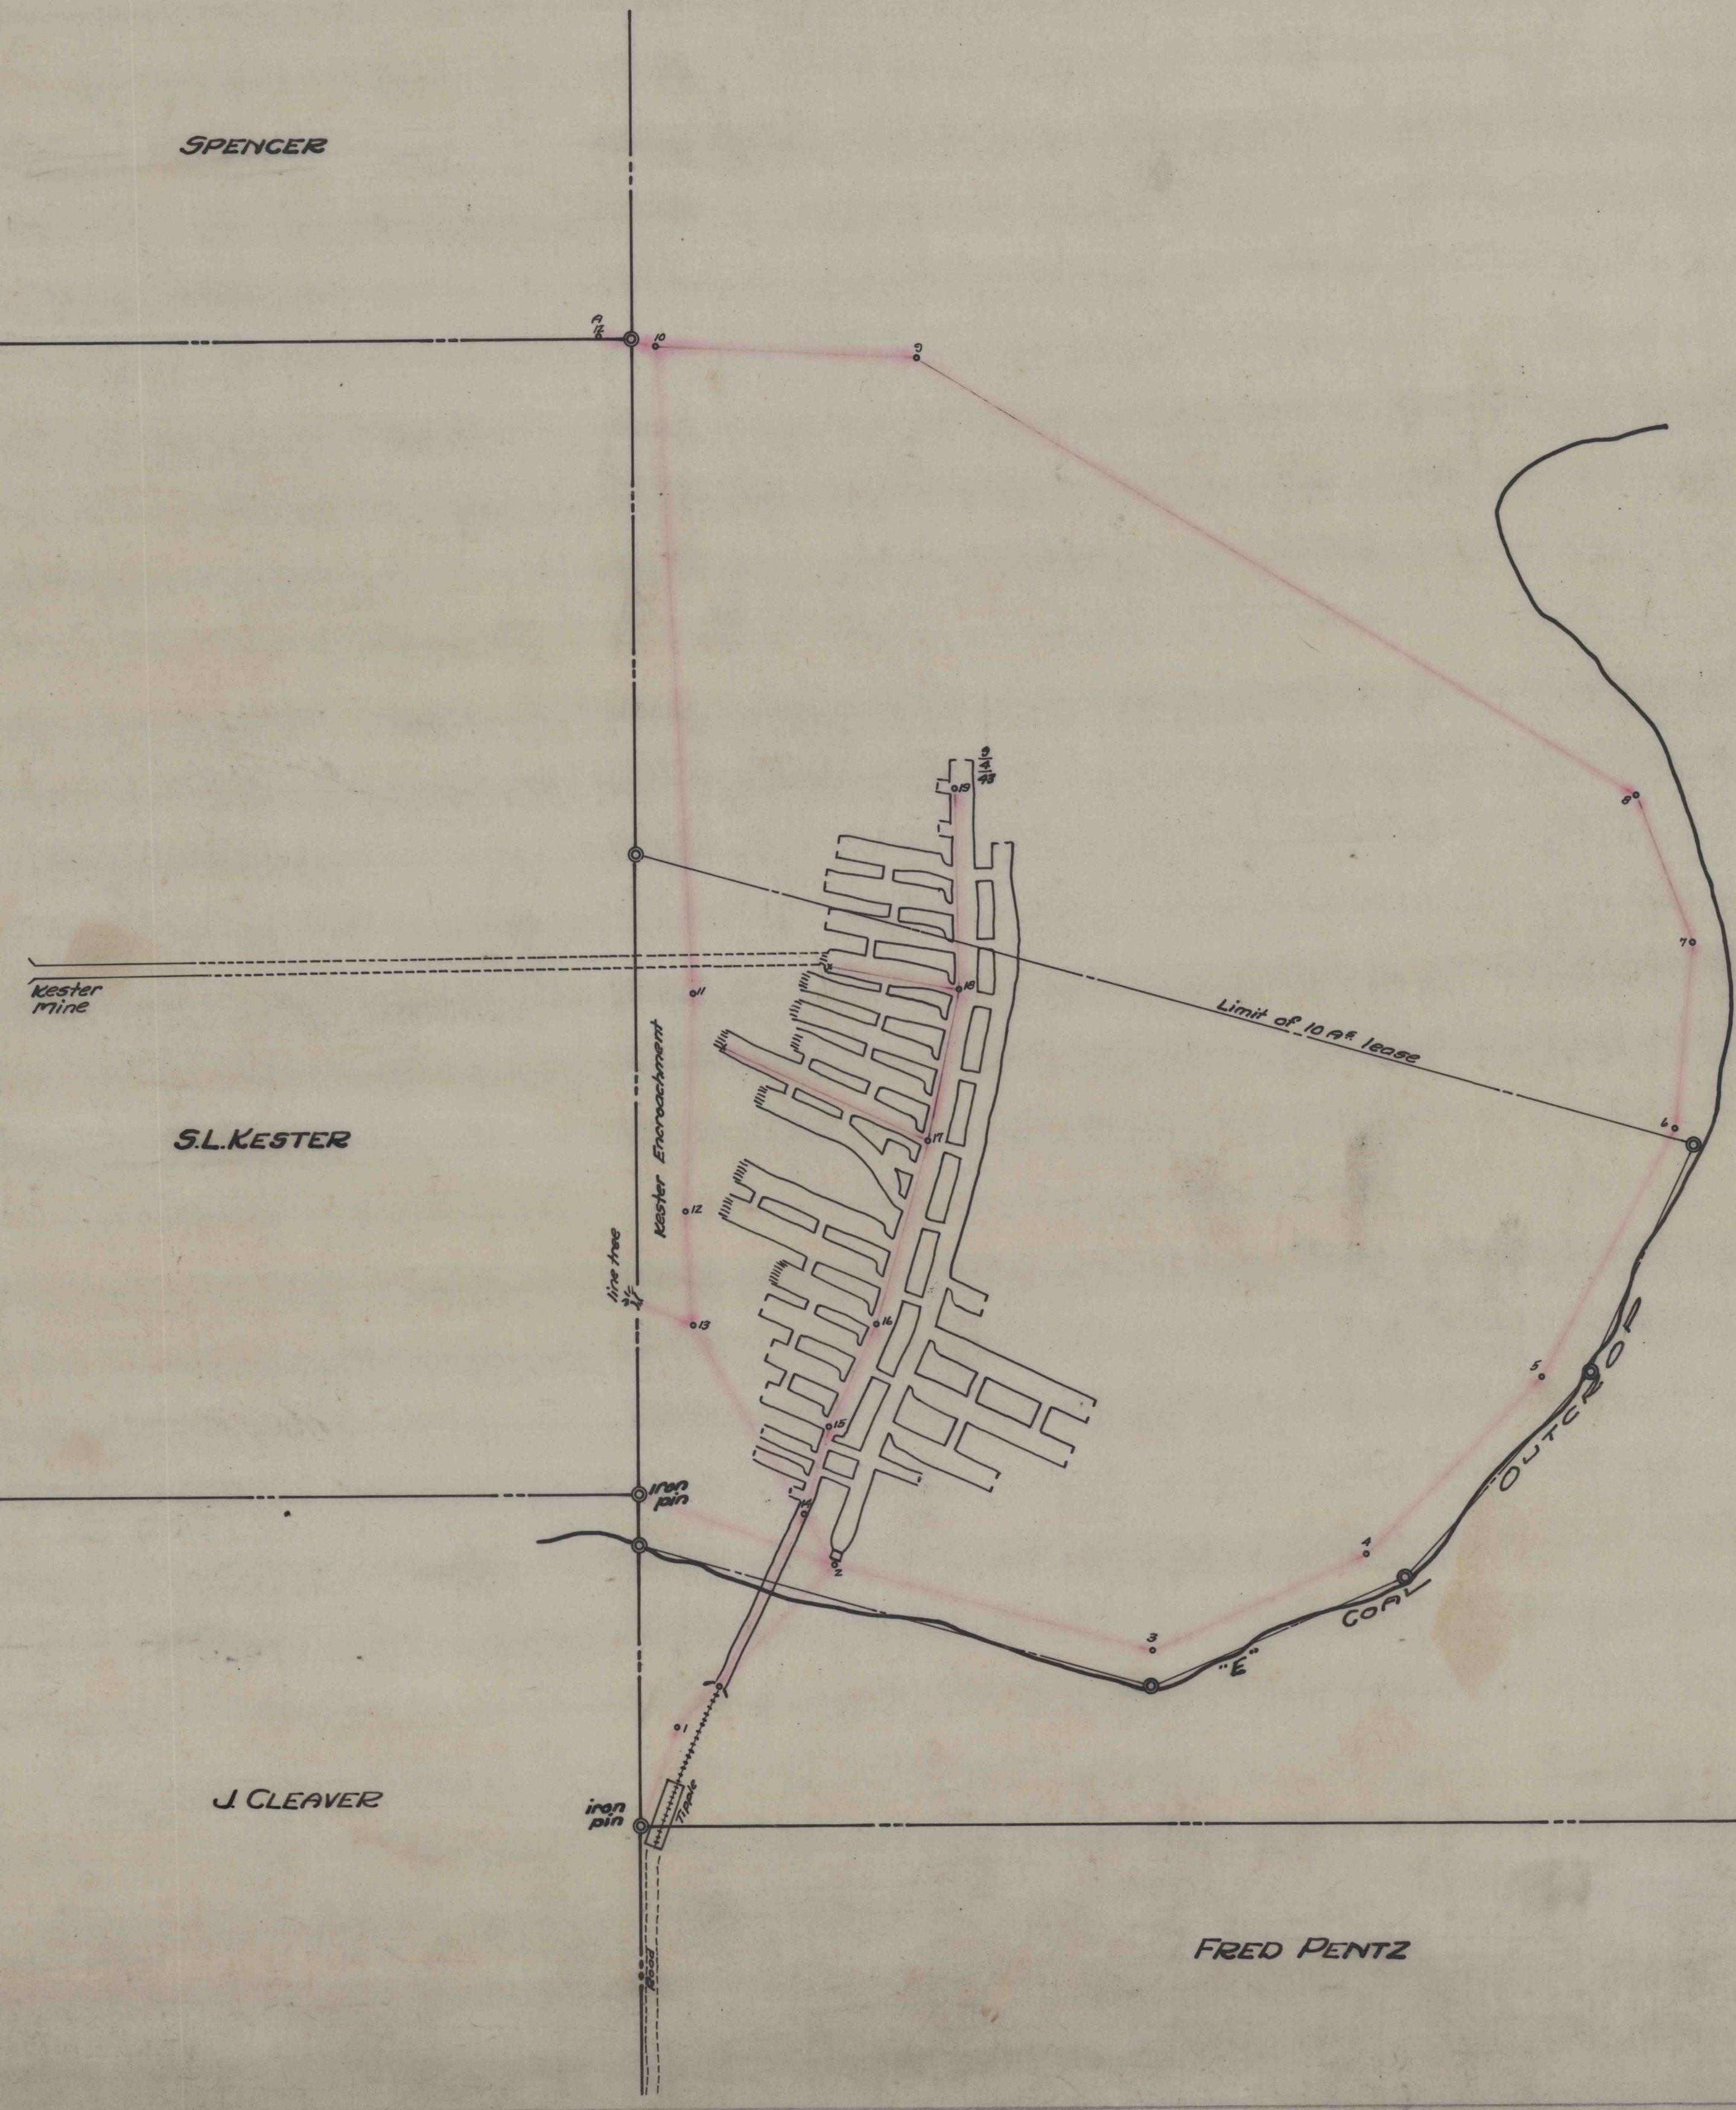

S.L. KESTER

J. CLEAVER

FRED PENTZ

G. & H. E. RIDDLE 10 ACRES TRACT & MINE
PART OF W. M. PENTZ TRACT
HEPBURNIA, PA.

Scale 1"=100 Ft
3-4-43
B.M. Dwyfman
#50-3-1052

Traversed
87110 book 1