

SCOTT ROWLES

4.35 Acres

Robt. Rowles
(Coal) 333/112
(Surf.)

Alex Collins
7A. Coal
353/447


2.89 Acres
Robt. Rowles
(Coal) 365/233
(Surf.) 333/112

SURVEY INTO PEALE #3
FROM
ROWLES #4 MINE

SURVEY DATE: 11-24-48

SCALE: 1" = 100'

J.R.H. Jr
50-3-1160

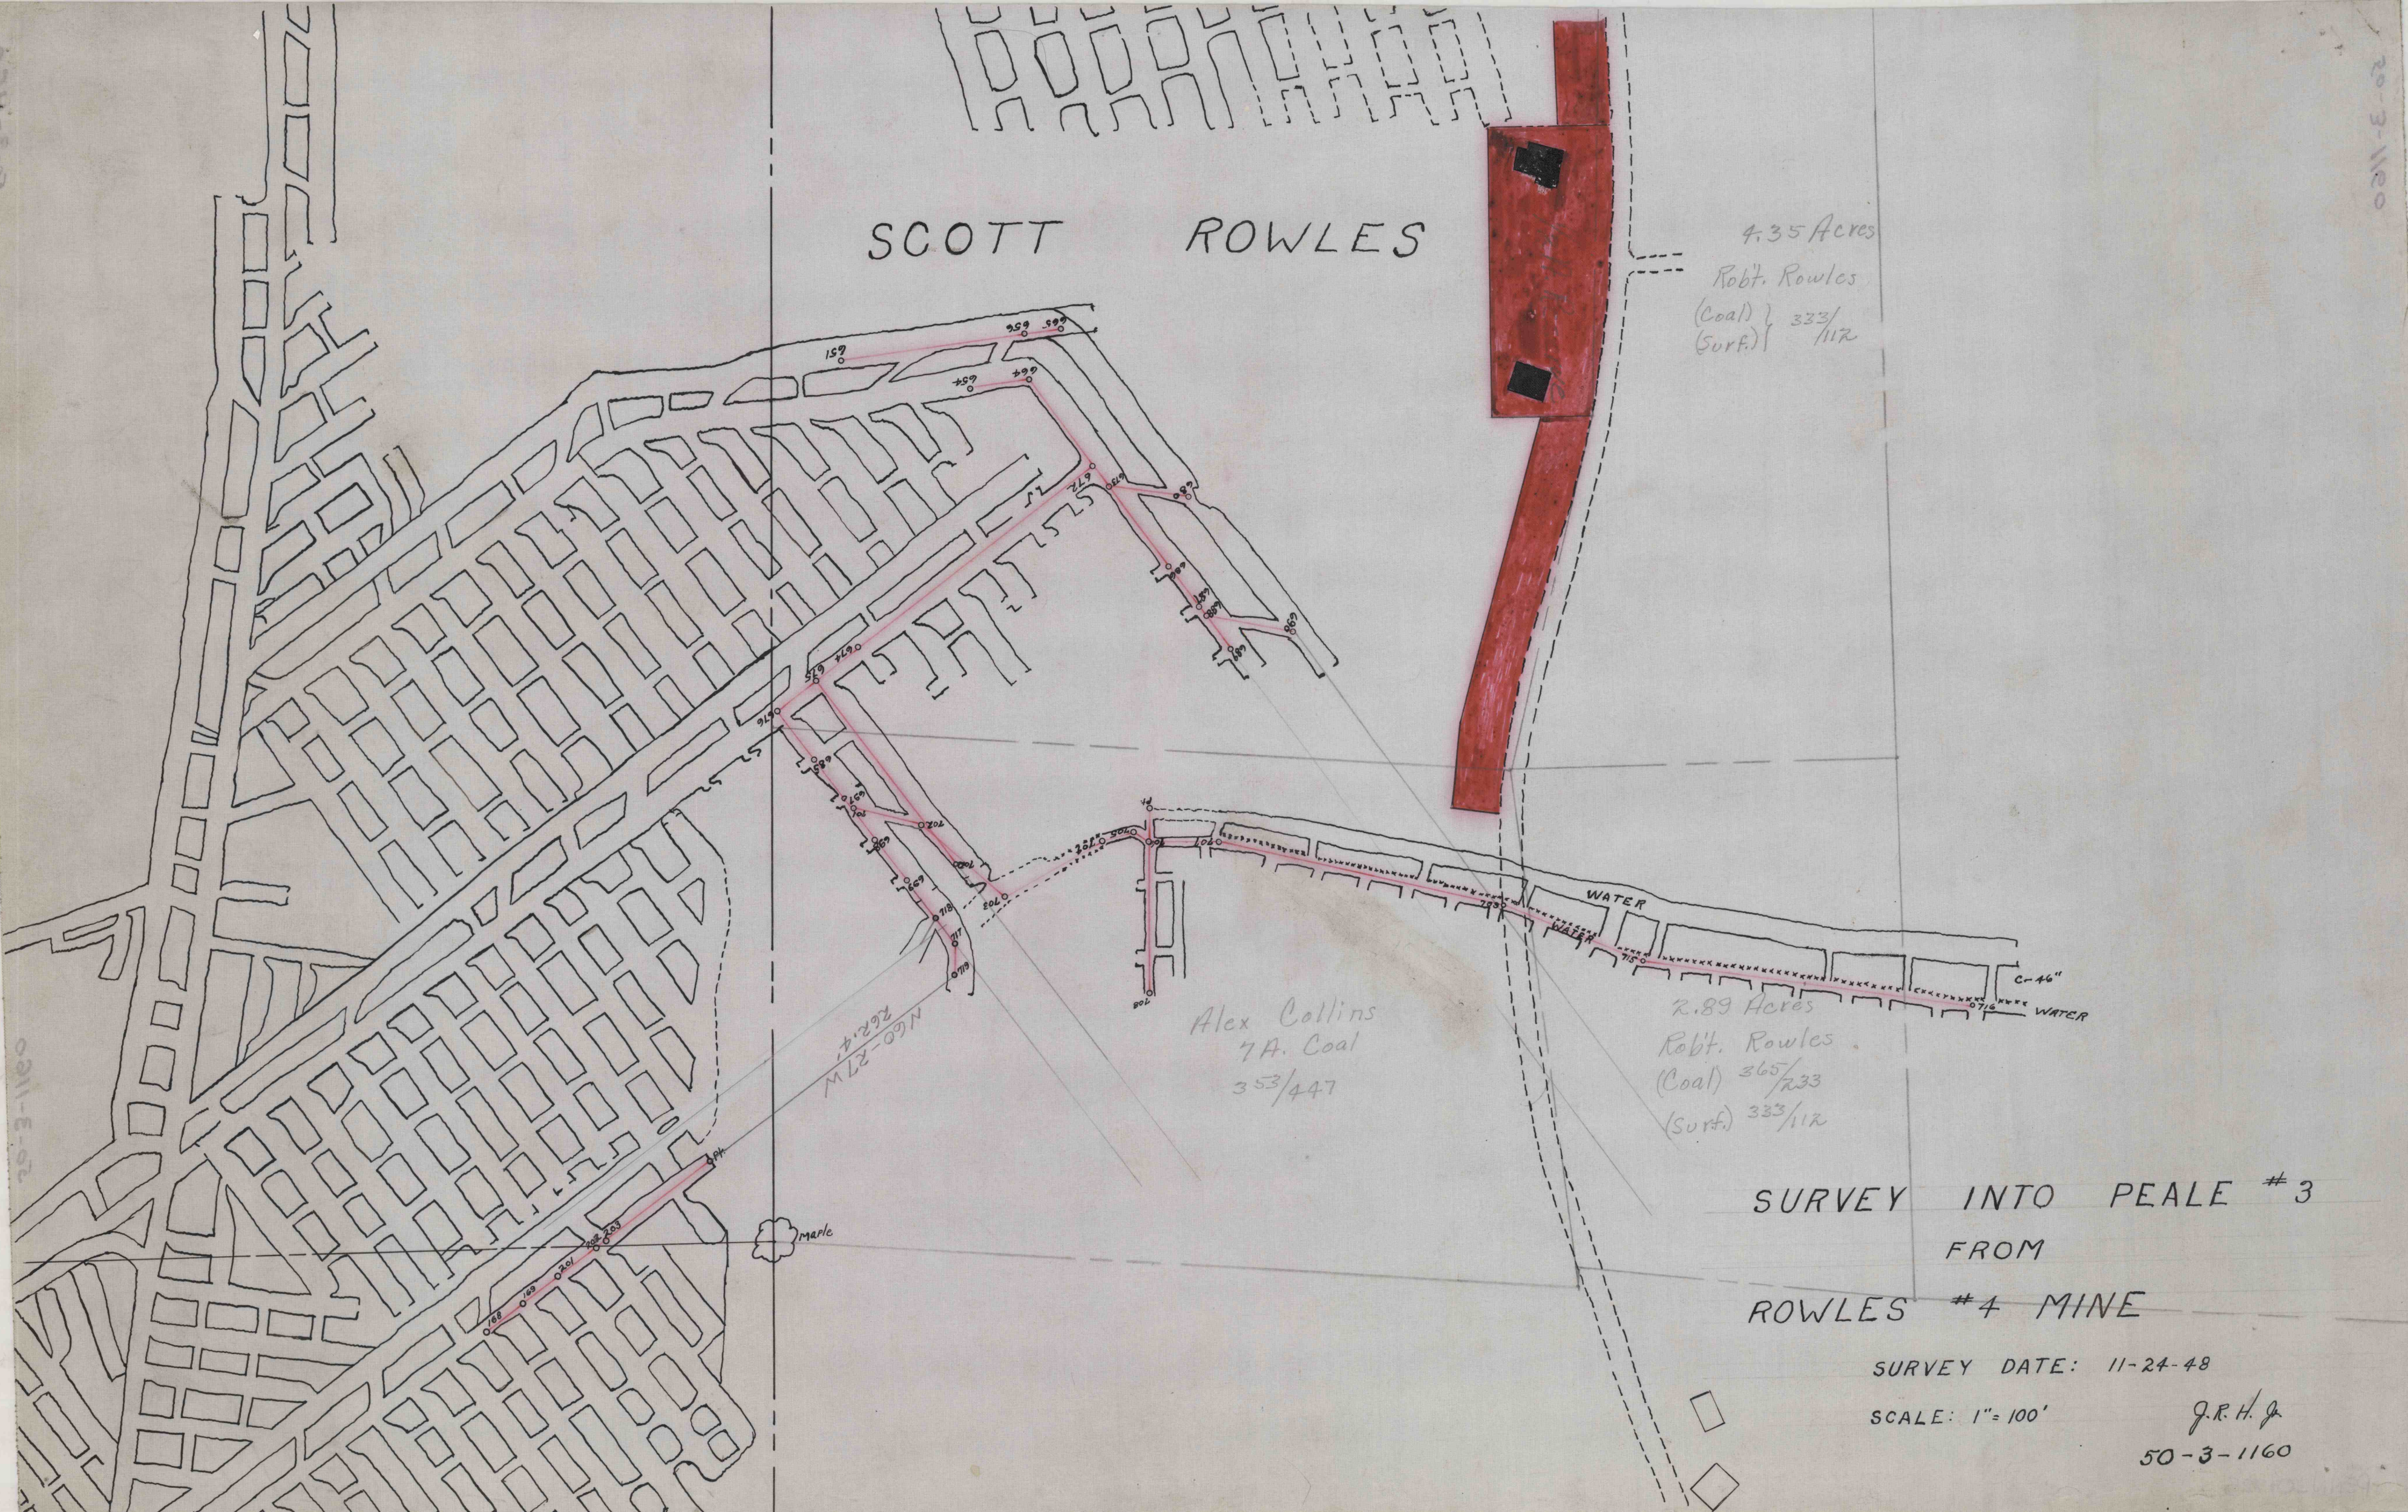

50-3-1160

50-3-1160

50-3-1160

50-3-1160