


G. W. WISE.

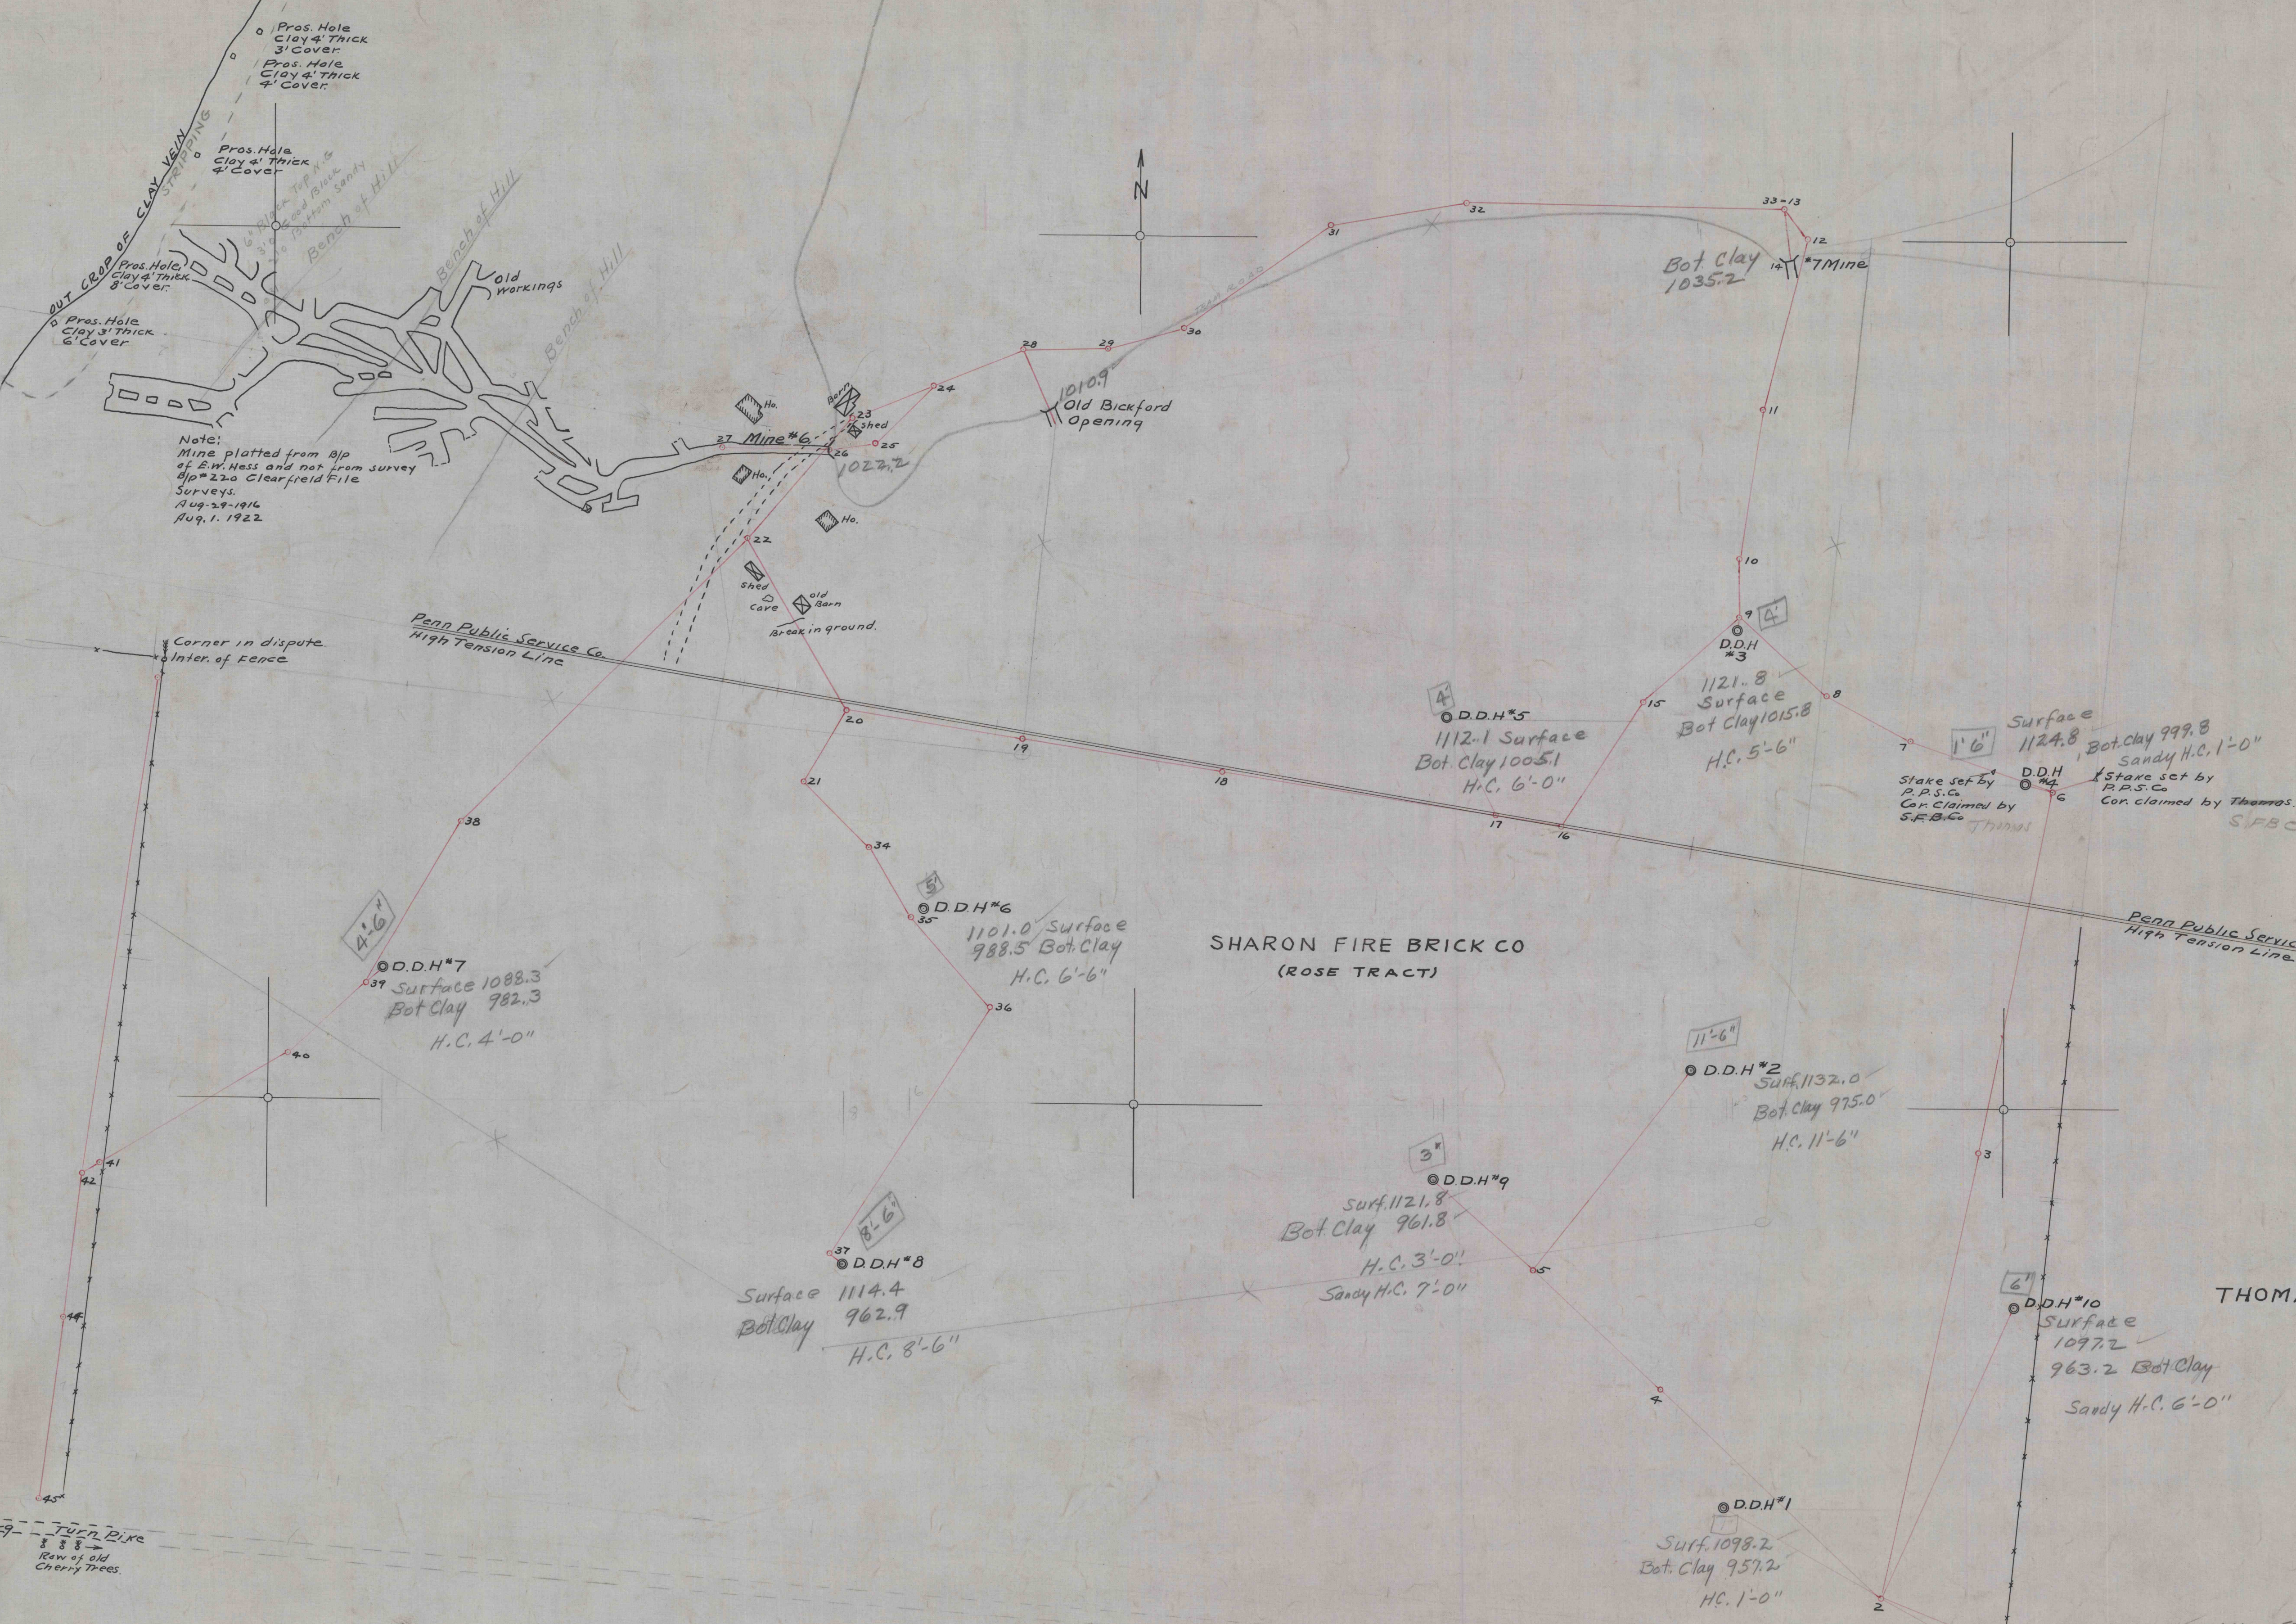

Note:
 Mine plotted from B.P.
 of E.W. Hess and not from survey
 B.P. #220 Clearfield File
 Surveys
 Aug. 29-1916
 Aug. 1, 1922

GILBERT THOMAS
 (BUCK TRACT)

SHARON FIRE BRICK CO
 (ROSE TRACT)

THOMAS HEIRS

CALVIN BILGER EST.

CRESCENT REFRACTORIES CO.
 CURWENSVILLE, CLEARFIELD COUNTY, PA.
 ENGINEERING DEPARTMENT

MAP SHOWING LOCATION OF
 DRILL HOLES SHARON F.B. CO
 (ROSE TRACT)

DRAWN C.F.	SCALE 1"=100'	50-3-130
CHECKED	DATE Aug. 21-22	1072-I
REFERENCE	ORDER	

+777.4 For 1363