

ZACHARIAH McNAUL HEIRS


ISAAC KESTER EST.

ABRINO ENOS

RACHAEL GOSS

ARNOLD EST.

ELIM PASSMORE, EST.

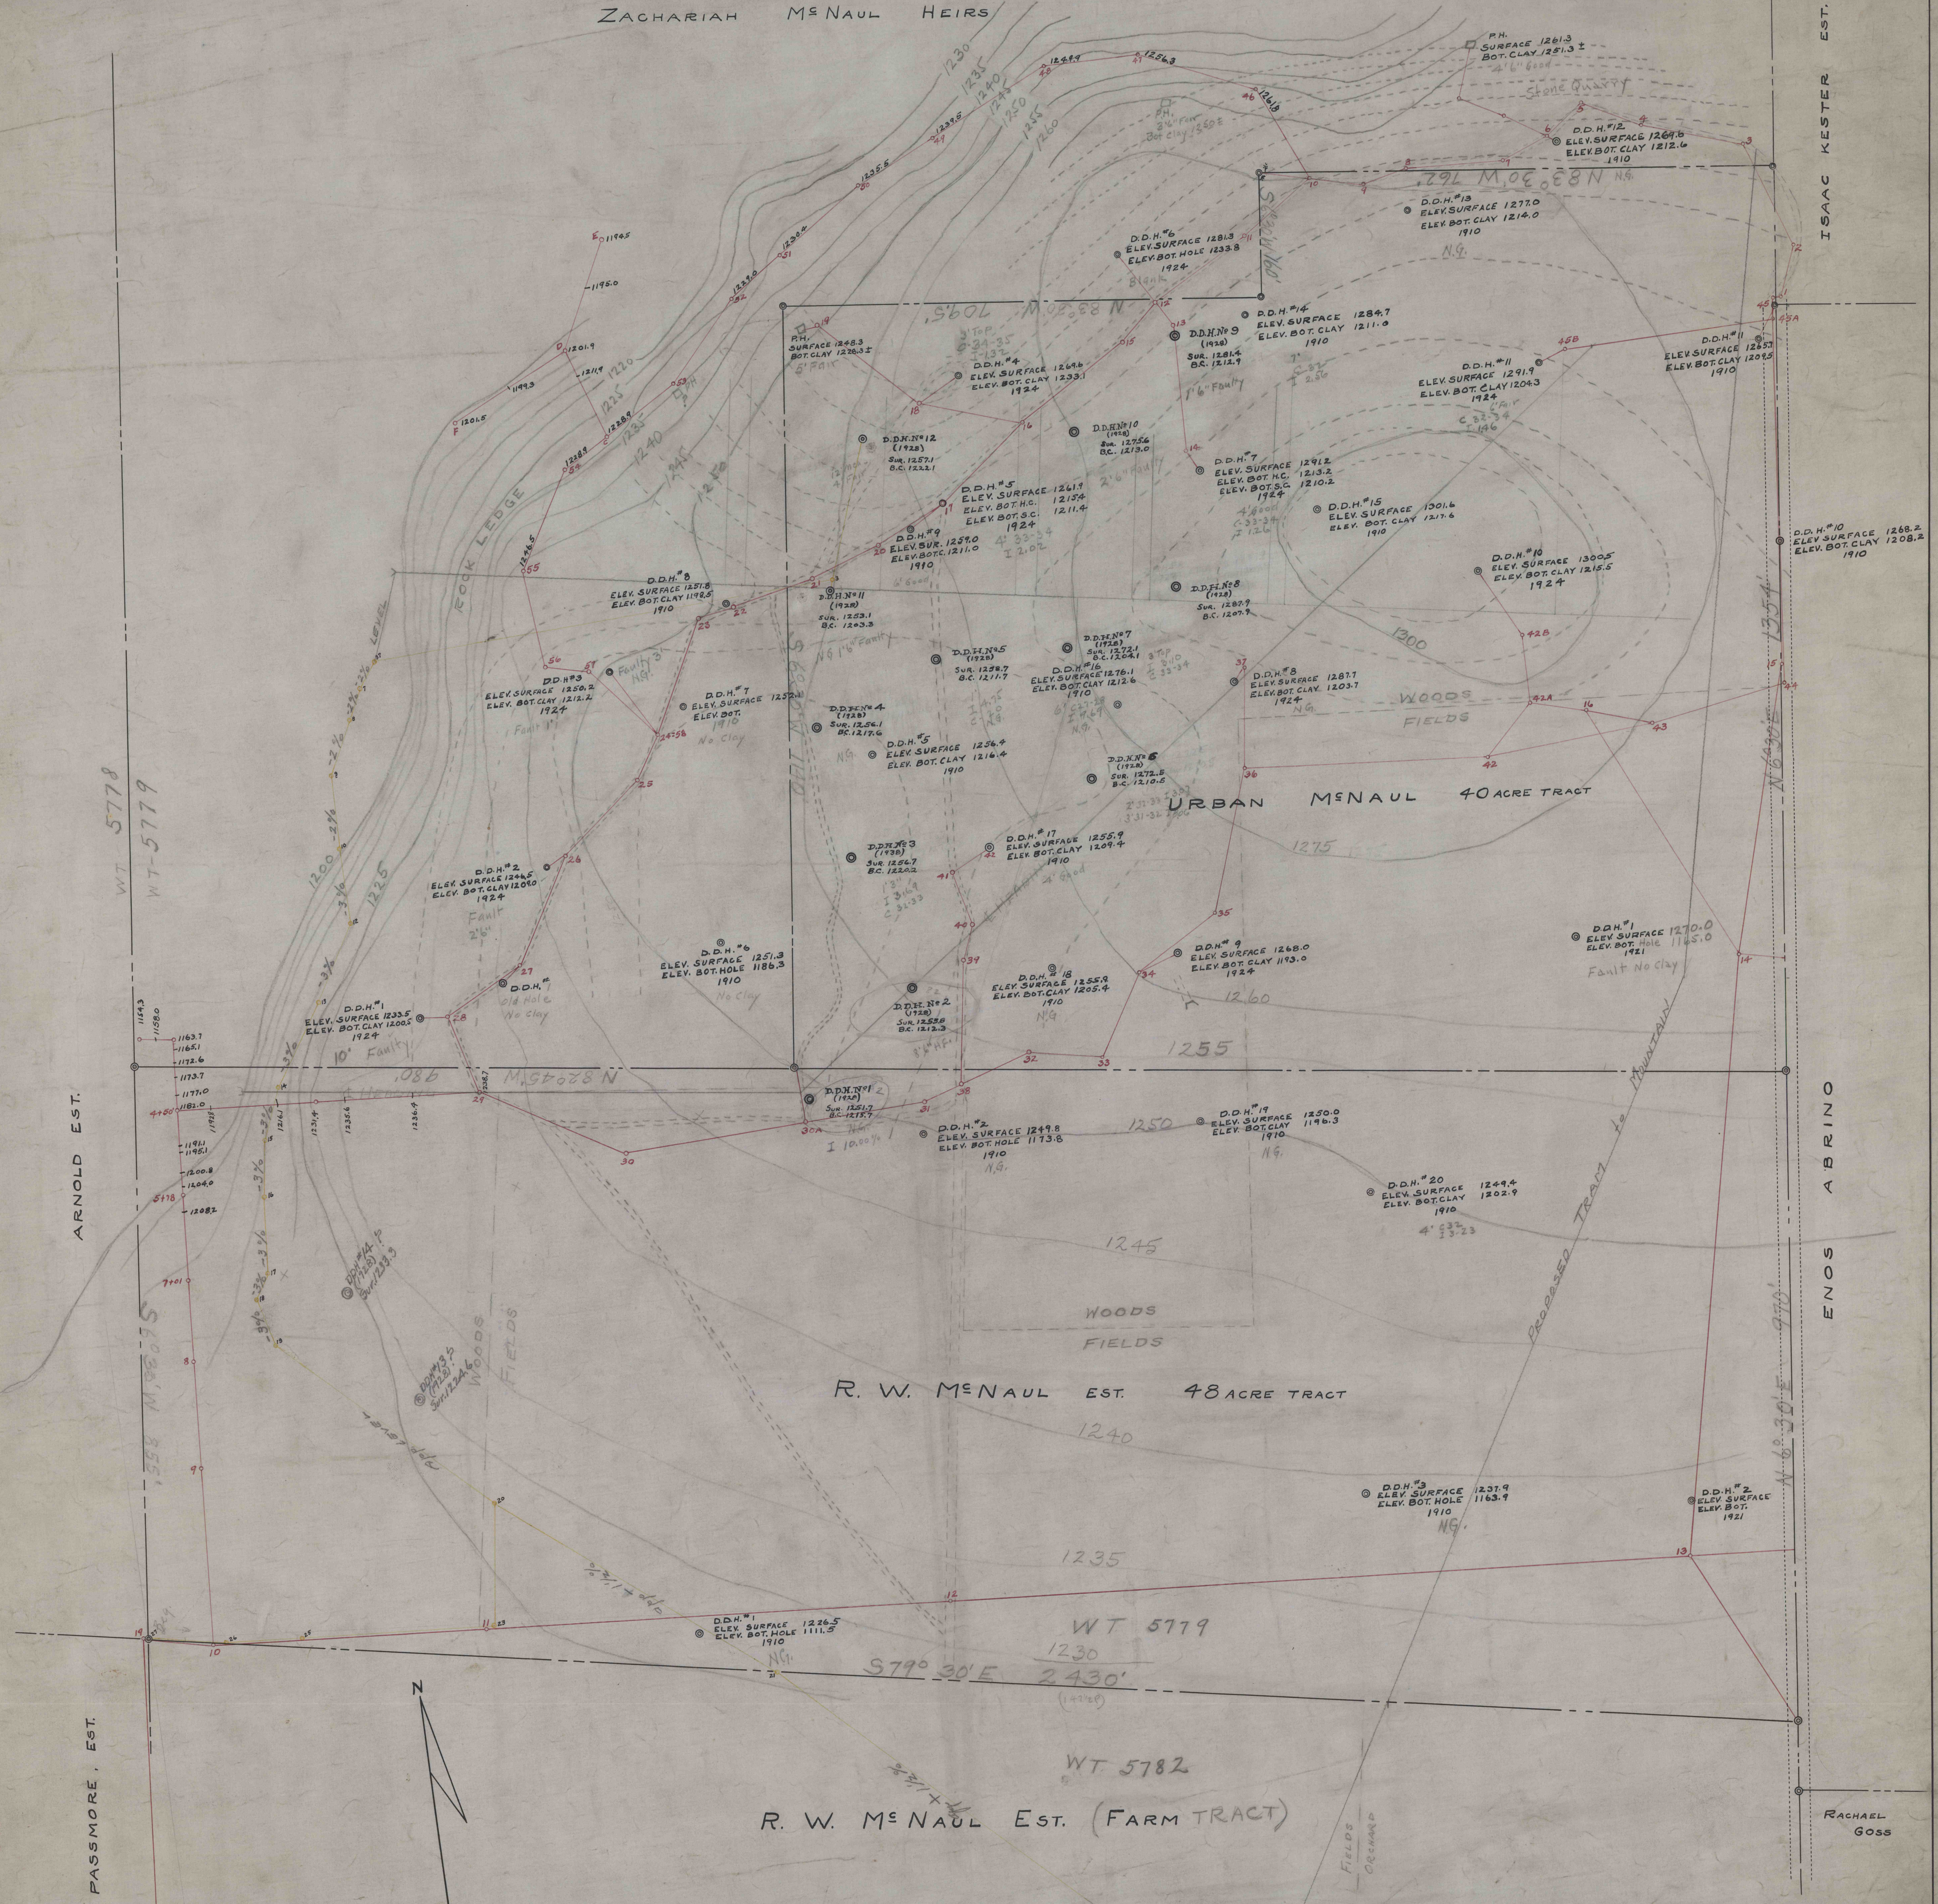

CRESCENT REFRACTORIES CO.
 CURWENSVILLE, CLEARFIELD COUNTY, PA.
 ENGINEERING DEPARTMENT

MAP SHOWING THE LOCATION OF
 DIAMOND DRILL HOLES ON THE
 LAND OF McNAUL HEIRS.

DRAWN BY: [Signature] SCALE 1"=100' 1085-1
 CHECKED: [Signature] DATE Jan. 25, 1928
 REFERENCE: [Signature] ORDER 503-156