


D

5041

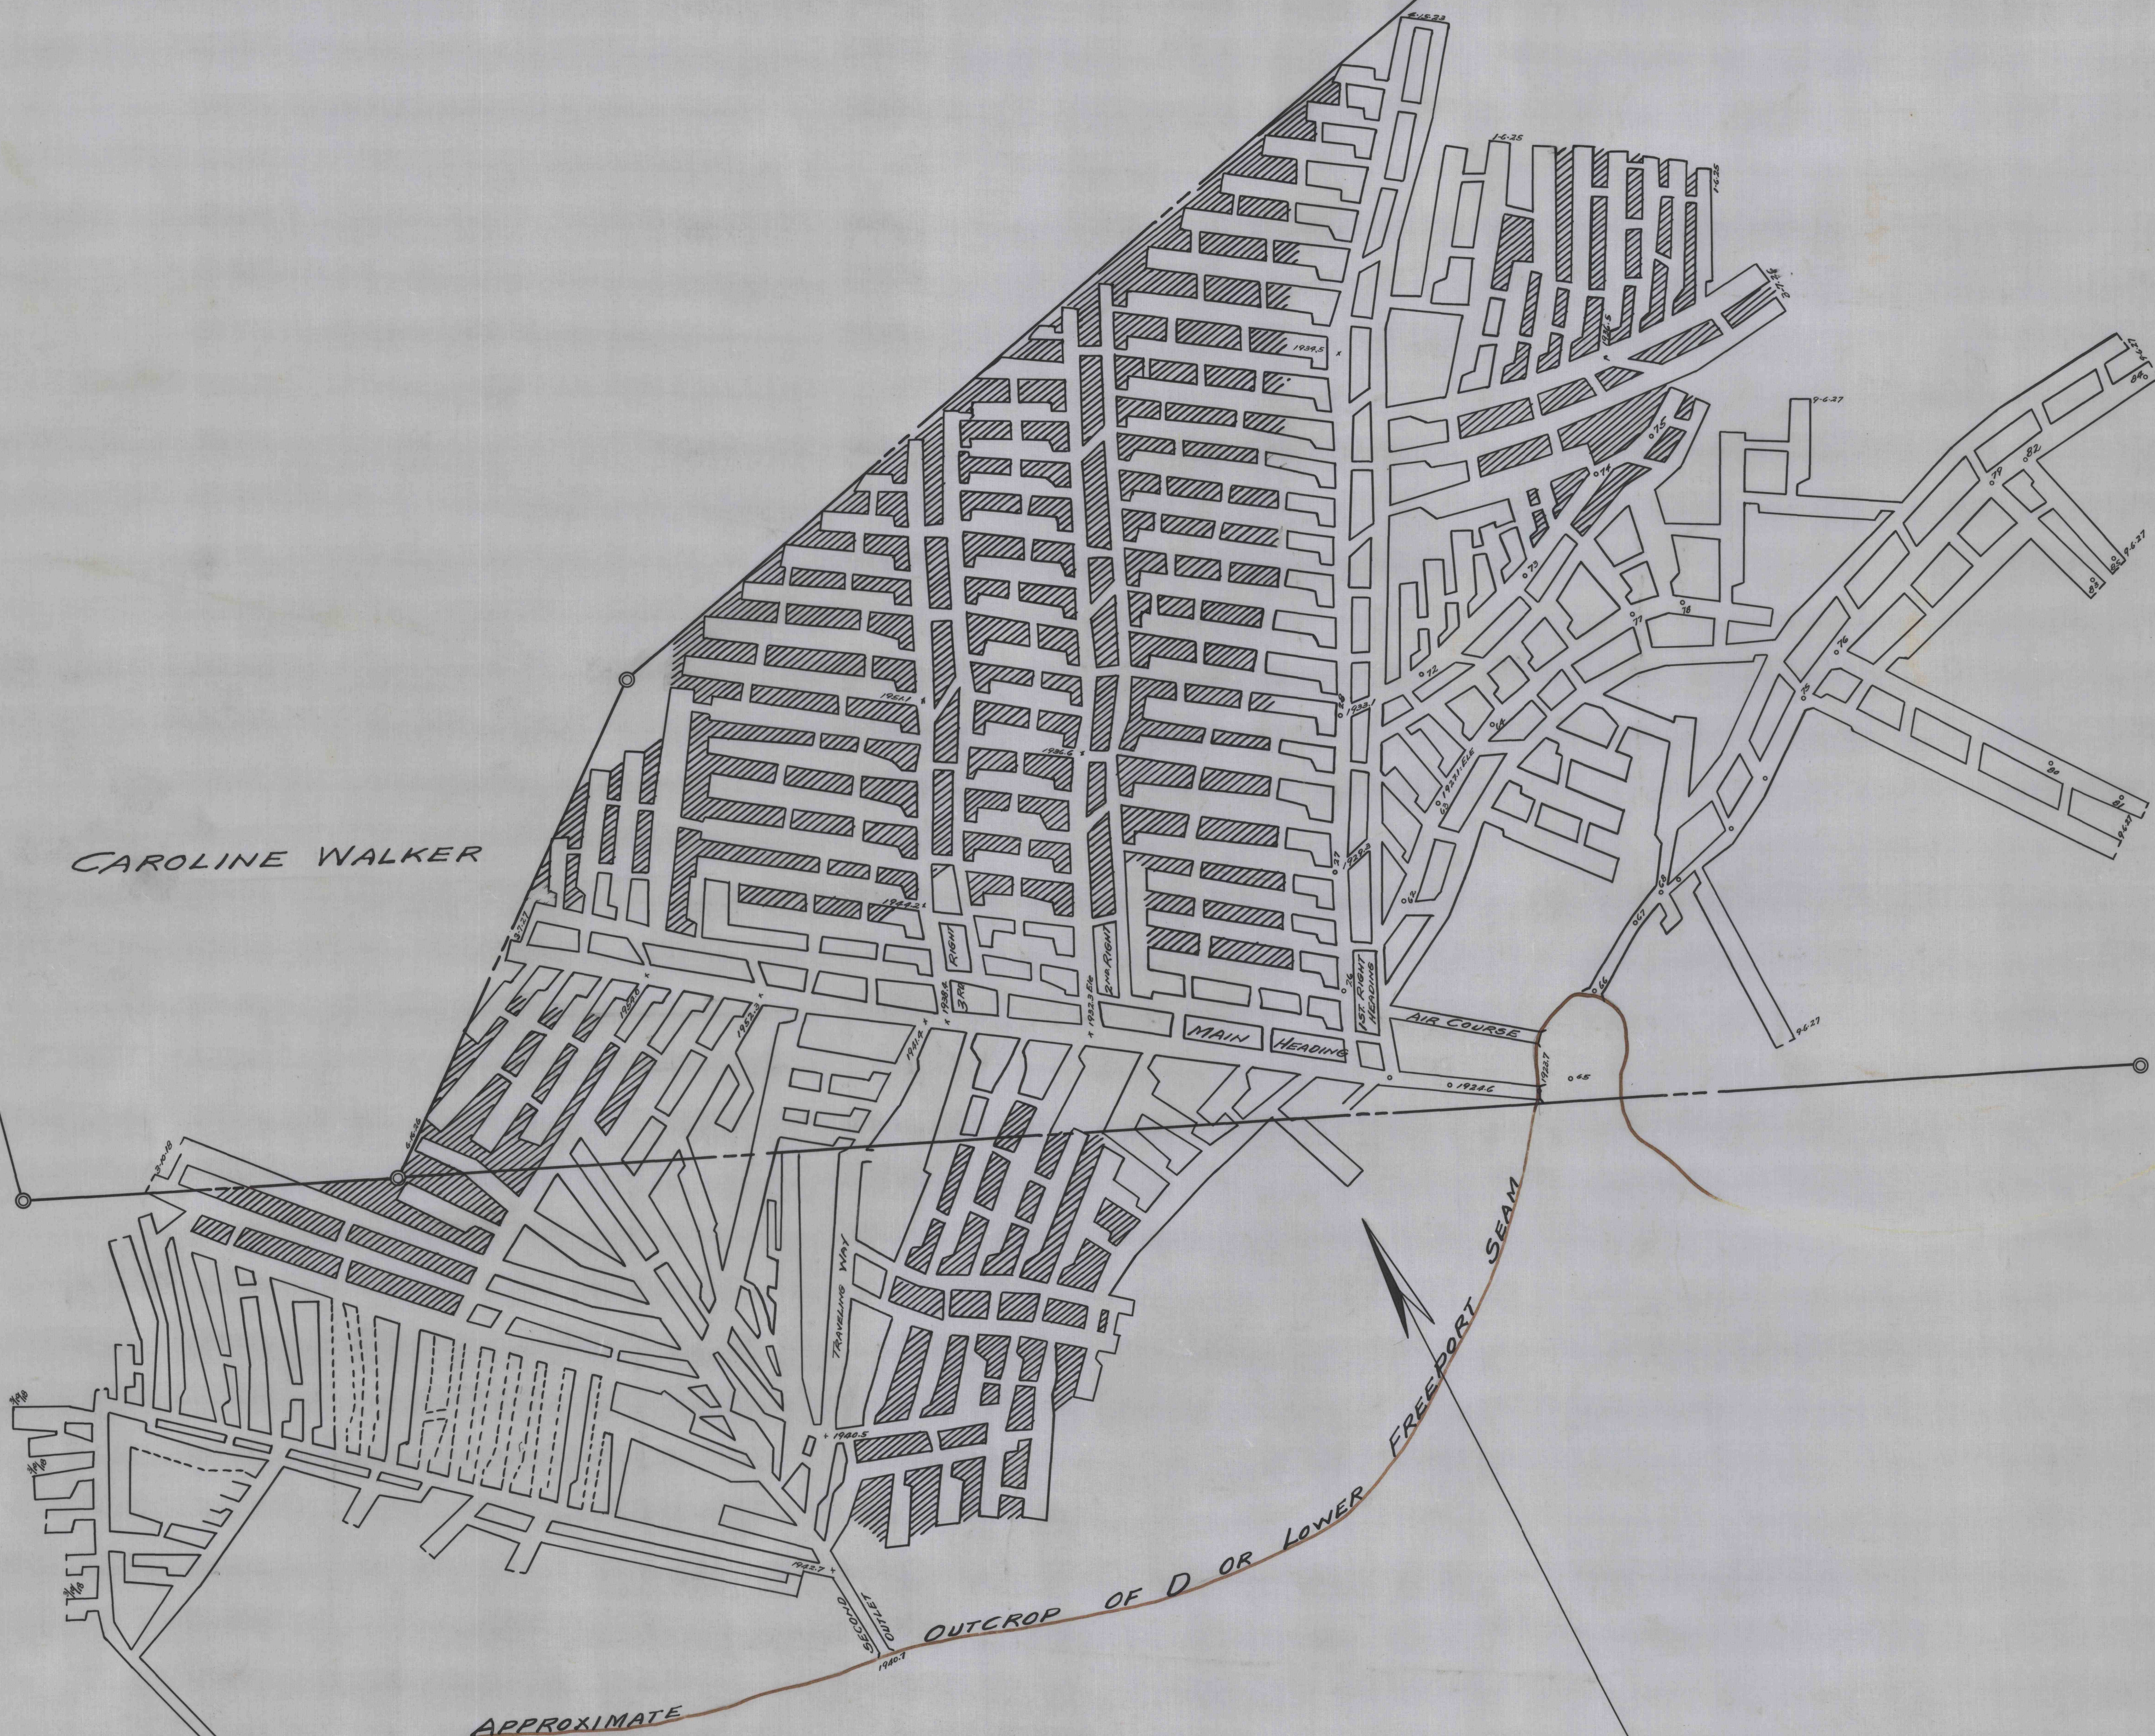

1402