


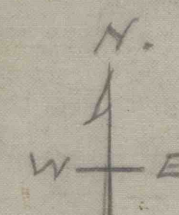

A. CALDWELL




FRUIT HILL CHURCH

NEEF CEMETERY

MAGGIE BLOOM

SMITH McNEEL

A. CALDWELL

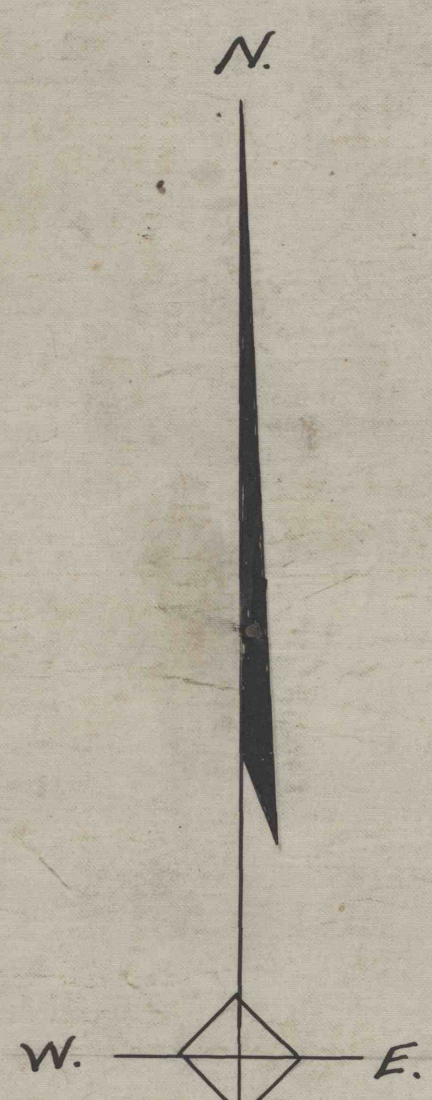

D

CARNWATH COAL CO.

MAP OF NO.-2-MINE

JORDAN TWP. CLEARFIELD CO. PA.

SCALE 1"=100'

CLEARFIELD PA.

JULY-5-1913

OFFICE OF E. W. HESS
ENGINEER

1293A

- DATE OF SURVEYS
- JULY 1-2 1913
 - DECEMBER 15-17 1913
 - JUNE 10-11 1914
 - JANUARY 4-6 1915
 - DECEMBER 1-4 1915
 - AUGUST 14-16 1916
 - MARCH 21 1917
 - FEBRUARY 10 1918
 - DECEMBER 5 1918
 - JANUARY 16-17 1920

5097