


8115

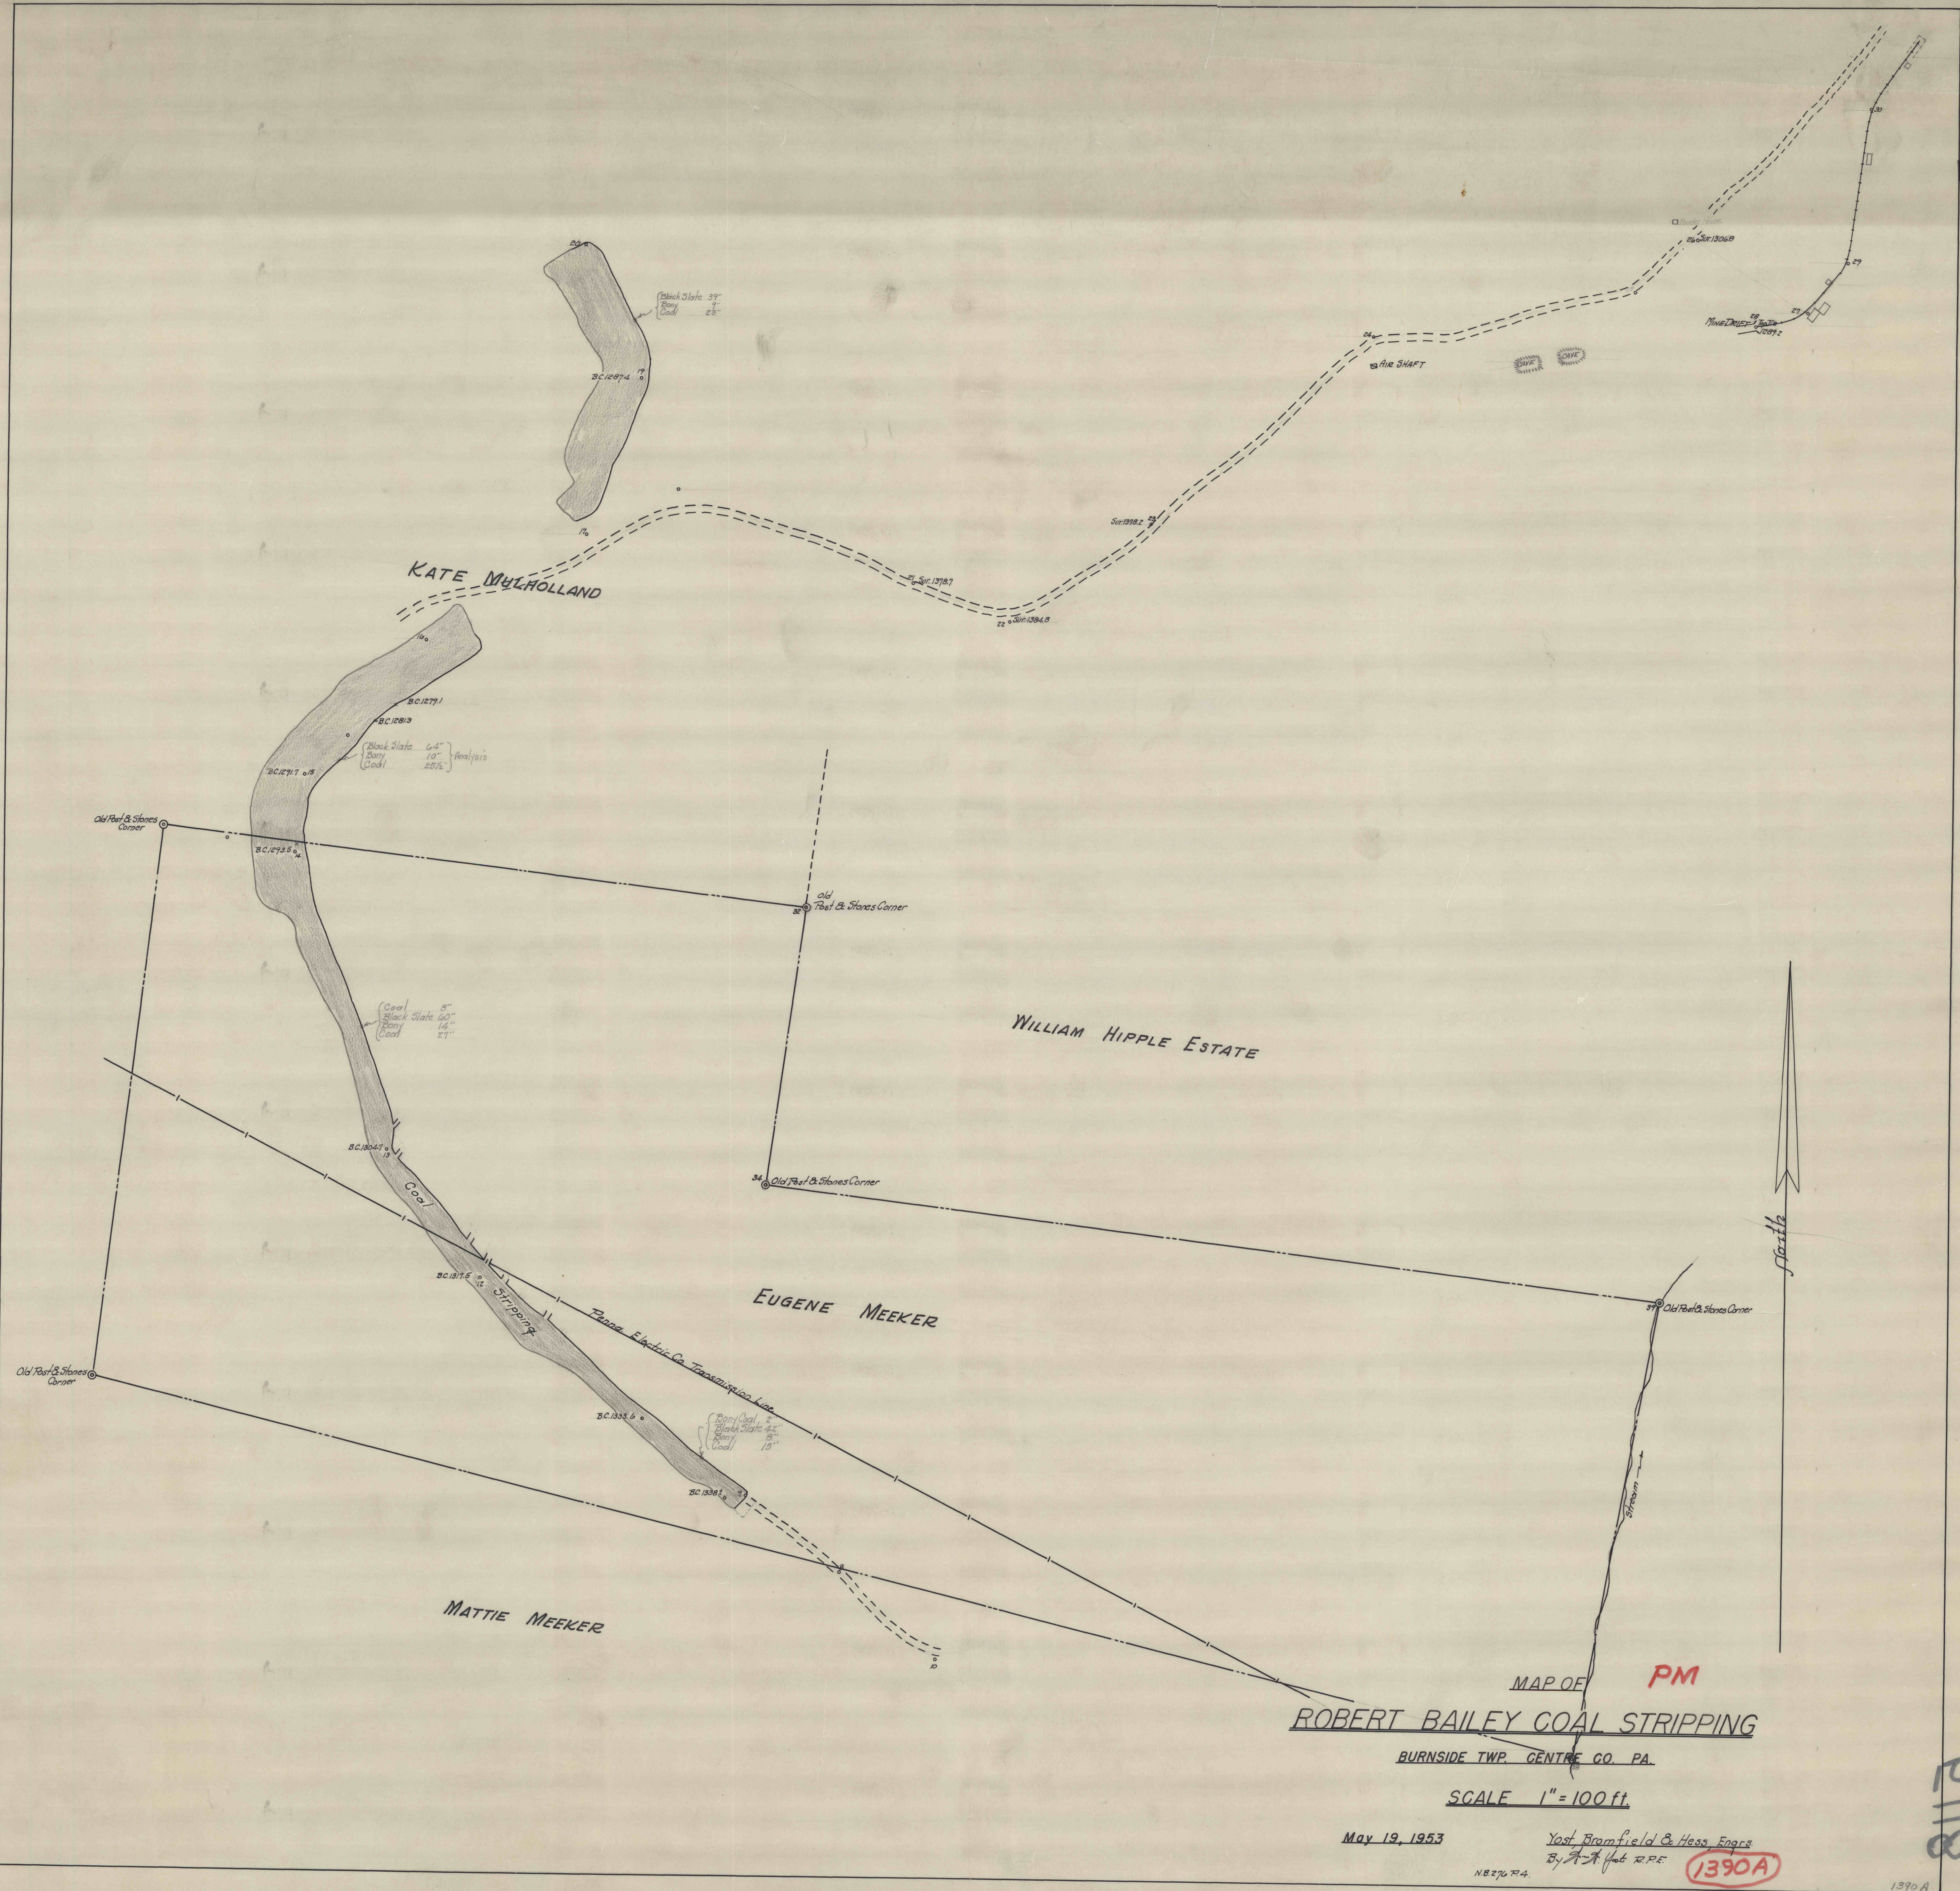

MAP OF **PM**
ROBERT BAILEY COAL STRIPPING
 BURNSIDE TWP. CENTRE CO. PA.
 SCALE 1" = 100 ft.

May 19, 1953

Yost, Bramfield & Hess, Engineers
 By *[Signature]* R.R.E.

1390A

1390A

2118