


5119

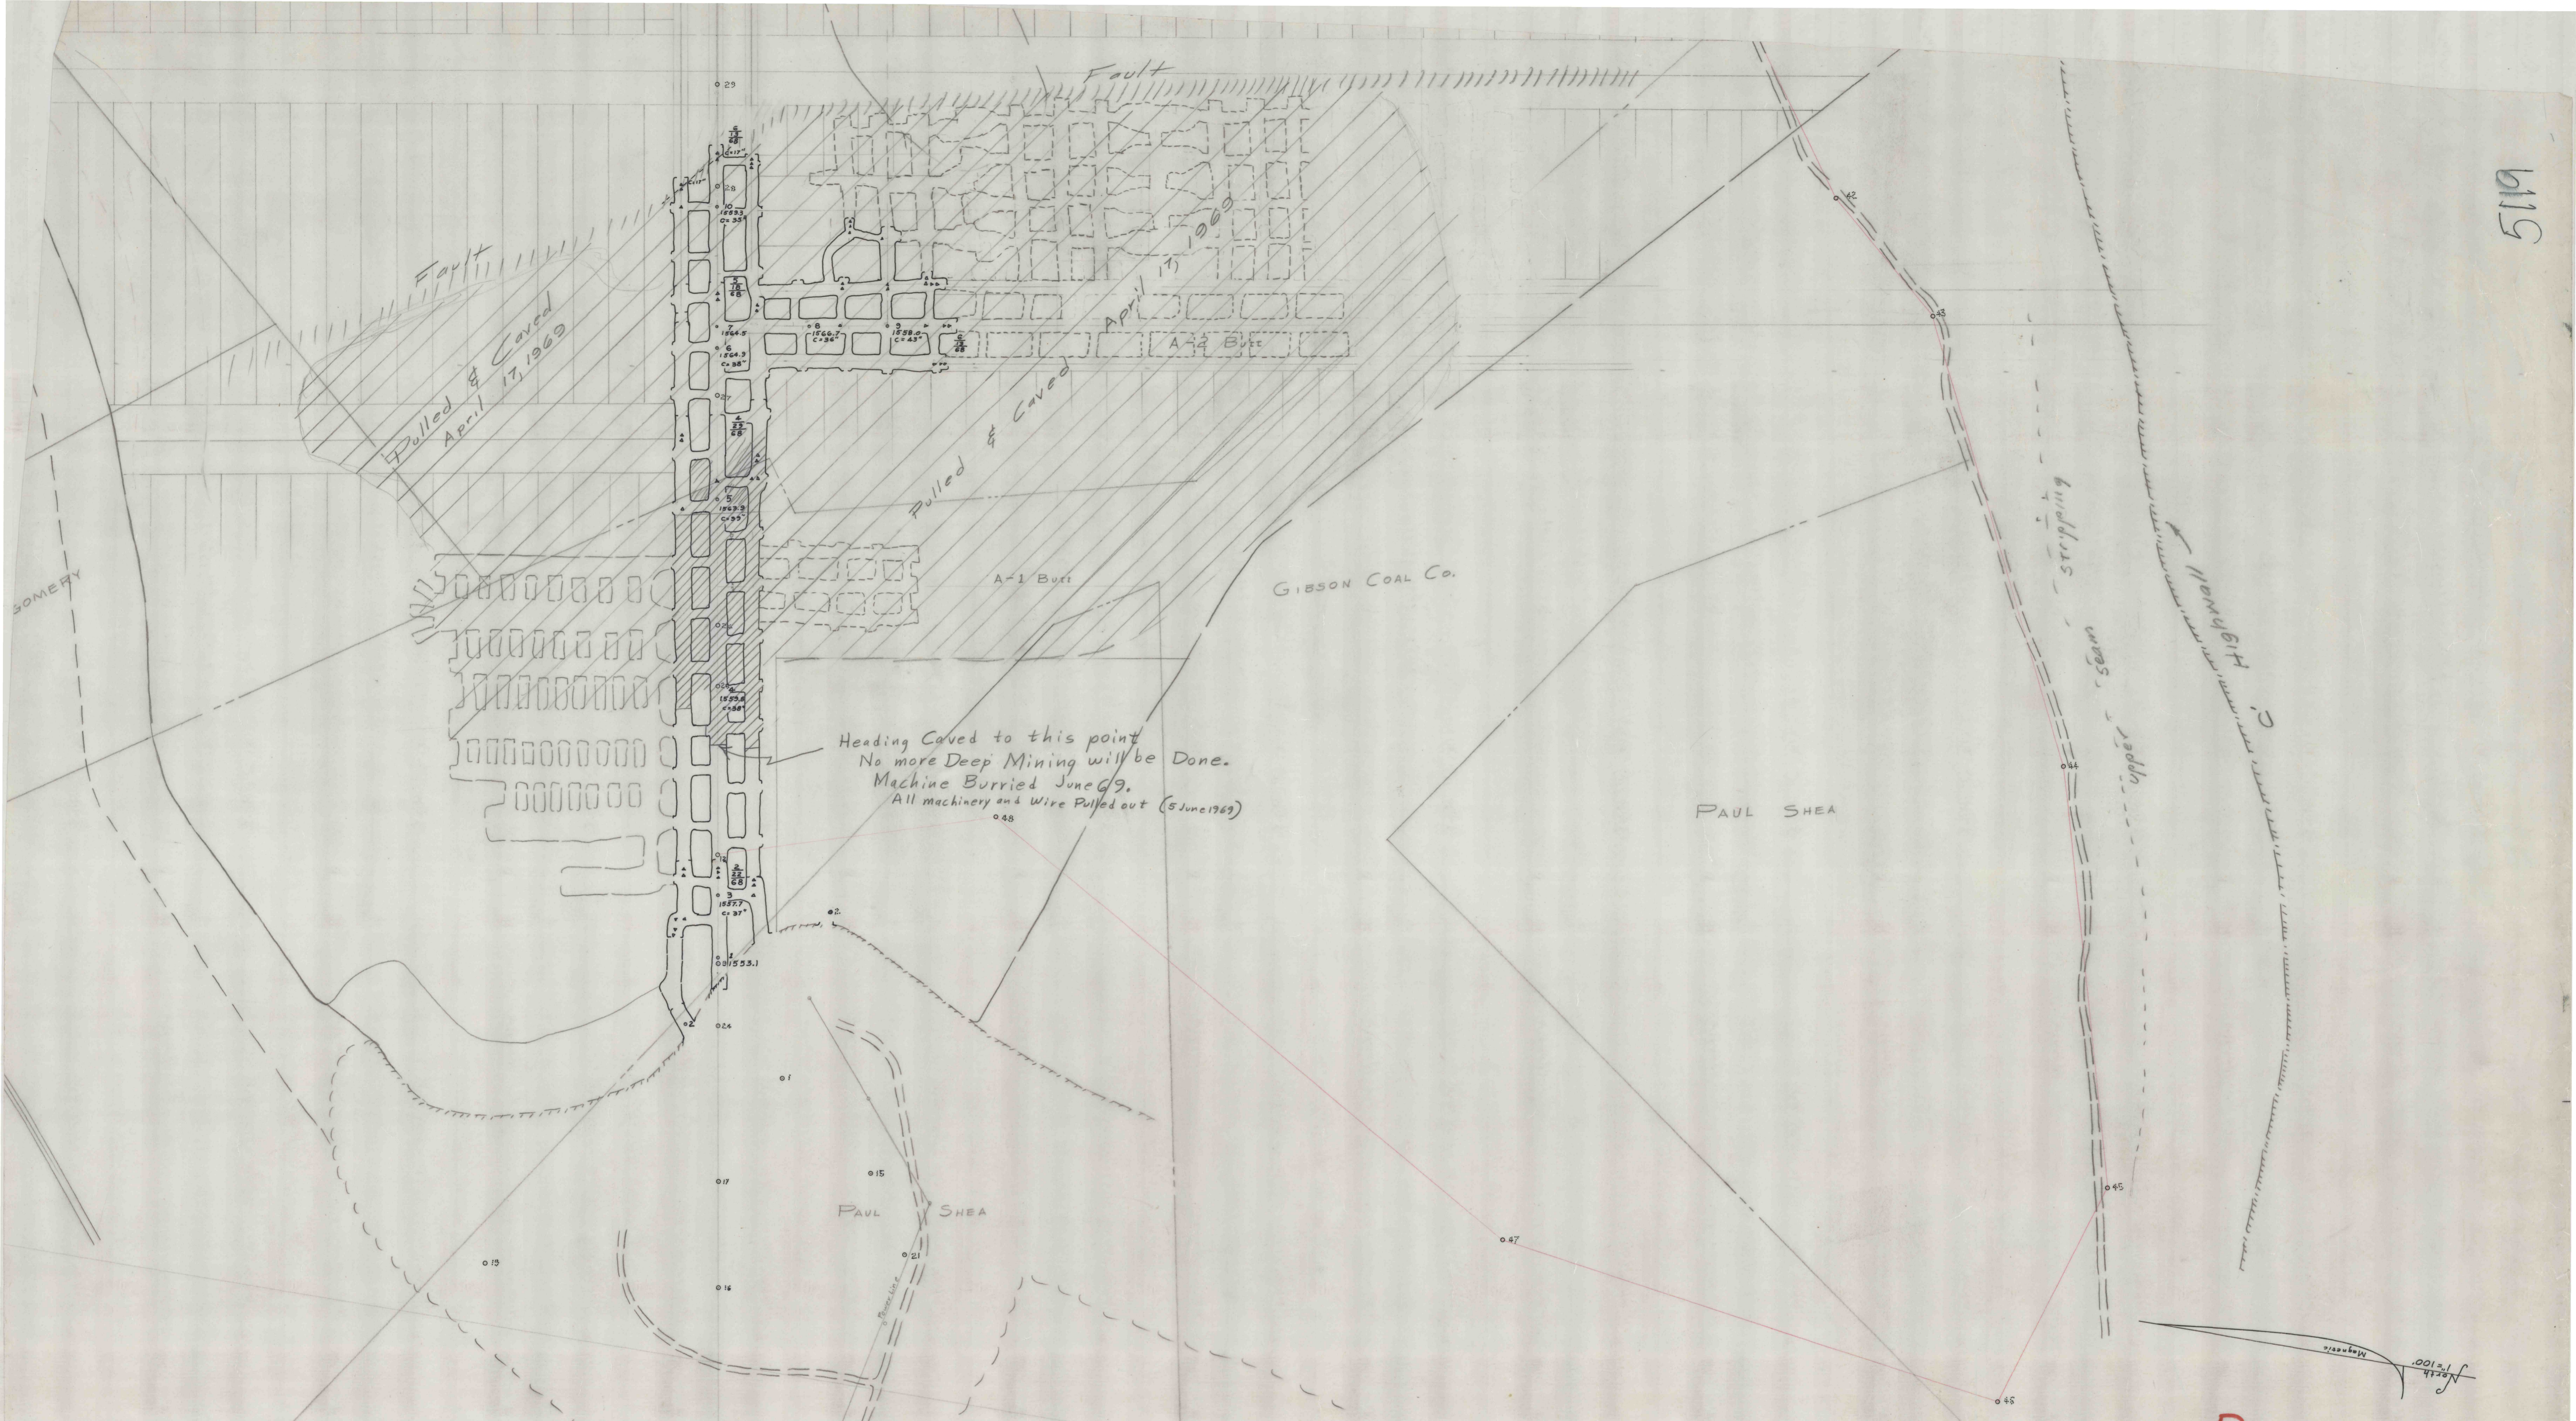

D

Permit No. 356-1

CHANNEL COAL INC

SHERE MINE
SUSQUEHANNA TWP. CAMBRIA CO., PA.

SCALE - 1 inch = 100 feet

JUNE 20, 1968
CLEARFIELD, PA.

JOHN W. HESS
ENGINEER



- CONTEMPLATED MINING 0 Acres
Pulling Pillars
March 15, 1960 to September 15, 1960
- COMPLETED MINING 7 Acres

Revised to comply with 5 June 69 RST
Revised to date 4/11/62 WRR
Revised to date 6/13/68 RST
New Map 6/20/68 RST
Revised to date 8/19/68 RST
Revised to date 4/27/68 WRR
Revised to date 2/22/68 RST
REVISIONS
old map 2/1/68
preliminary 2/25/68

D

5119