


5141

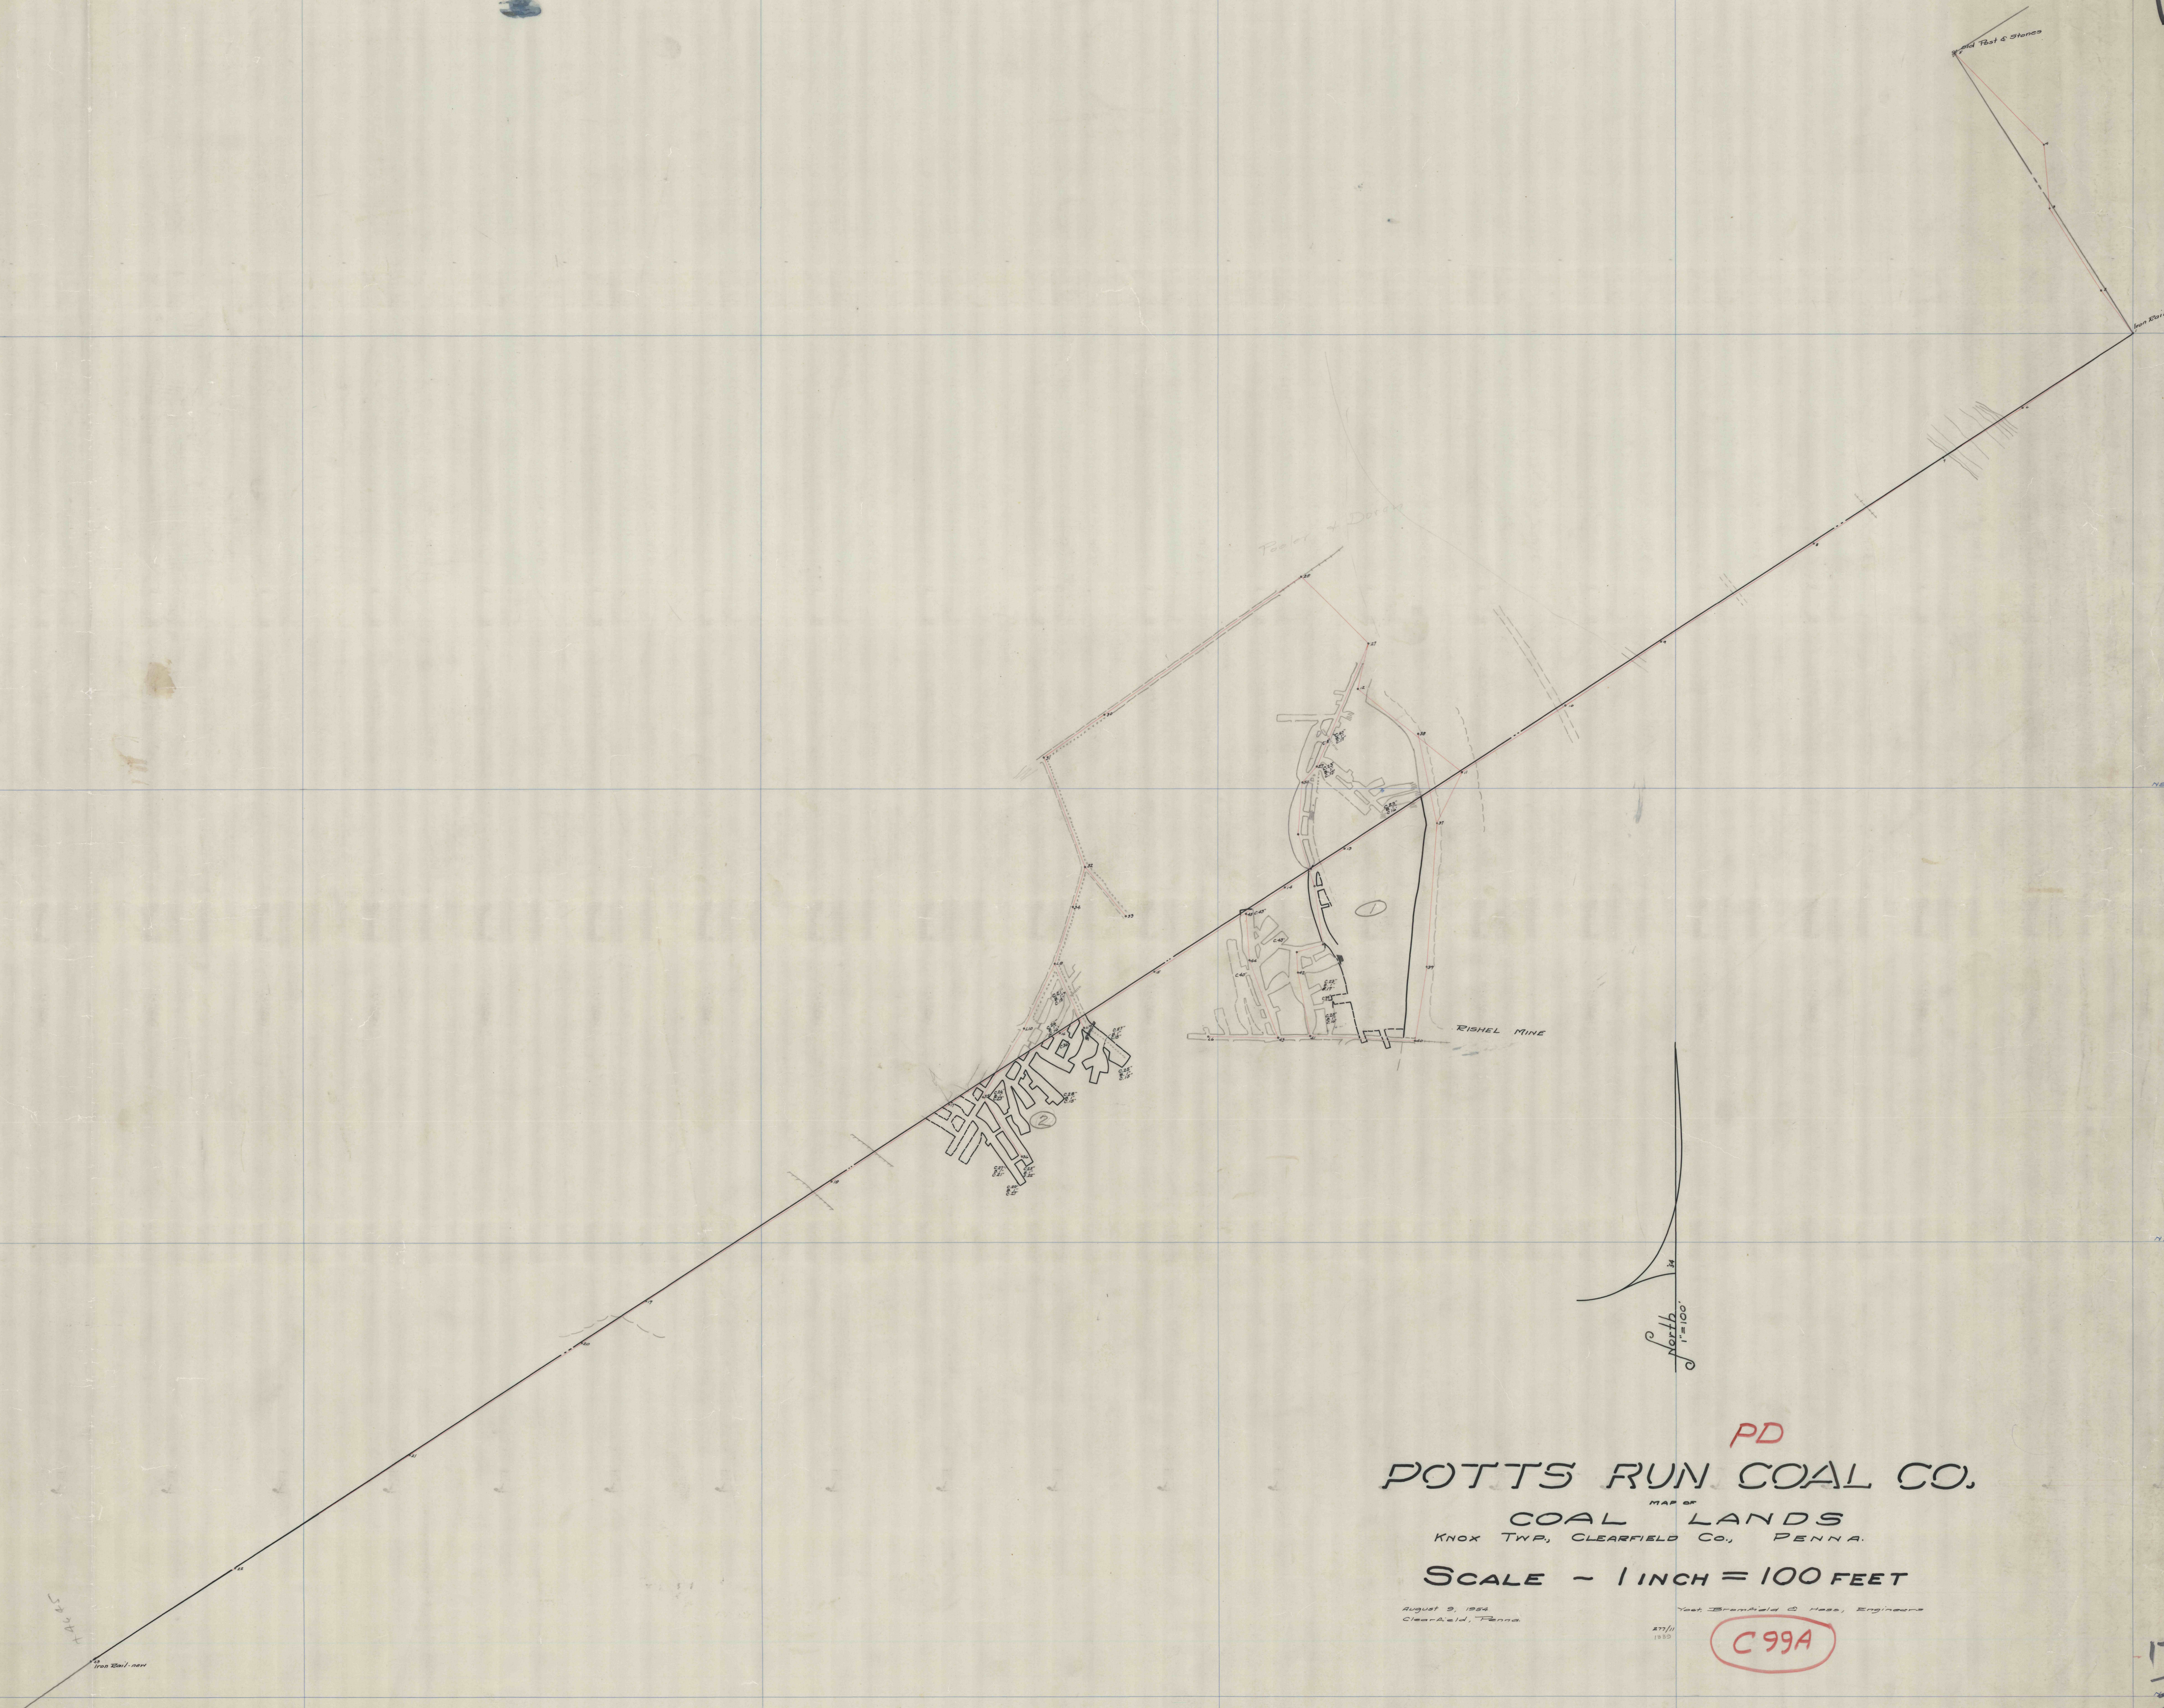

PD  
**POTTS RUN COAL CO.**  
 COAL LANDS  
 KNOX TWP., CLEARFIELD CO., PENNA.  
 SCALE - 1 INCH = 100 FEET

August 9, 1884  
 Clearfield, Penna.  
 West Branchfield C. Hess, Engineer

C99A

2141