


E F SOULD

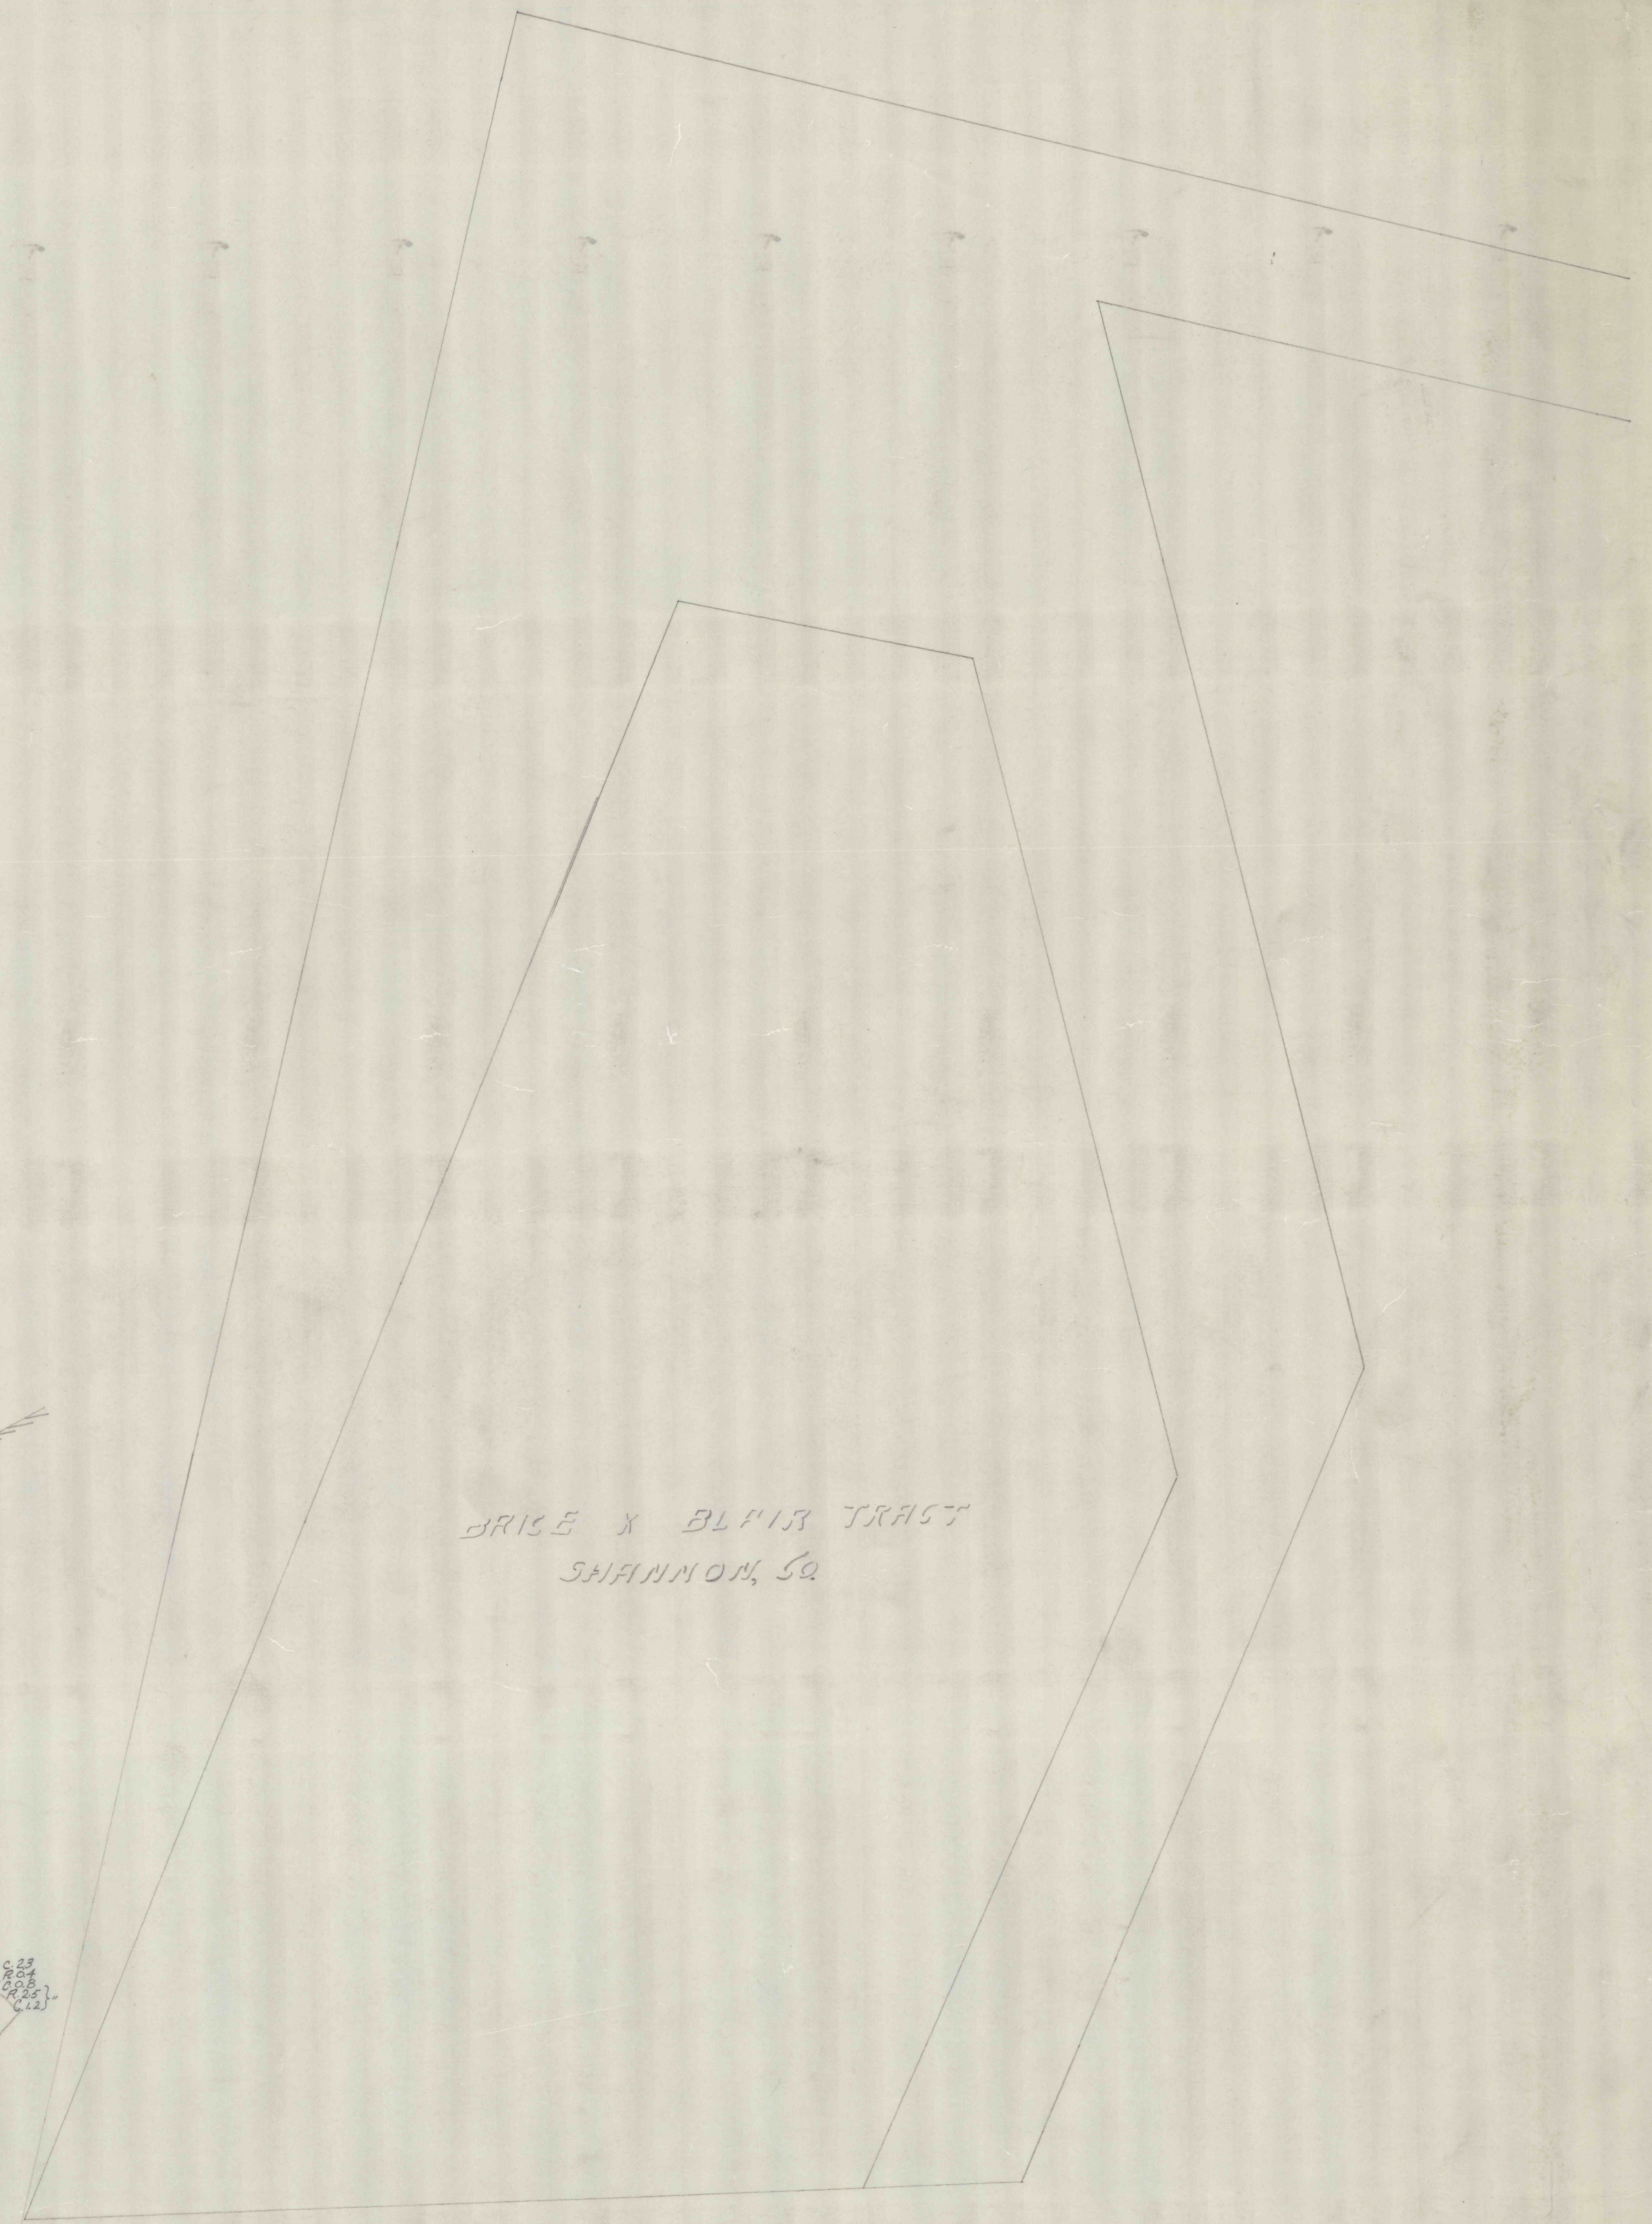

GRISE X BLAIR TRACT
SHANNON, SO

D
JOSEPH E THROPP

Map of
MARTHA MINES

PREPARED BY
SHANNON COMPANY
DUDLEY, WASHINGTON COUNTY, PENNSY.
Scale: 1 inch = 100 feet

NOTE: PROPERTY LINES ARE
TAKEN FROM OLD DEEDS.
LOCATION IS APPROXIMATE

FULTON-SEAM

Vol. 360-441-492
557

1919
REVISED TO CORRECT A 1924

C90A

5163

5163

C90A