

To Clarence
Approximate
Outcrop

DDH #31 ±
68 Deep
No clay

DDH #33
Surf 1001.8
35.0
B.C. 966.9
Mined Platin & soil 2'-6"

DDH #34
Surf 1018.1
43.0
B.C. 970.1
Sandy H.C. 1'-6"

DDH #30
Surf 1032.3
52.0
B.C. 974.3
H.C. 0'-3"

DDH #32
Surf 1033.5
57.0
B.C. 974.5
H.C. 3'-3"

DDH #35
Surf 1004.2
38.0
B.C. 966.2
H.C. 0'-2"

Sandy Clay 1'-2"
H.C. 2'-0"
Sandy S.C. 4'-10"

DDH #29
Surf 1020.6
48.2
B.C. 972.4
H.C. 2'-10"

DDH #36
Surf 1006.6
43.0
B.C. 961.6
H.C. 1'-0"

Sandy Clay 3'-9"

DDH #38
Surf 1008.6
45.0
B.C. 970.1
H.C. 1'-4"

Sandy S.C. 2'-4"

DDH #37
Bot. Cut 1035.8
53.3
B.C. 982.3
H.C. 2'-0"

Sandy H.C. 0'-9"

DDH #34
Surf 1035.4
56.0
B.C. 989.4
H.C. 4'-0"

DDH #32
Surf 1023.2
52.0
B.C. 978.2
H.C. 0'-2"

DDH #15
Surf 1021.1
51.0
B.C. 979.1
H.C. 1'-2"

Sandy H.C. 1'-2"

DDH #9
Surf 1020.9
48.0
B.C. 974.9
H.C. 6'-0"

Shaly Clay

DDH #7
Surf 1023.2
52.0
B.C. 978.2
H.C. 0'-2"

DDH #8
Surf 1023.8
52.0
B.C. 978.8
H.C. 0'-7"

Sandy H.C. 0'-7"











DDH #4
Surf 1105.1
60.0
B.C. 1041.3
H.C. 3'-0"

Sandy H.C. 3'-0"

DDH #5
Surf 1112.8
65.0
B.C. 1084.9
H.C. 3'-0"

Sandy H.C. 3'-0"

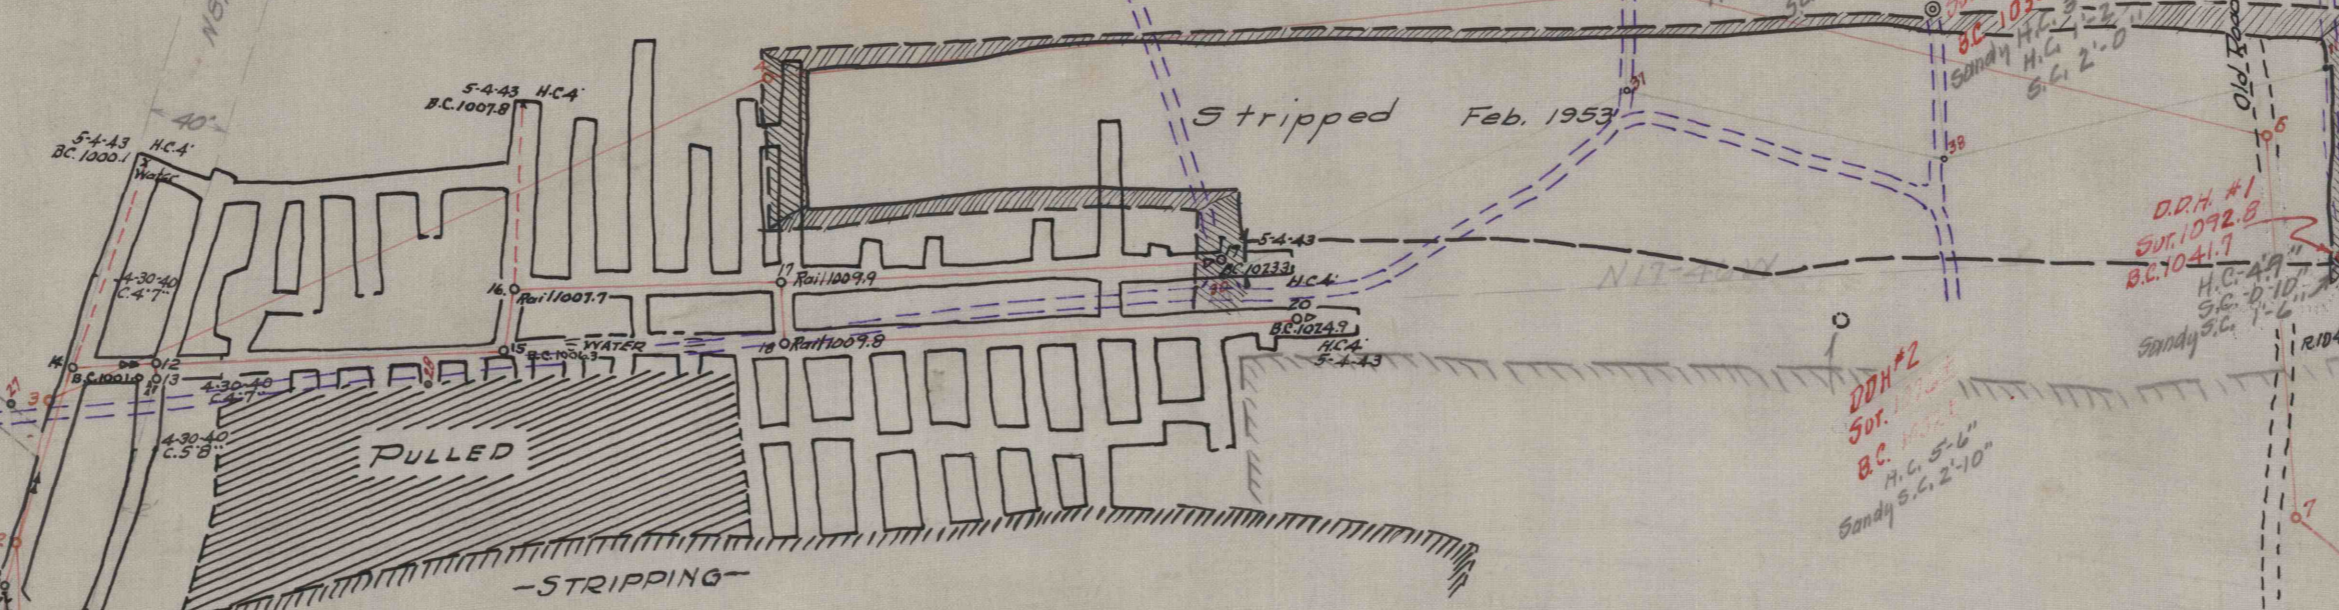

MDH

J.H. FRANCE REFRACORIES Co.
SNOW SHOE, PENNA.

BAYARD N^o 2 CLAY MINE

BURNSIDE TWP CENTRE CO. PENNA.

SCALE 1 IN = 100 FT.

May 4, 1940 Index 50H Map Book 7252 Wm. W. Yost, Engr.

1394

Surveyed (Surface) October 12, 1943
Surveyed (Mine) May 4, 1943
DDH's Oct. 6, 1943 Nos. 2, 4, 9
DDH's Feb. 1953 Nos. 1, 2, 3, 50