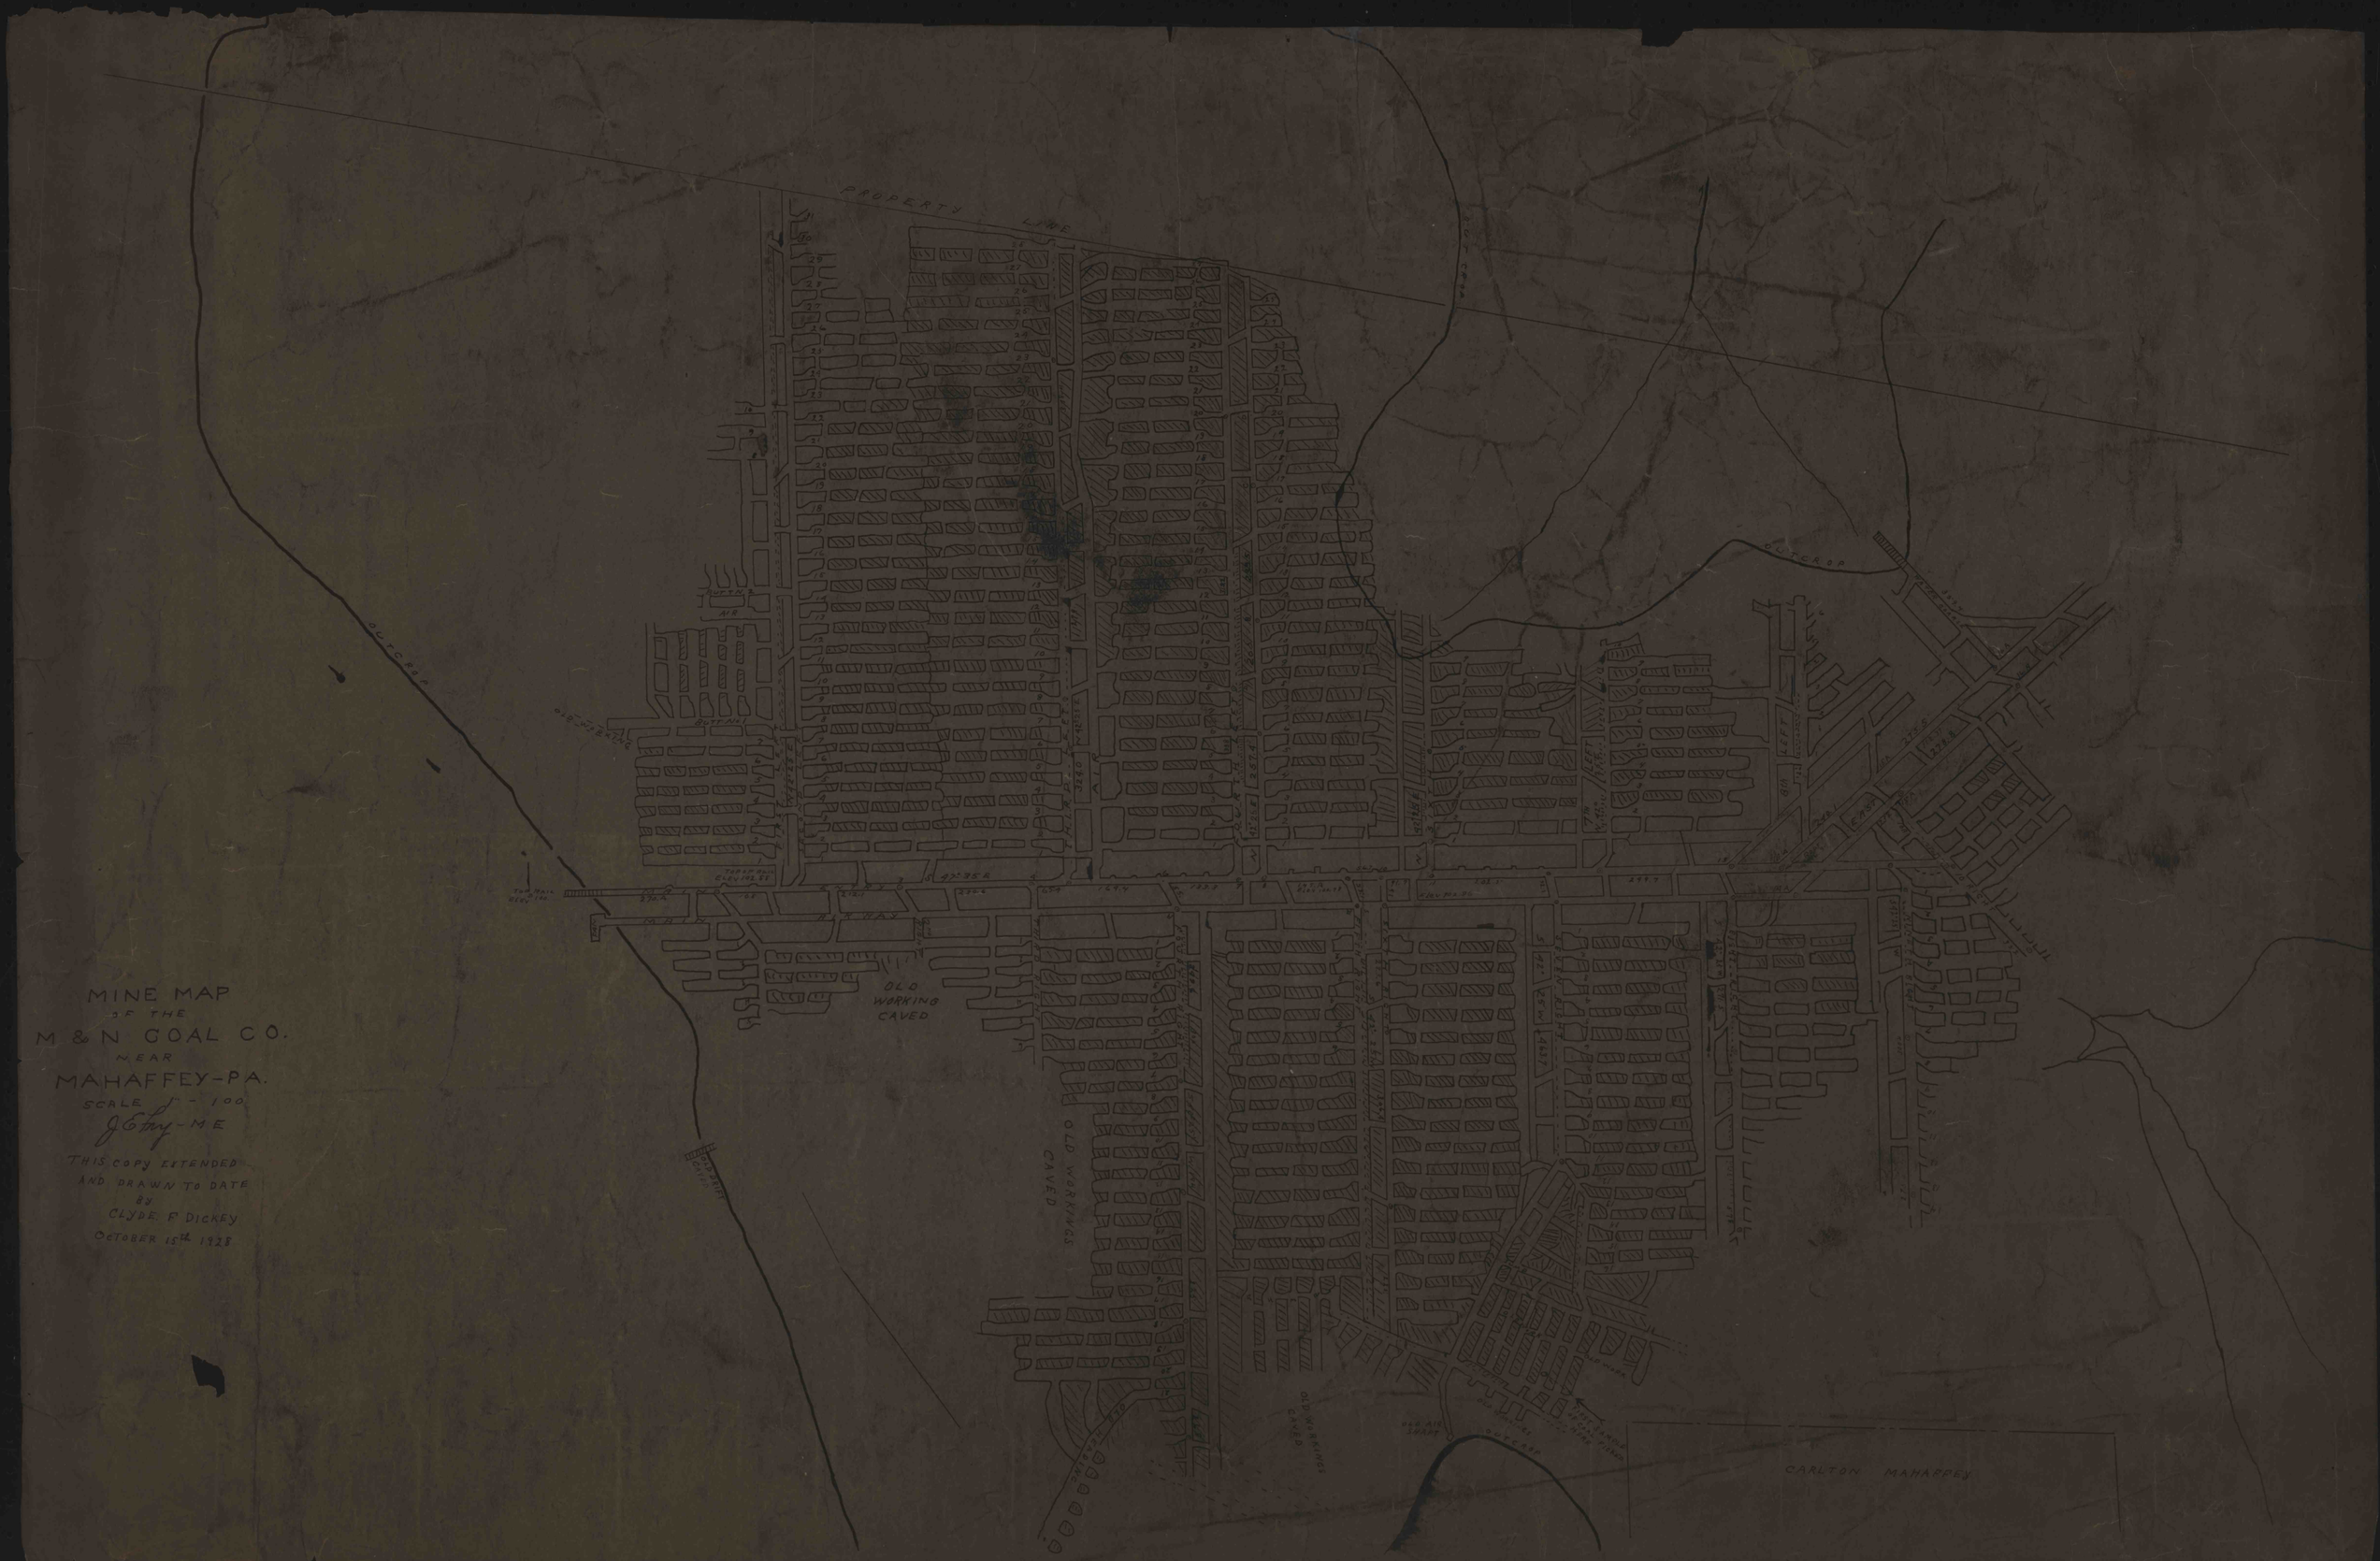


MINE MAP
OF THE
M & N COAL CO.
NEAR
MAHAFFEY-PA.
SCALE 1" - 100'
J.G. Fry - M.E.

THIS COPY EXTENDED
AND DRAWN TO DATE
BY
CLYDE F. DICKEY
OCTOBER 15th 1928