


5207

5207

C79B

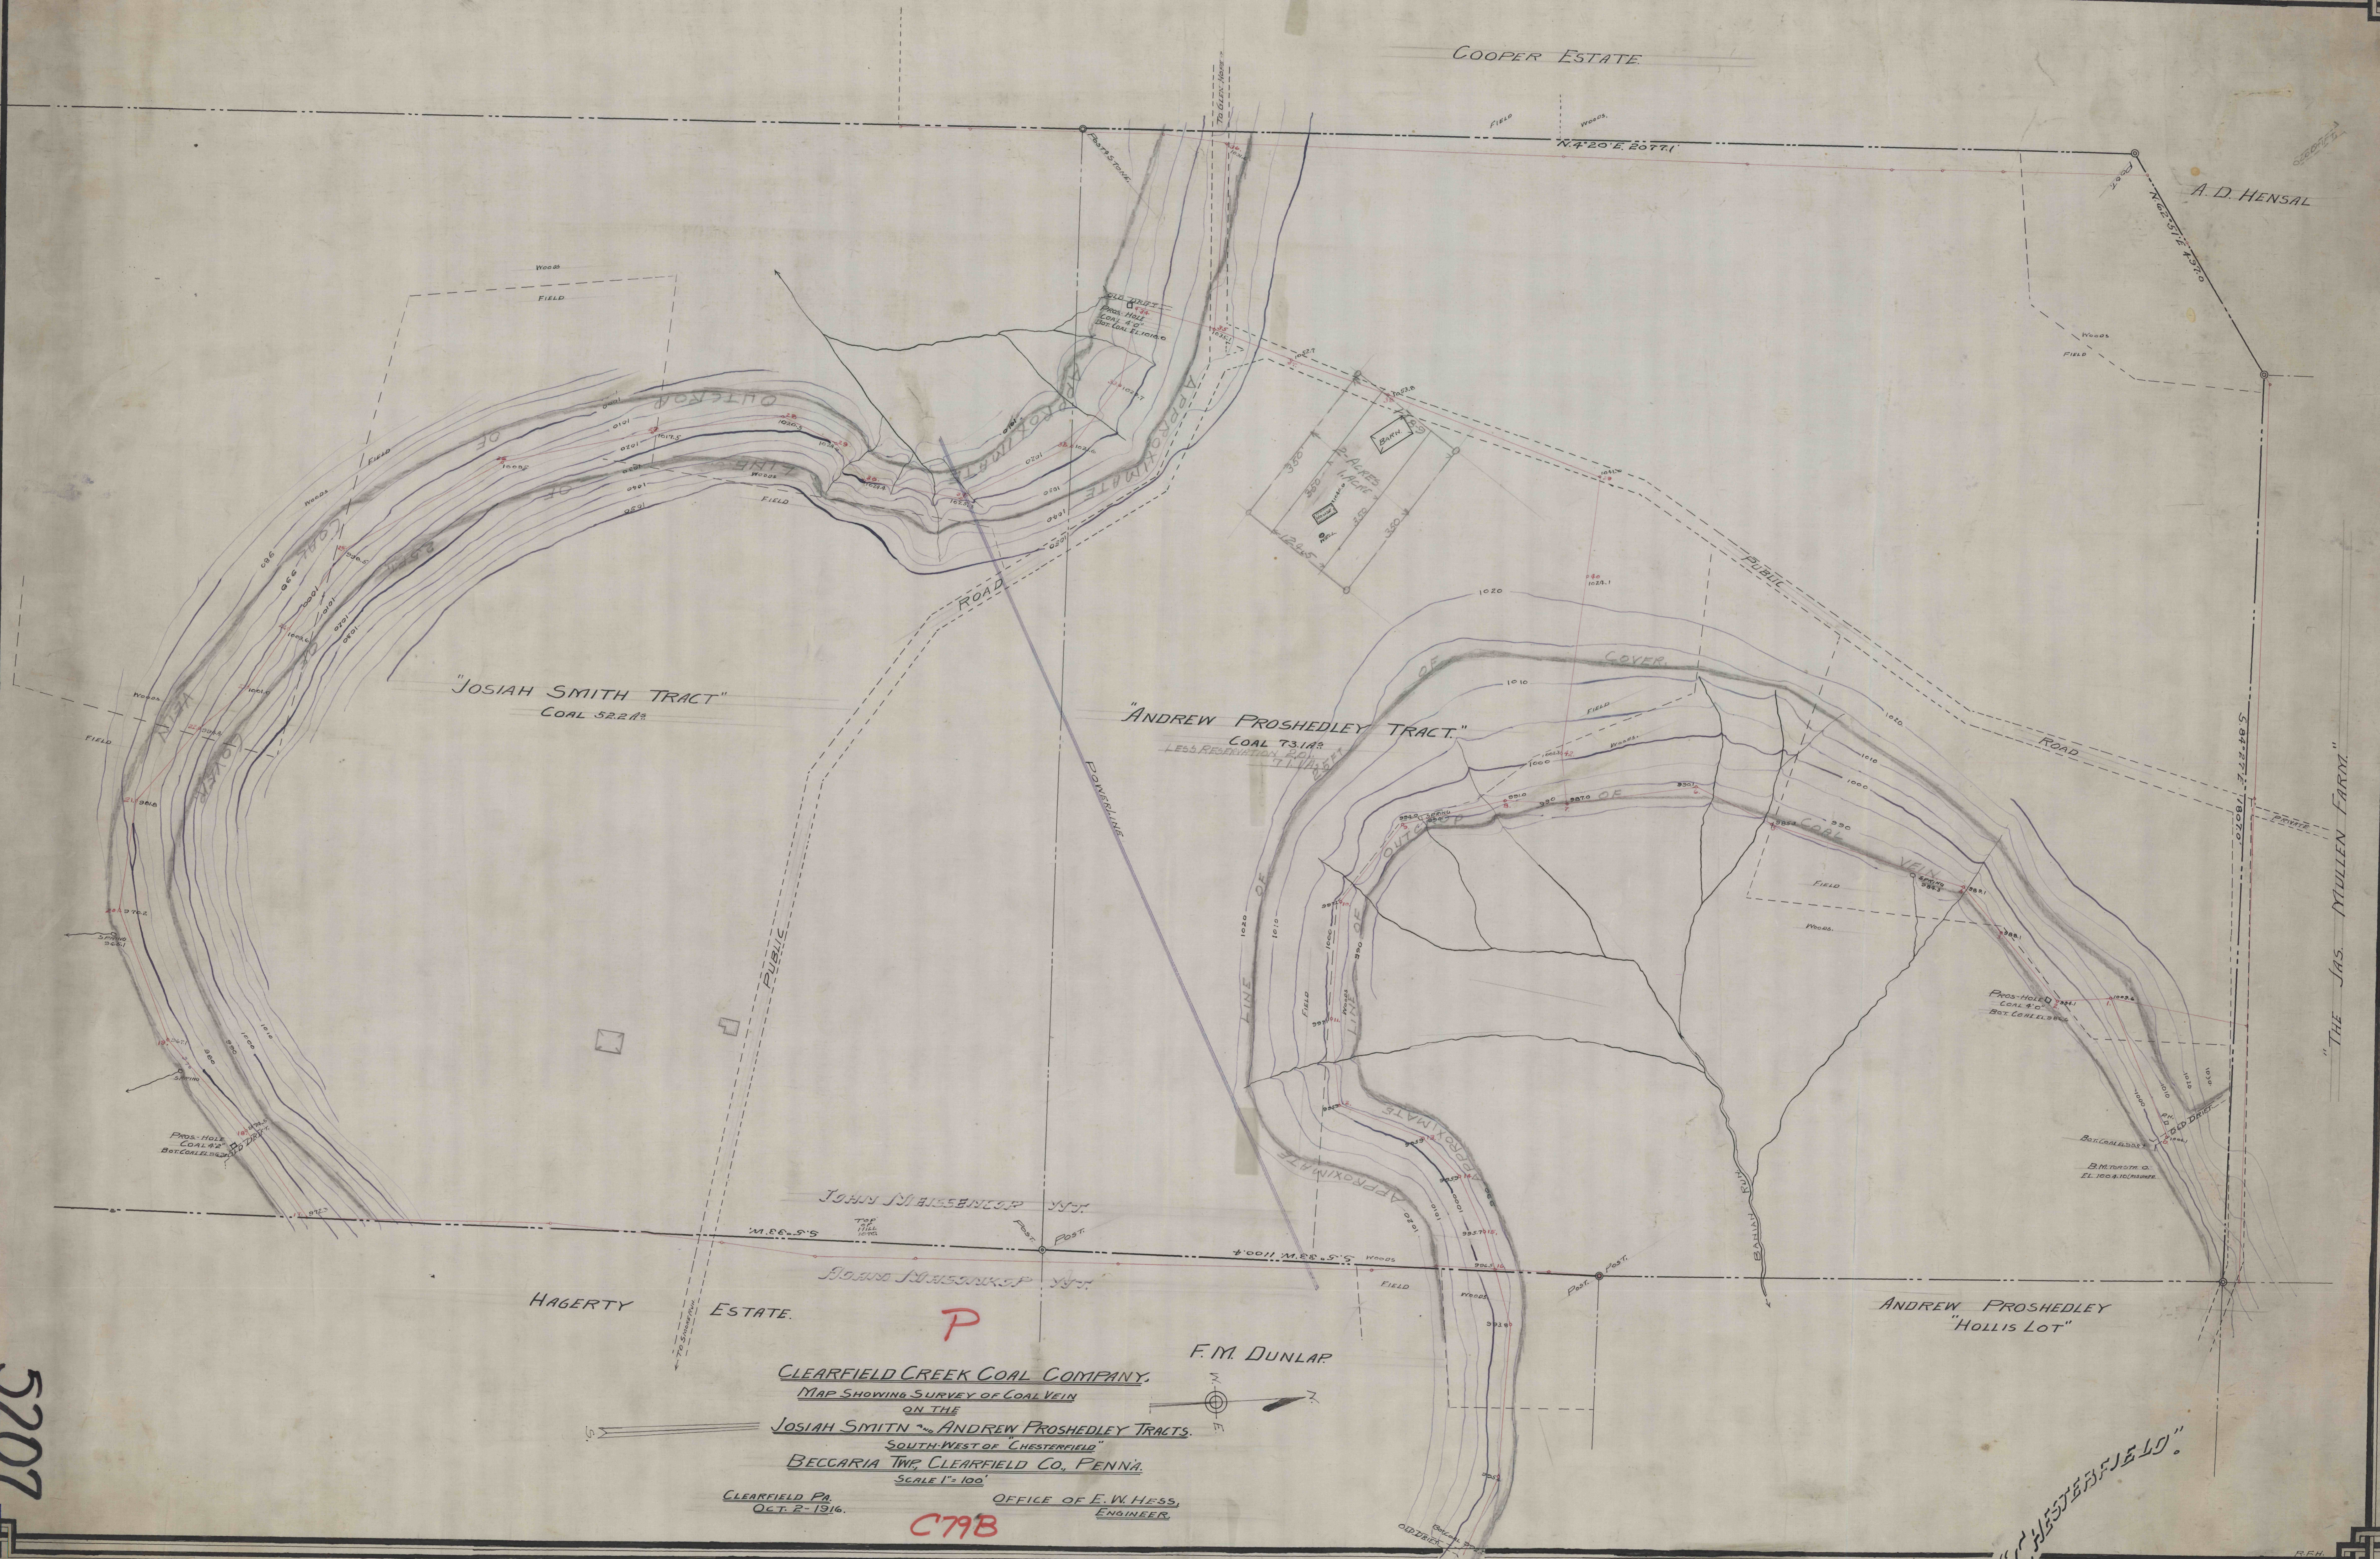

HAGERTY ESTATE

JOHN MESSINGER

JOHN MESSINGER

ANDREW PROSHEDLEY
"HOLLIS LOT"

CLEARFIELD CREEK COAL COMPANY

MAP SHOWING SURVEY OF COAL VEIN
ON THE

JOSIAH SMITH AND ANDREW PROSHEDLEY TRACTS

SOUTH-WEST OF "CHESTERFIELD"


BECCARIA TWP. CLEARFIELD CO., PENNA.

CLEARFIELD PA.
OCT. 2-1916.

OFFICE OF E. W. HESS,
ENGINEER.

C79B

F. M. DUNLAP

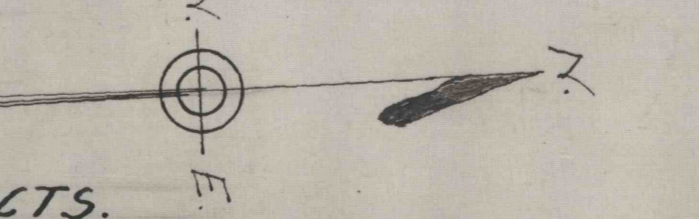

"CHESTERFIELD"