




70 Acres Coal Remaining  
 or 22' Thick  
 1500 BT. Recoverable Per Ft. Acre  
 274,000 B.N.T. Remaining

WELKER.

W.D. AND C.A. WALKER. (COAL)

"LUMADUE"

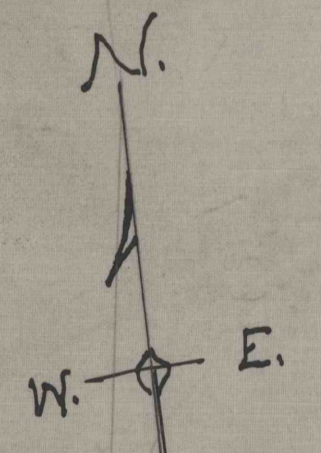

PD

**W.D. AND C.A. WALKER**  
 BIGLER, PENNA.  
**MAP OF COAL OPERATION**  
 NORTH OF WOODLAND.  
 BRADFORD TOWNSHIP CLEARFIELD CO. PA.  
 SCALE 1"=100'  
 CLEARFIELD PA.  
 MAY 7-1934.  
 OFFICE OF E.W. HESS,  
 ENGINEER.

C.150

REVISED DEC. 17 1937  
 JAN 7 1941

*Handwritten scribbles and initials in the bottom left corner.*

5295

C.150