

#7  
Blank

DDH#8  
0'-6" Faulty

DDH#2  
Blank

ELIM PASSMORE


130  
Blank  
63' Deep

129  
67' Deep  
2' Good clay  
12' poor clay

131  
65' Deep  
5' H.C. good  
7' clay poor

133  
3' Block Fair  
0'-5" S.C. poor

132  
65' Deep  
5' clay poor  
15' S.C. & Rock

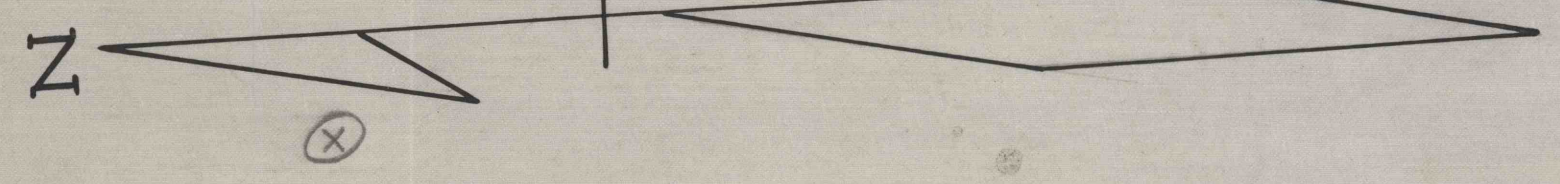

**NORTH AMERICAN REFRACTORIES CO.**  
CURWENSVILLE, CLEARFIELD COUNTY, PA.  
ENGINEERING DEPARTMENT

"LAUREL SWAMP"  
CLAY MINE & STRIPPING  
D.&A. WAY TRACT - PIKE TWP.  
CLEARFIELD CO. PA.

DRAWN *JWH* SCALE 1/2"=100 FT.  
CHECKED DATE 1/17/35  
REFERENCE ORDER 53-2-2