


DDH#8

ELITE PASSMORN

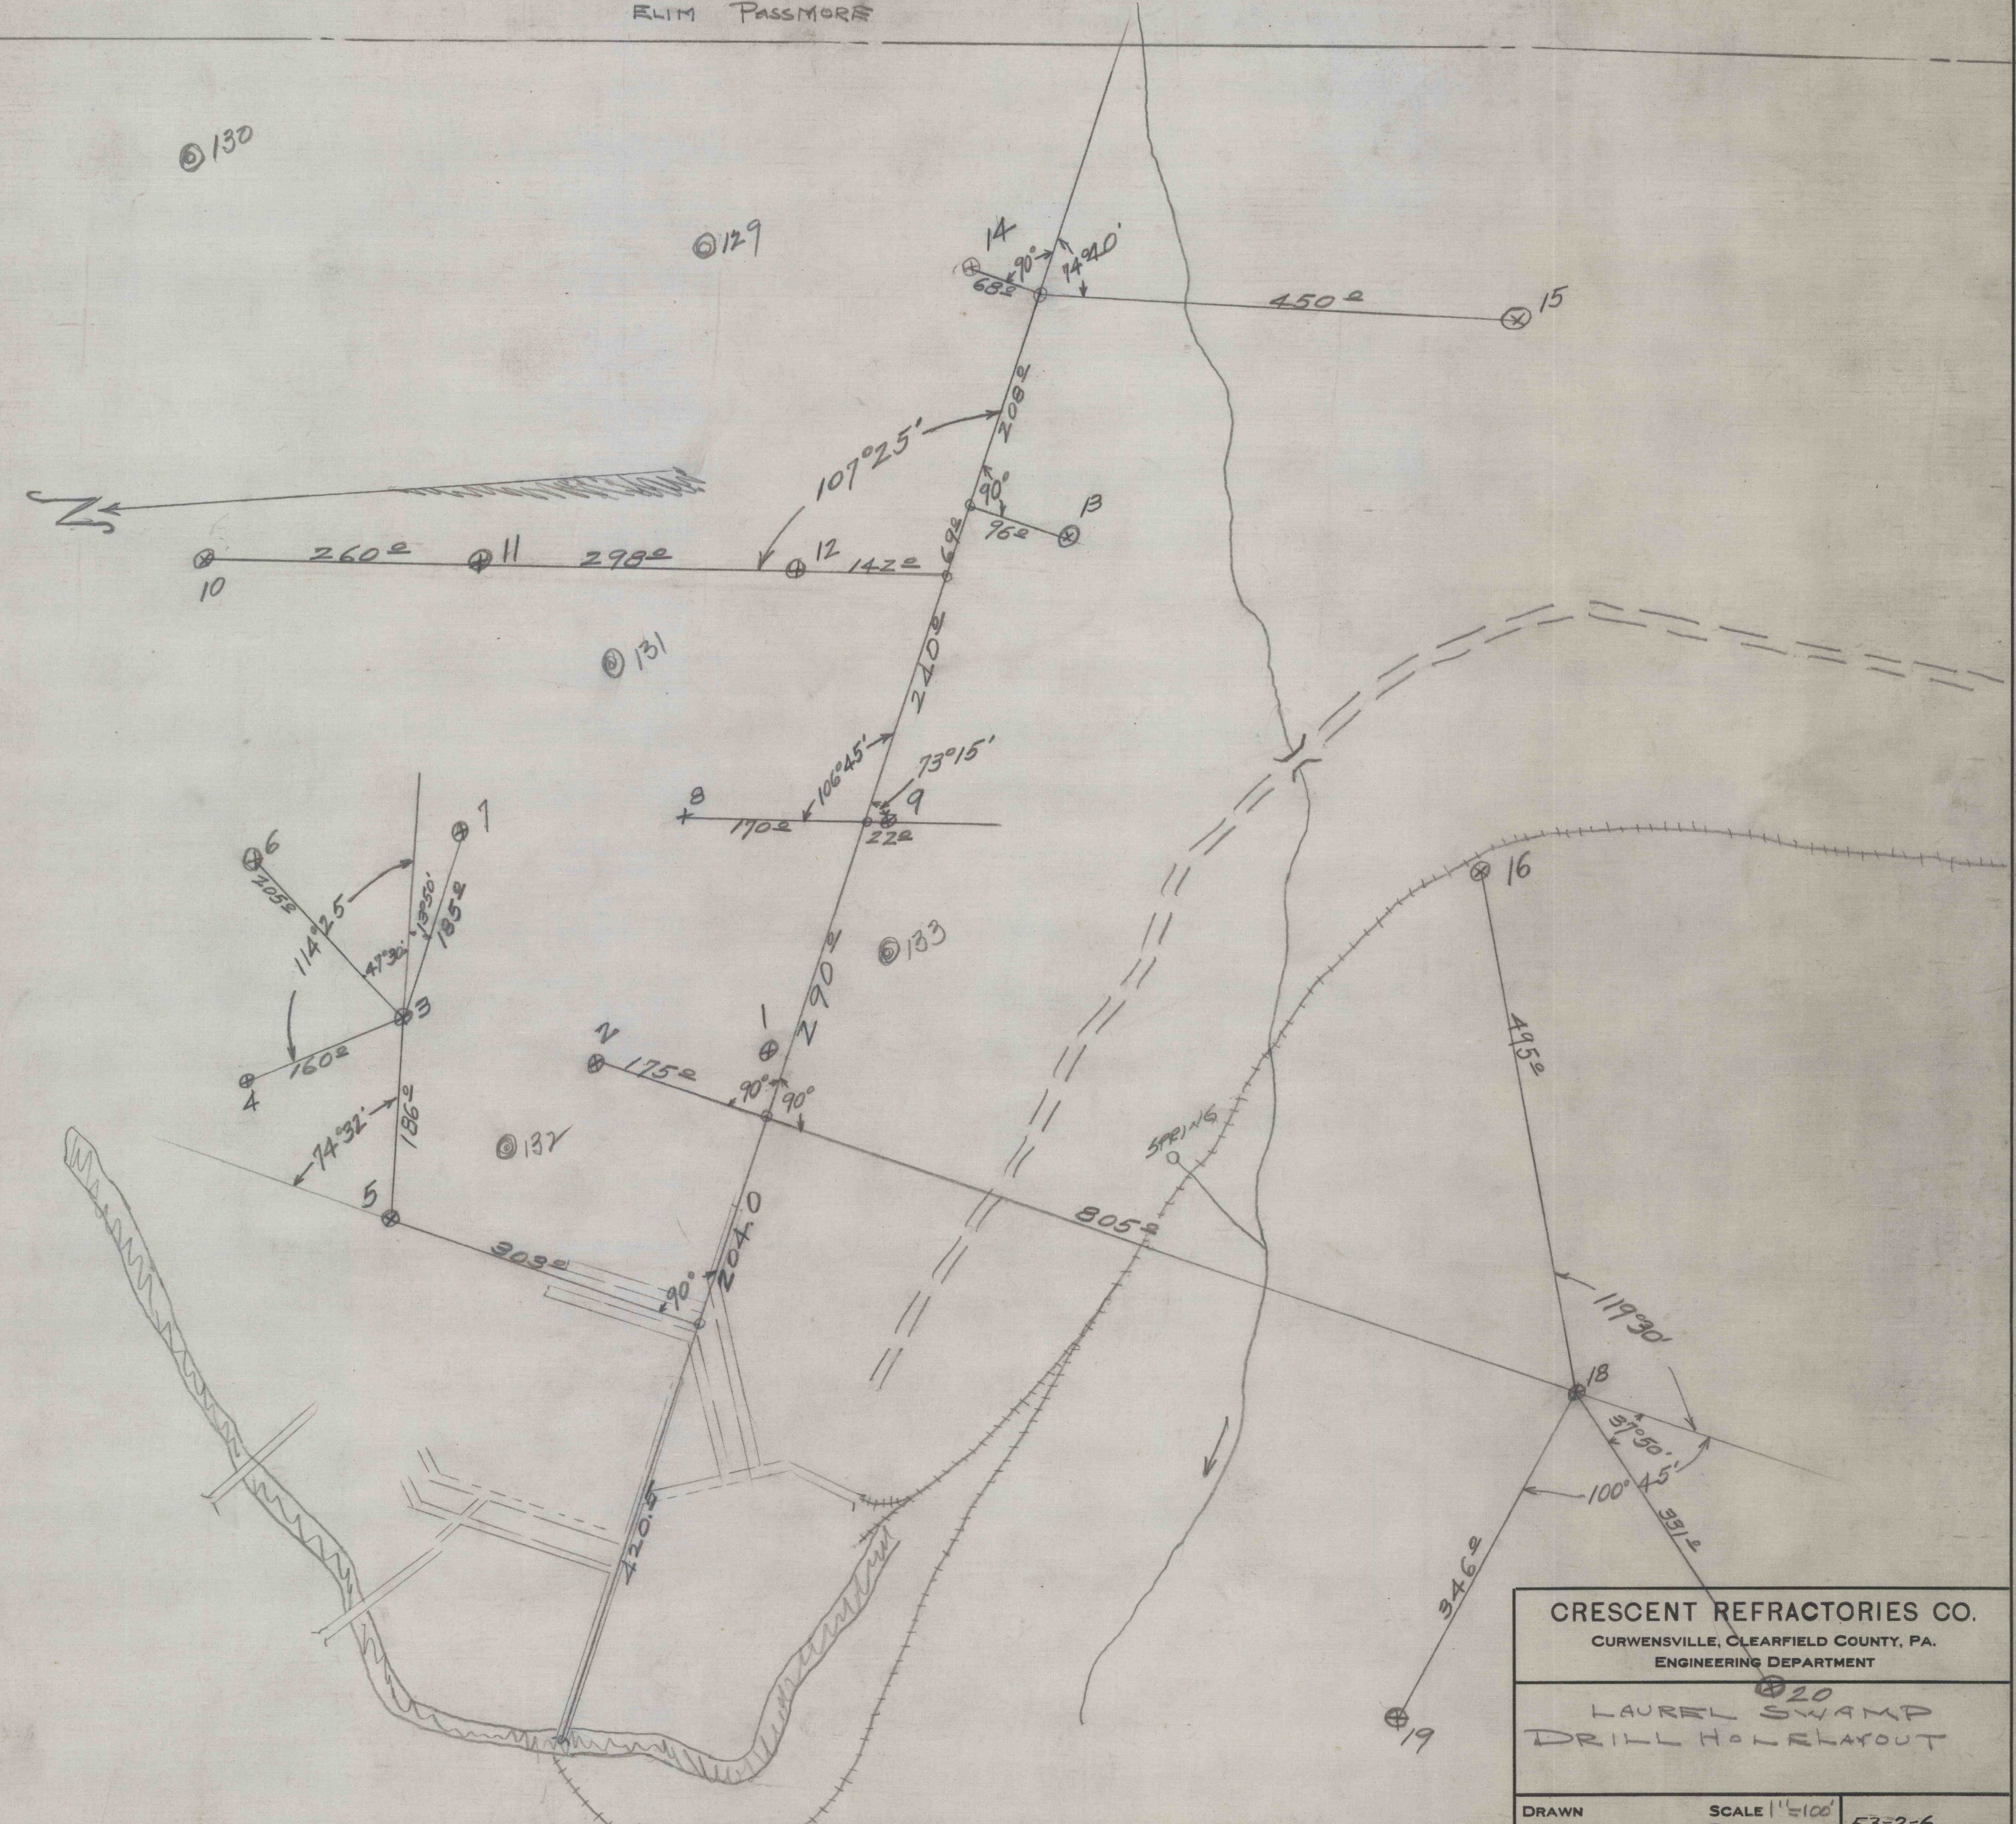

CRESCENT REFRACTORIES CO.
 CURWENSVILLE, CLEARFIELD COUNTY, PA.
 ENGINEERING DEPARTMENT

LAUREL SWAMP
 DRILL HOLE LAYOUT

DRAWN	SCALE 1"=100'	53-2-6
CHECKED	DATE	
REFERENCE	ORDER	