


B315

B3

B315

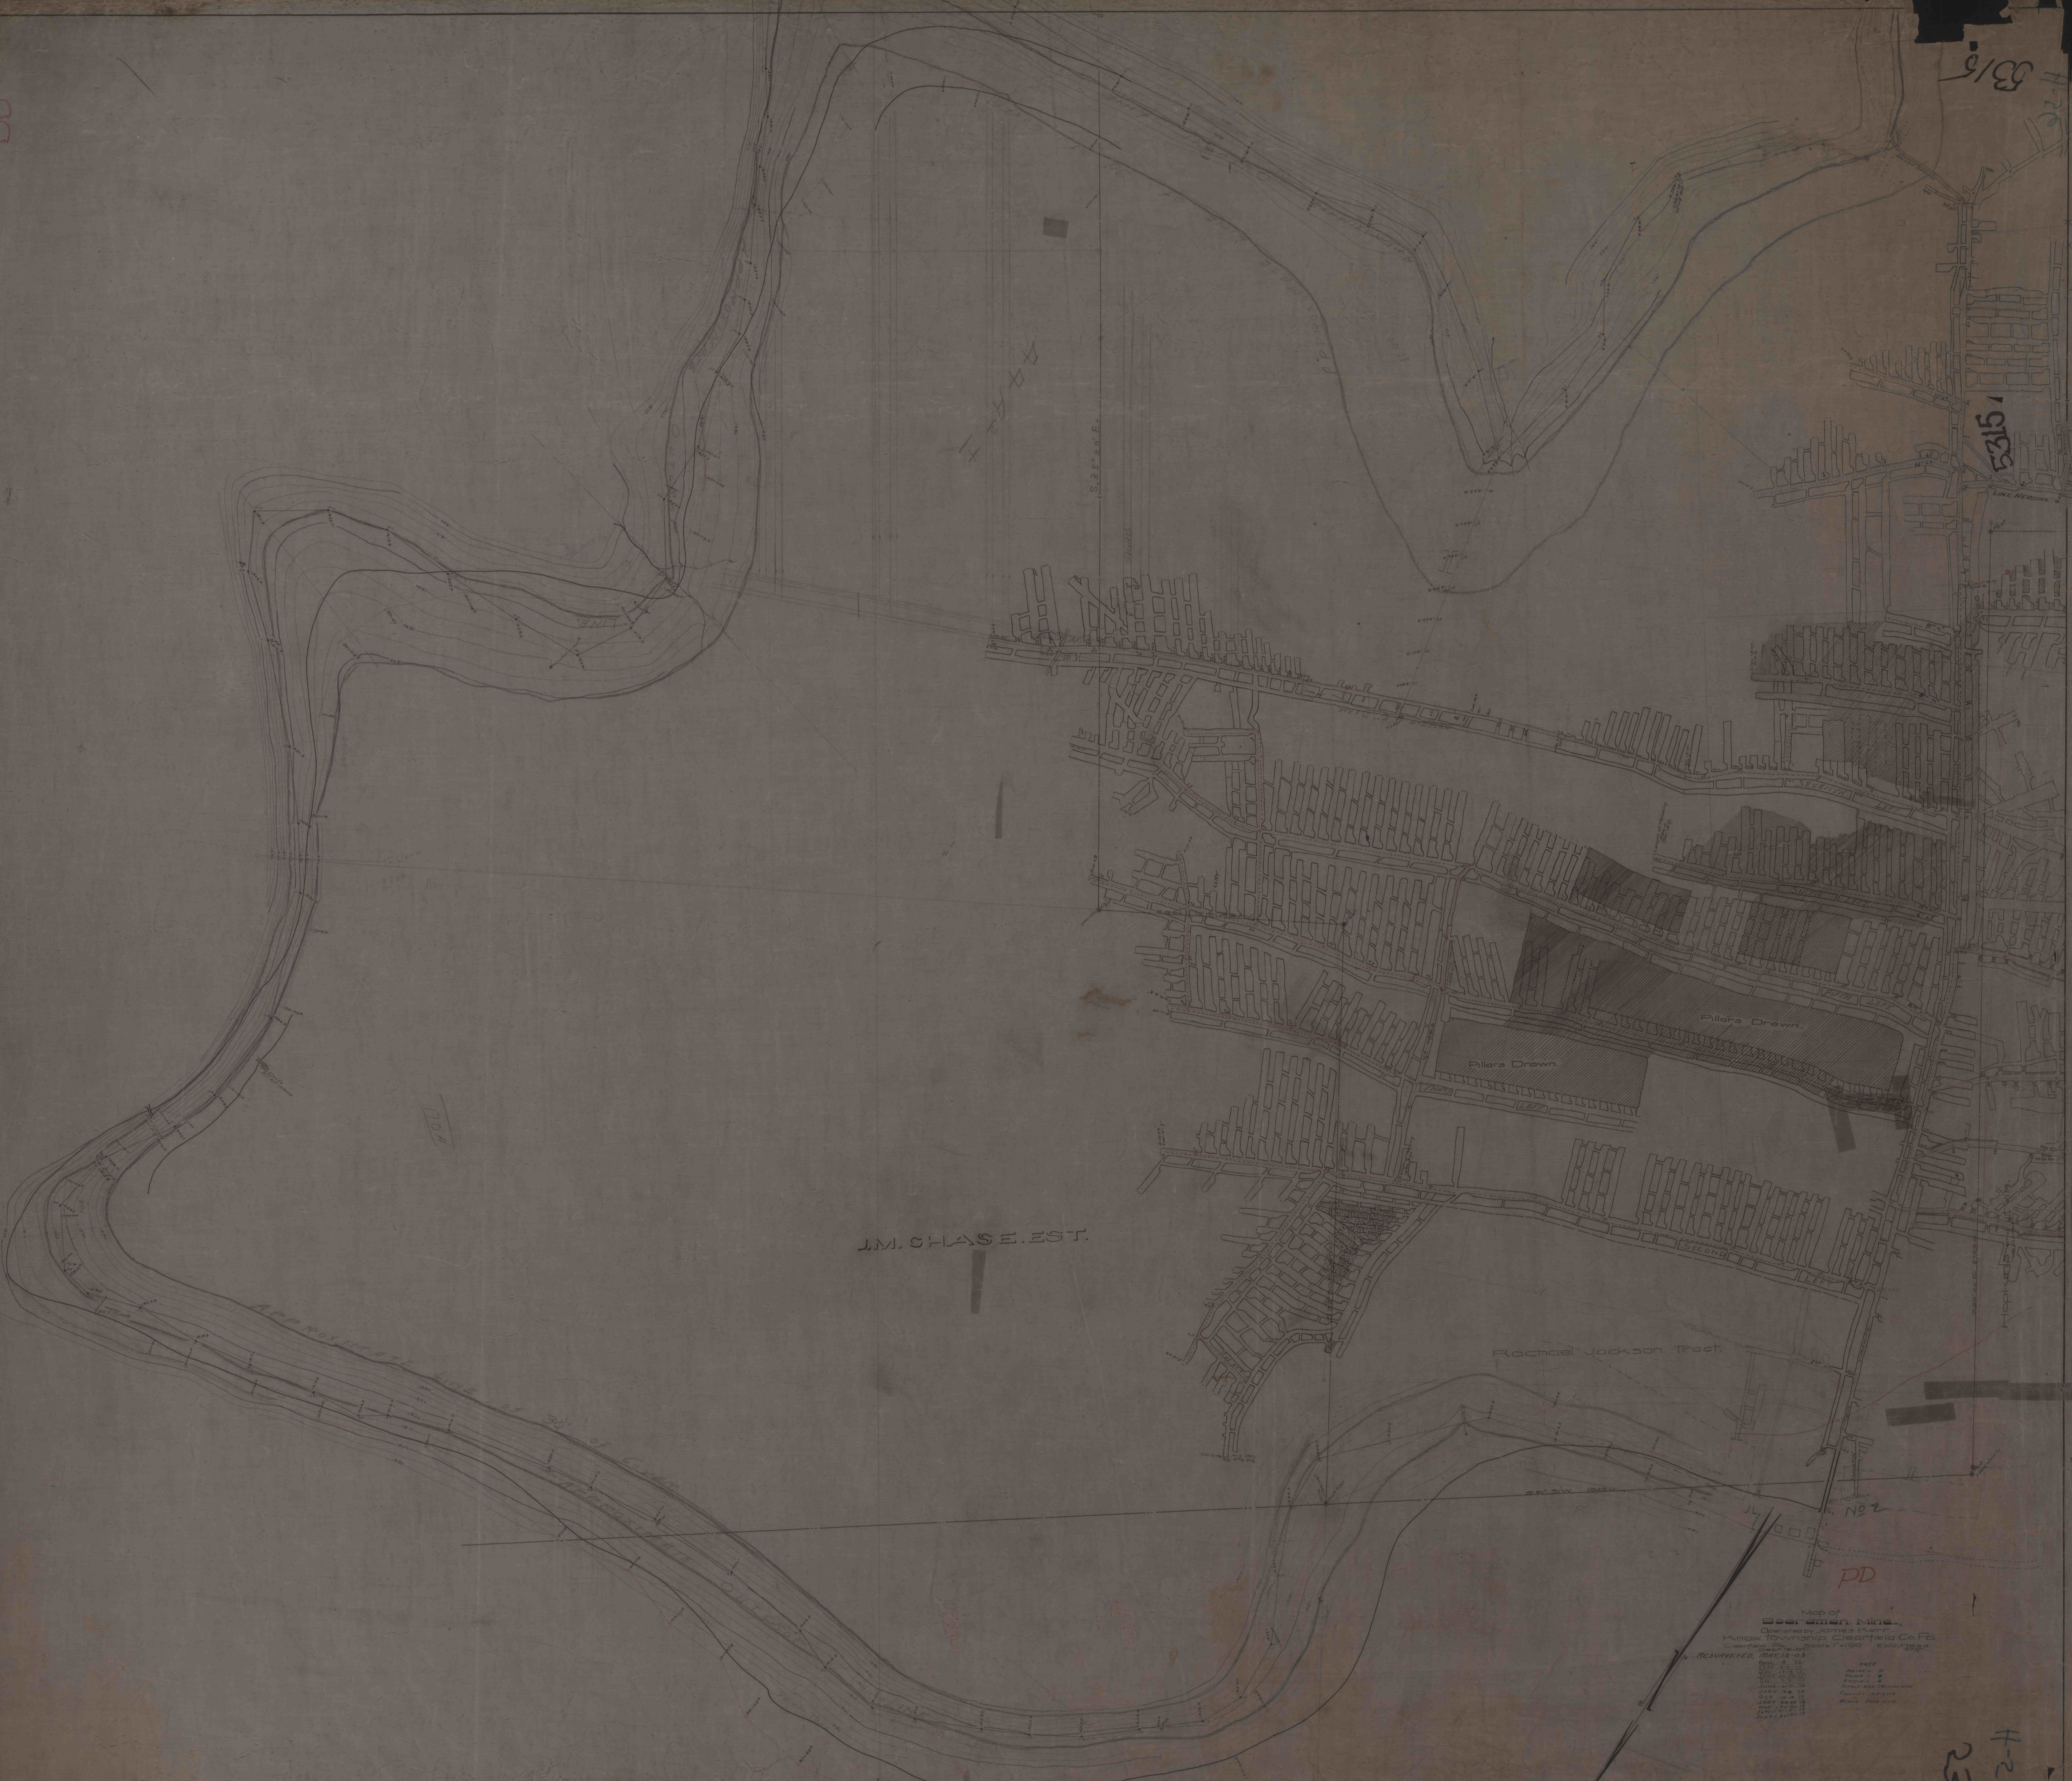

J.M. CHASE, EST.

Rachel Jackson Tract

Pillars Drawn

Pillars Drawn

Map of


PD

H-20
2312