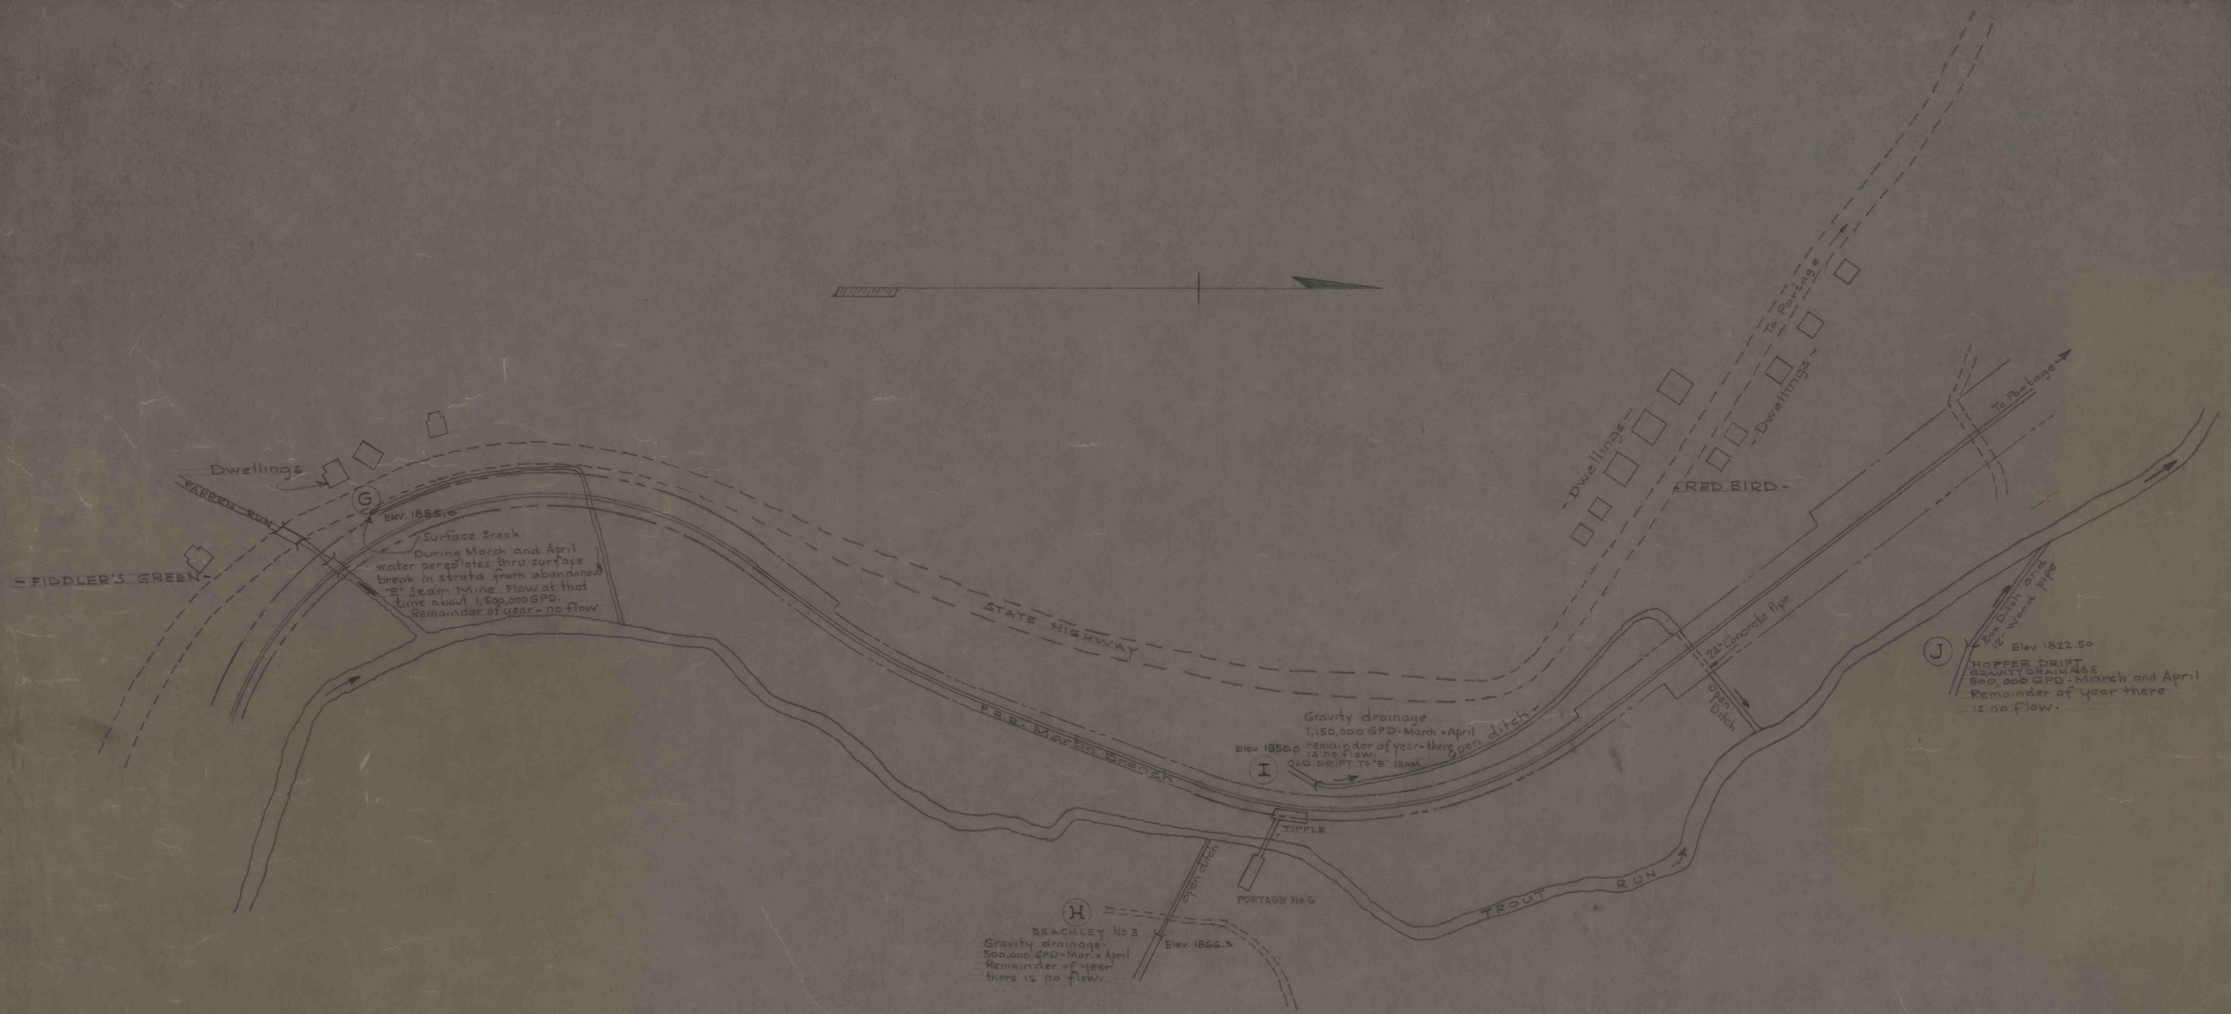

JOHNSTOWN COAL & COKE COMPANY

DETAIL OF MINE DRAINAGE

STATIONS - G, H, I, J -

SCALE 1" = 100'

ANDREW B. CEICHTON
Mining Engineer
Johnstown, Pa.

JULY 1945