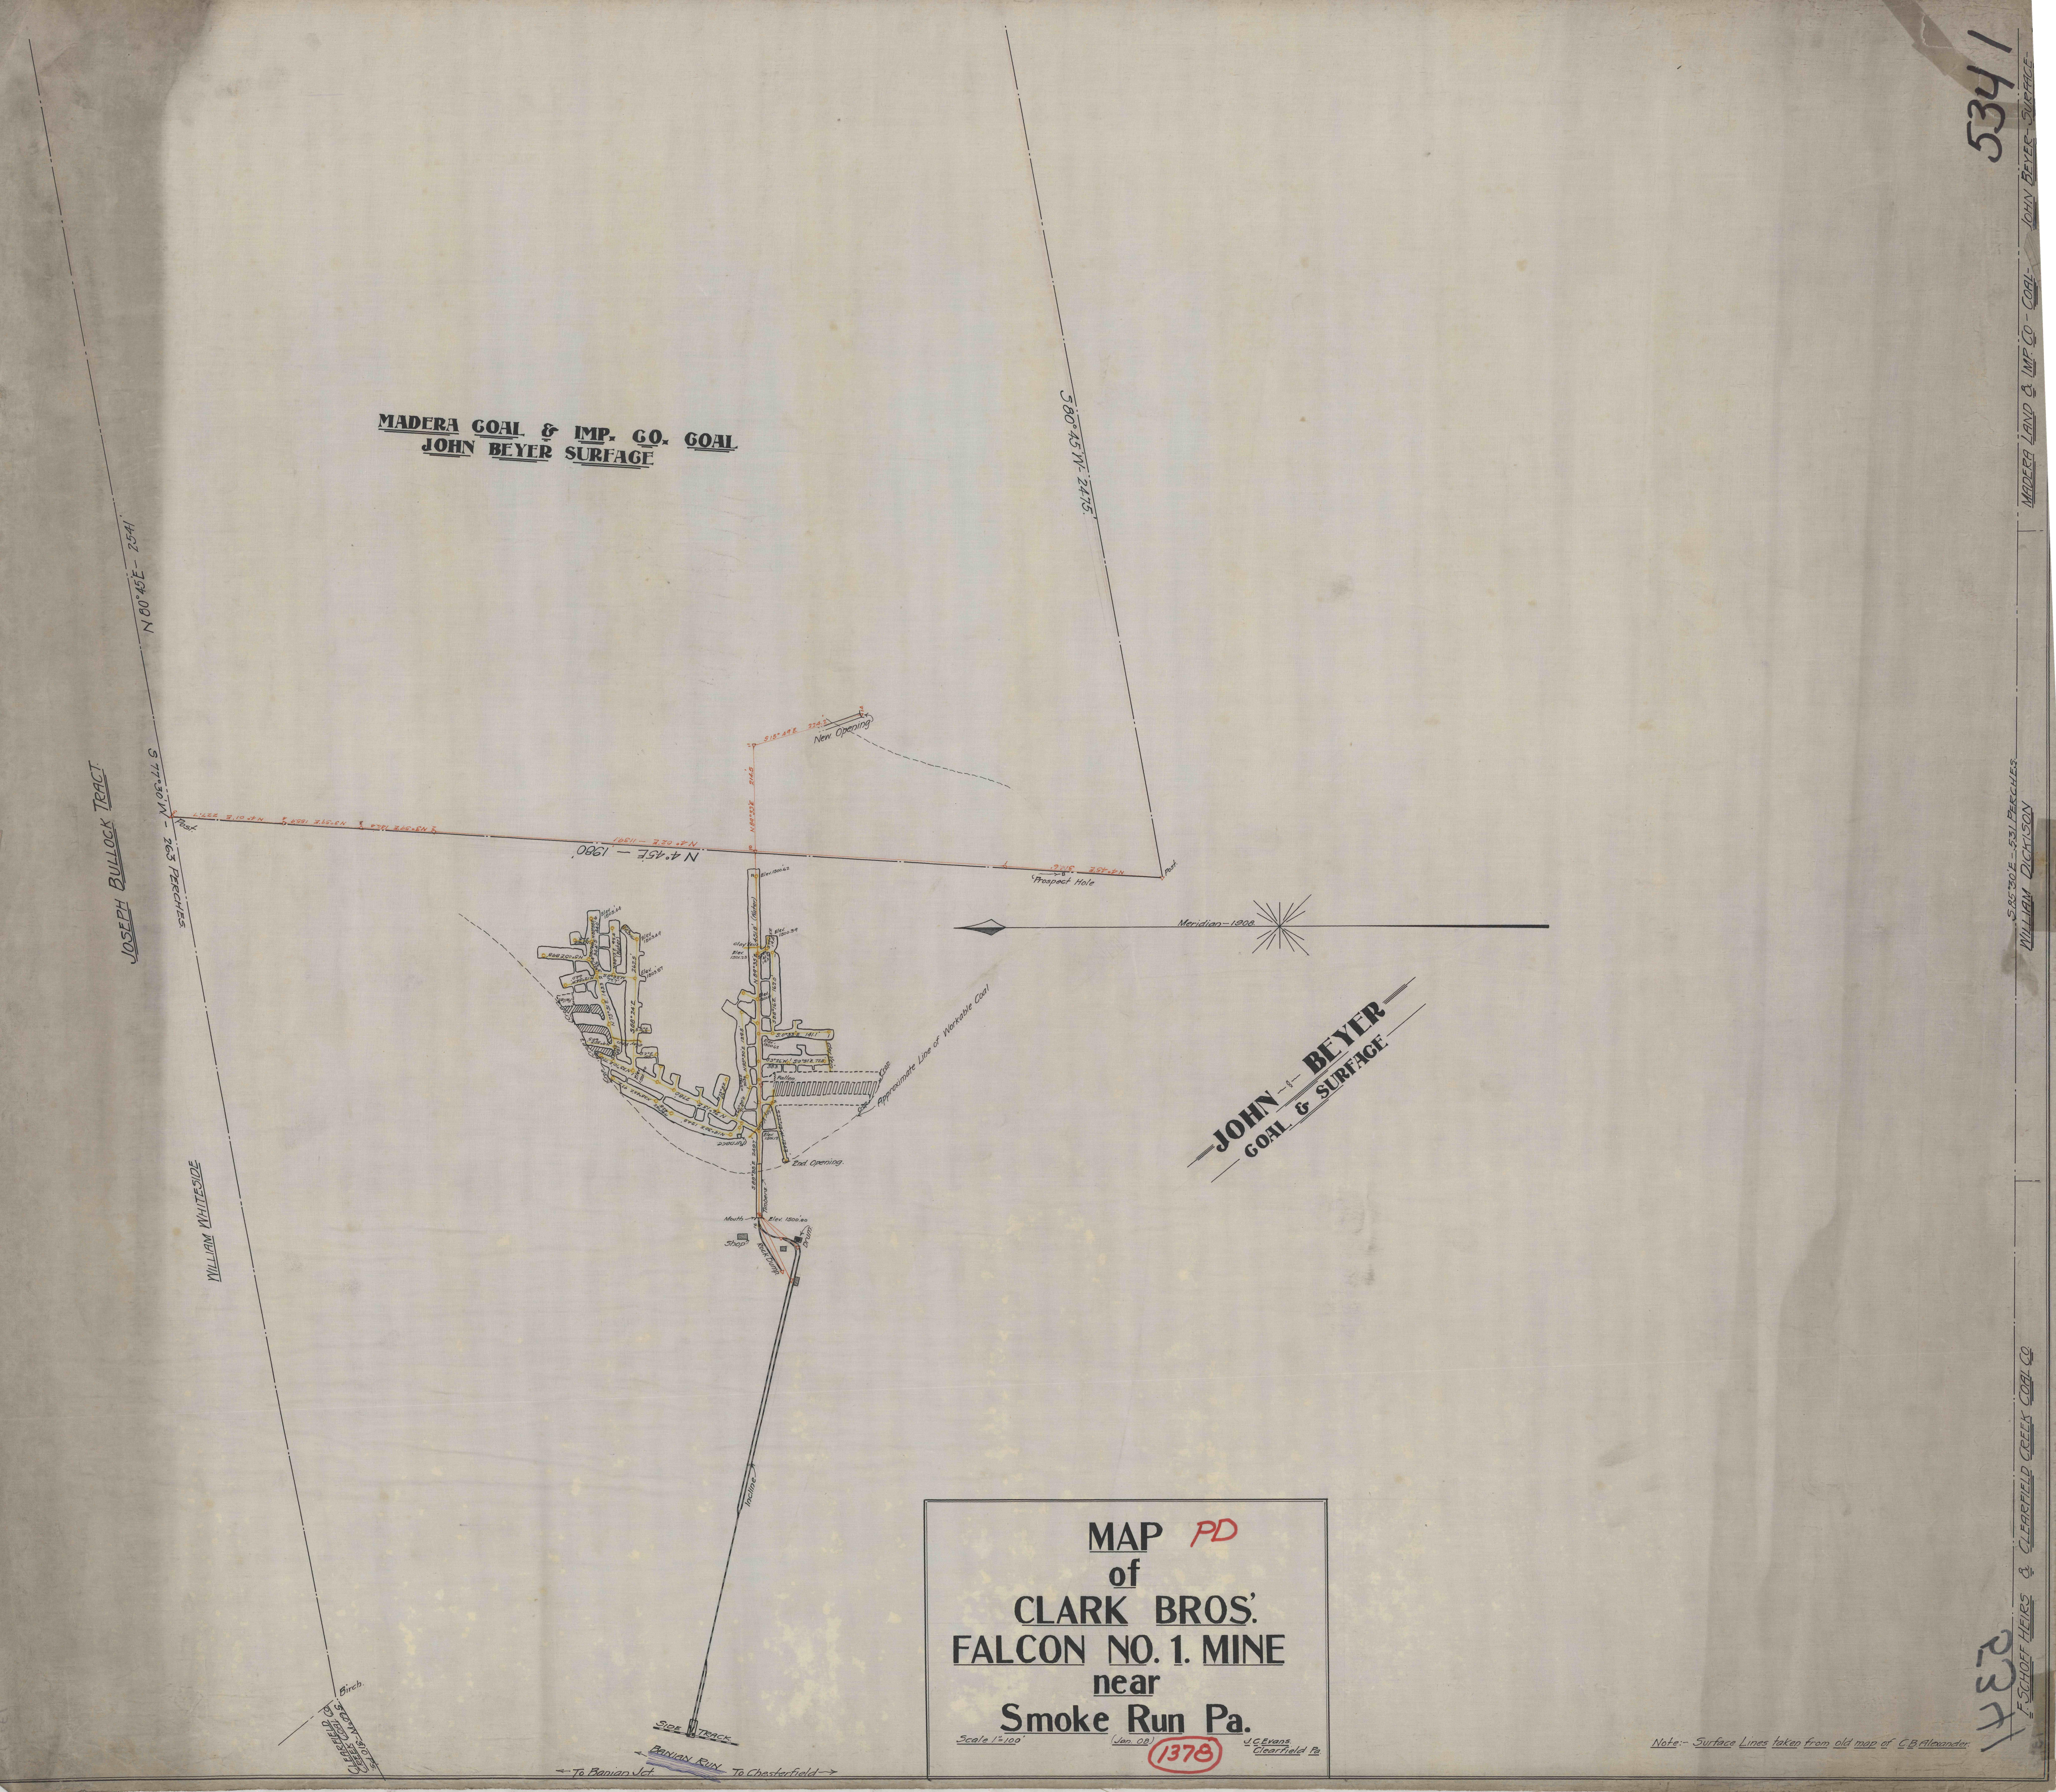
MAP PD
of
CLARK BROS.
FALCON NO. 1. MINE
near
Smoke Run Pa.
Scale 1"=100'
(Jan. 08)
1378
J.C. Evans
Clearfield Pa.
MADERA COAL & IMP. CO. COAL
JOHN BEYER SURFACE
JOHN BEYER
COAL & SURFACE
JOSEPH BULLOCK TRACT
N 80°45'E - 2541'
S 77°30'W - 263 PERCHES.
WILLIAM WHITESIDE
CLEARFIELD CREEK COAL CO.
S 4°01'E - 140 P.
Birch.
Post.
N 4°45'E - 1980'
N 4° 02'E - 1139.1
N 4° 01'E 227.1
N 3°59'E 155.9
N 3°59'E 126.6
S 80°45'W - 2475'
N 4°45'E 314.6
Post.
Prospect Hole
S 15° 49'E 224.2
214.5
N 89°33'E
New Opening
Meridian - 1908.
Elev. 1500.62
251.8' (Water)
Clay Vein
Elev. 1501.23
Elev. 1500.39
N 89°35'E
S 88°16'E 162.0
S 0°33'E 141.1
Fallen.
Approximate Line of Workable Coal
Furnace
2nd. Opening.
S 89°35'E 249.7
Timbers.
Mouth
Elev. 1500'.00
Shop
Rock Dump.
Drum.
Incline.
SIDE TRACK.
BANIAN RUN
← To Banian Jct.
To Chesterfield →
Elev. 1505.44
Elev. 1503.49
Elev. 1503.57
N 5°05'E 84.8
S 88°24'E
N 75°51'E
N 19°30'E 124.8
N 72°15'E 278.0
5341
MADERA LAND & IMP. CO. - COAL - JOHN BEYER - SURFACE -
S 85°30'E - 531 PERCHES.
WILLIAM DICKISON
F. SCHOFF HEIRS & CLEARFIELD CREEK COAL CO.
Note:- Surface Lines taken from old map of C.B. Alexander.
R 347