


D
 A. D. Lydic, Mahanoyes
 PLAN
 OF
 Easton Coal Company's Mines
 Mahanoyes, Pa.
 November 12, 1908. Scale 1" = 100'
 SURVEYS CONTINUED NOV. 20, 1915
 E. Y. HESS, ENGINEER.
 CLEARFIELD, PA.

RE-SURVEYS :-

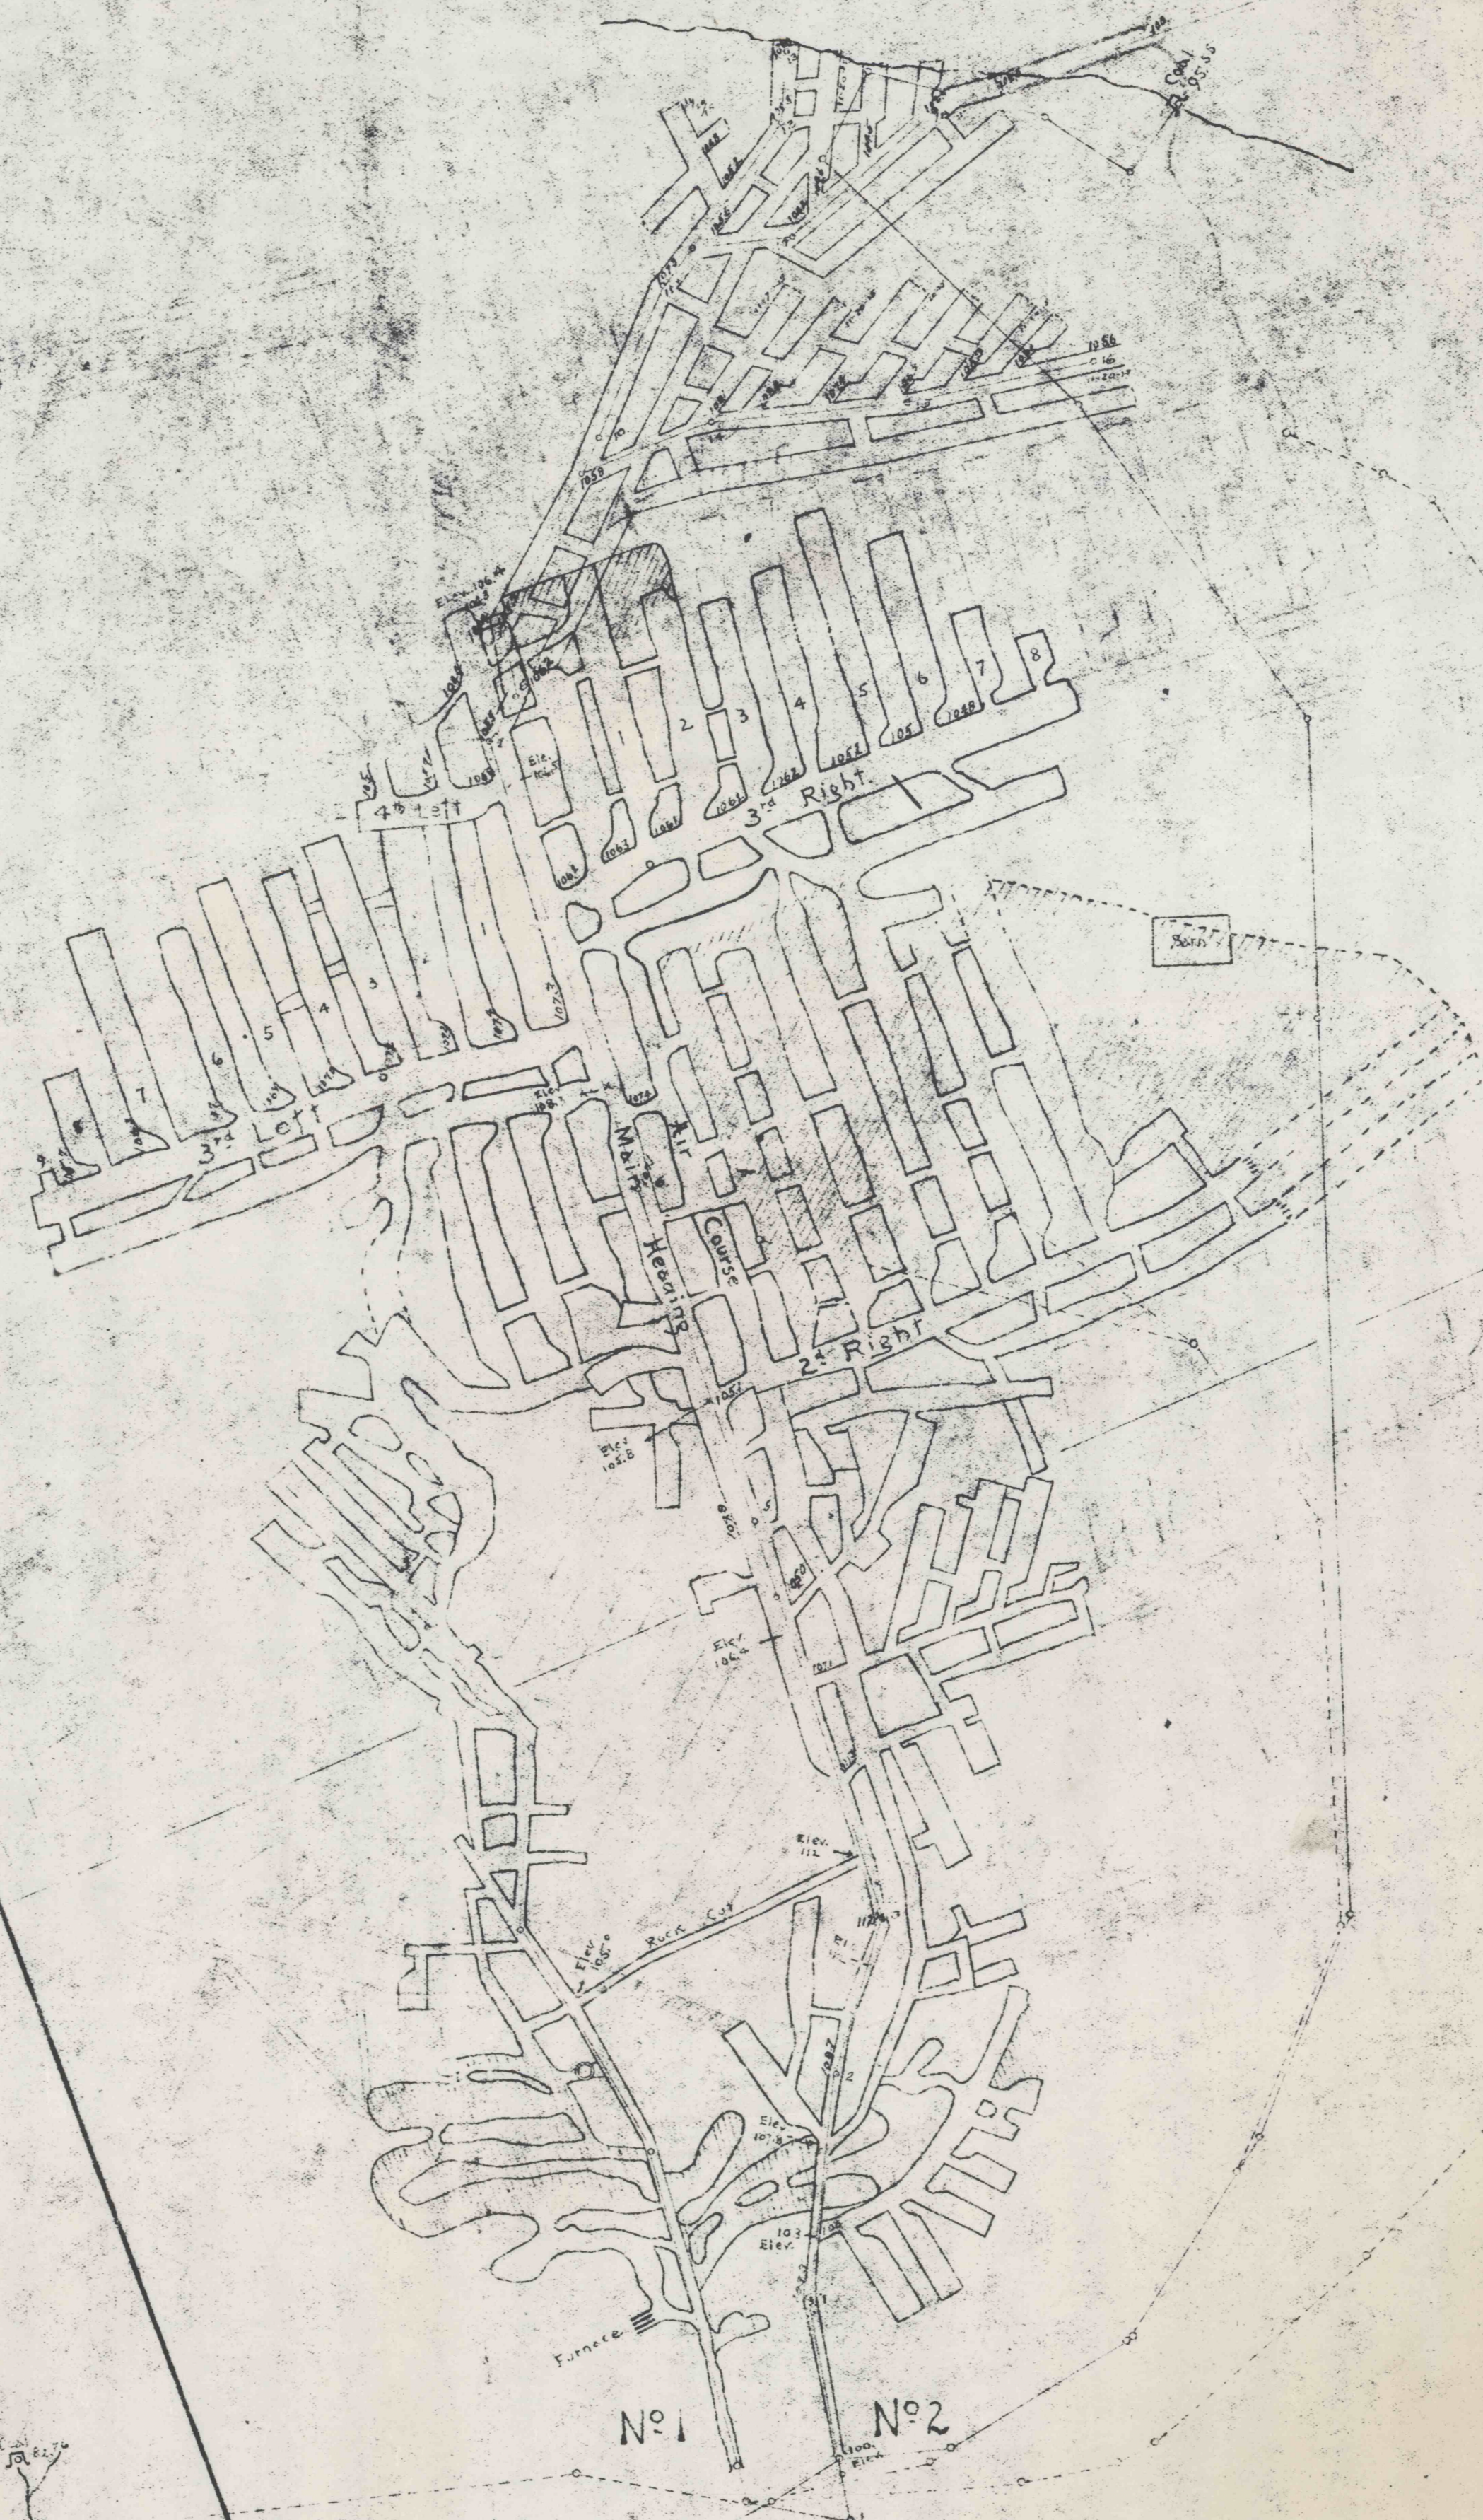

Susquehanna River

Chest Creek

5346
 5347
 5348
 5349

5346
5347