

E. H. HUGHES

D  
MAP OF  
RODEN COAL CO'S

OPERATION  
ON  
DANIEL AYRES ES'T  
CLEARFIELD CO, PA.  
1921.

Scale 1"=100'


Geo. H. Ayres Engineer  
Hillsburg, Pa.

SURVEYED TO

DEC-6 <sup>th</sup> 1922
JUNE 1923
FEB-9 <sup>th</sup> 1924
MAY 22 <sup>nd</sup> 1924

R. D. SHOWALTER ES'T

PHILIPS

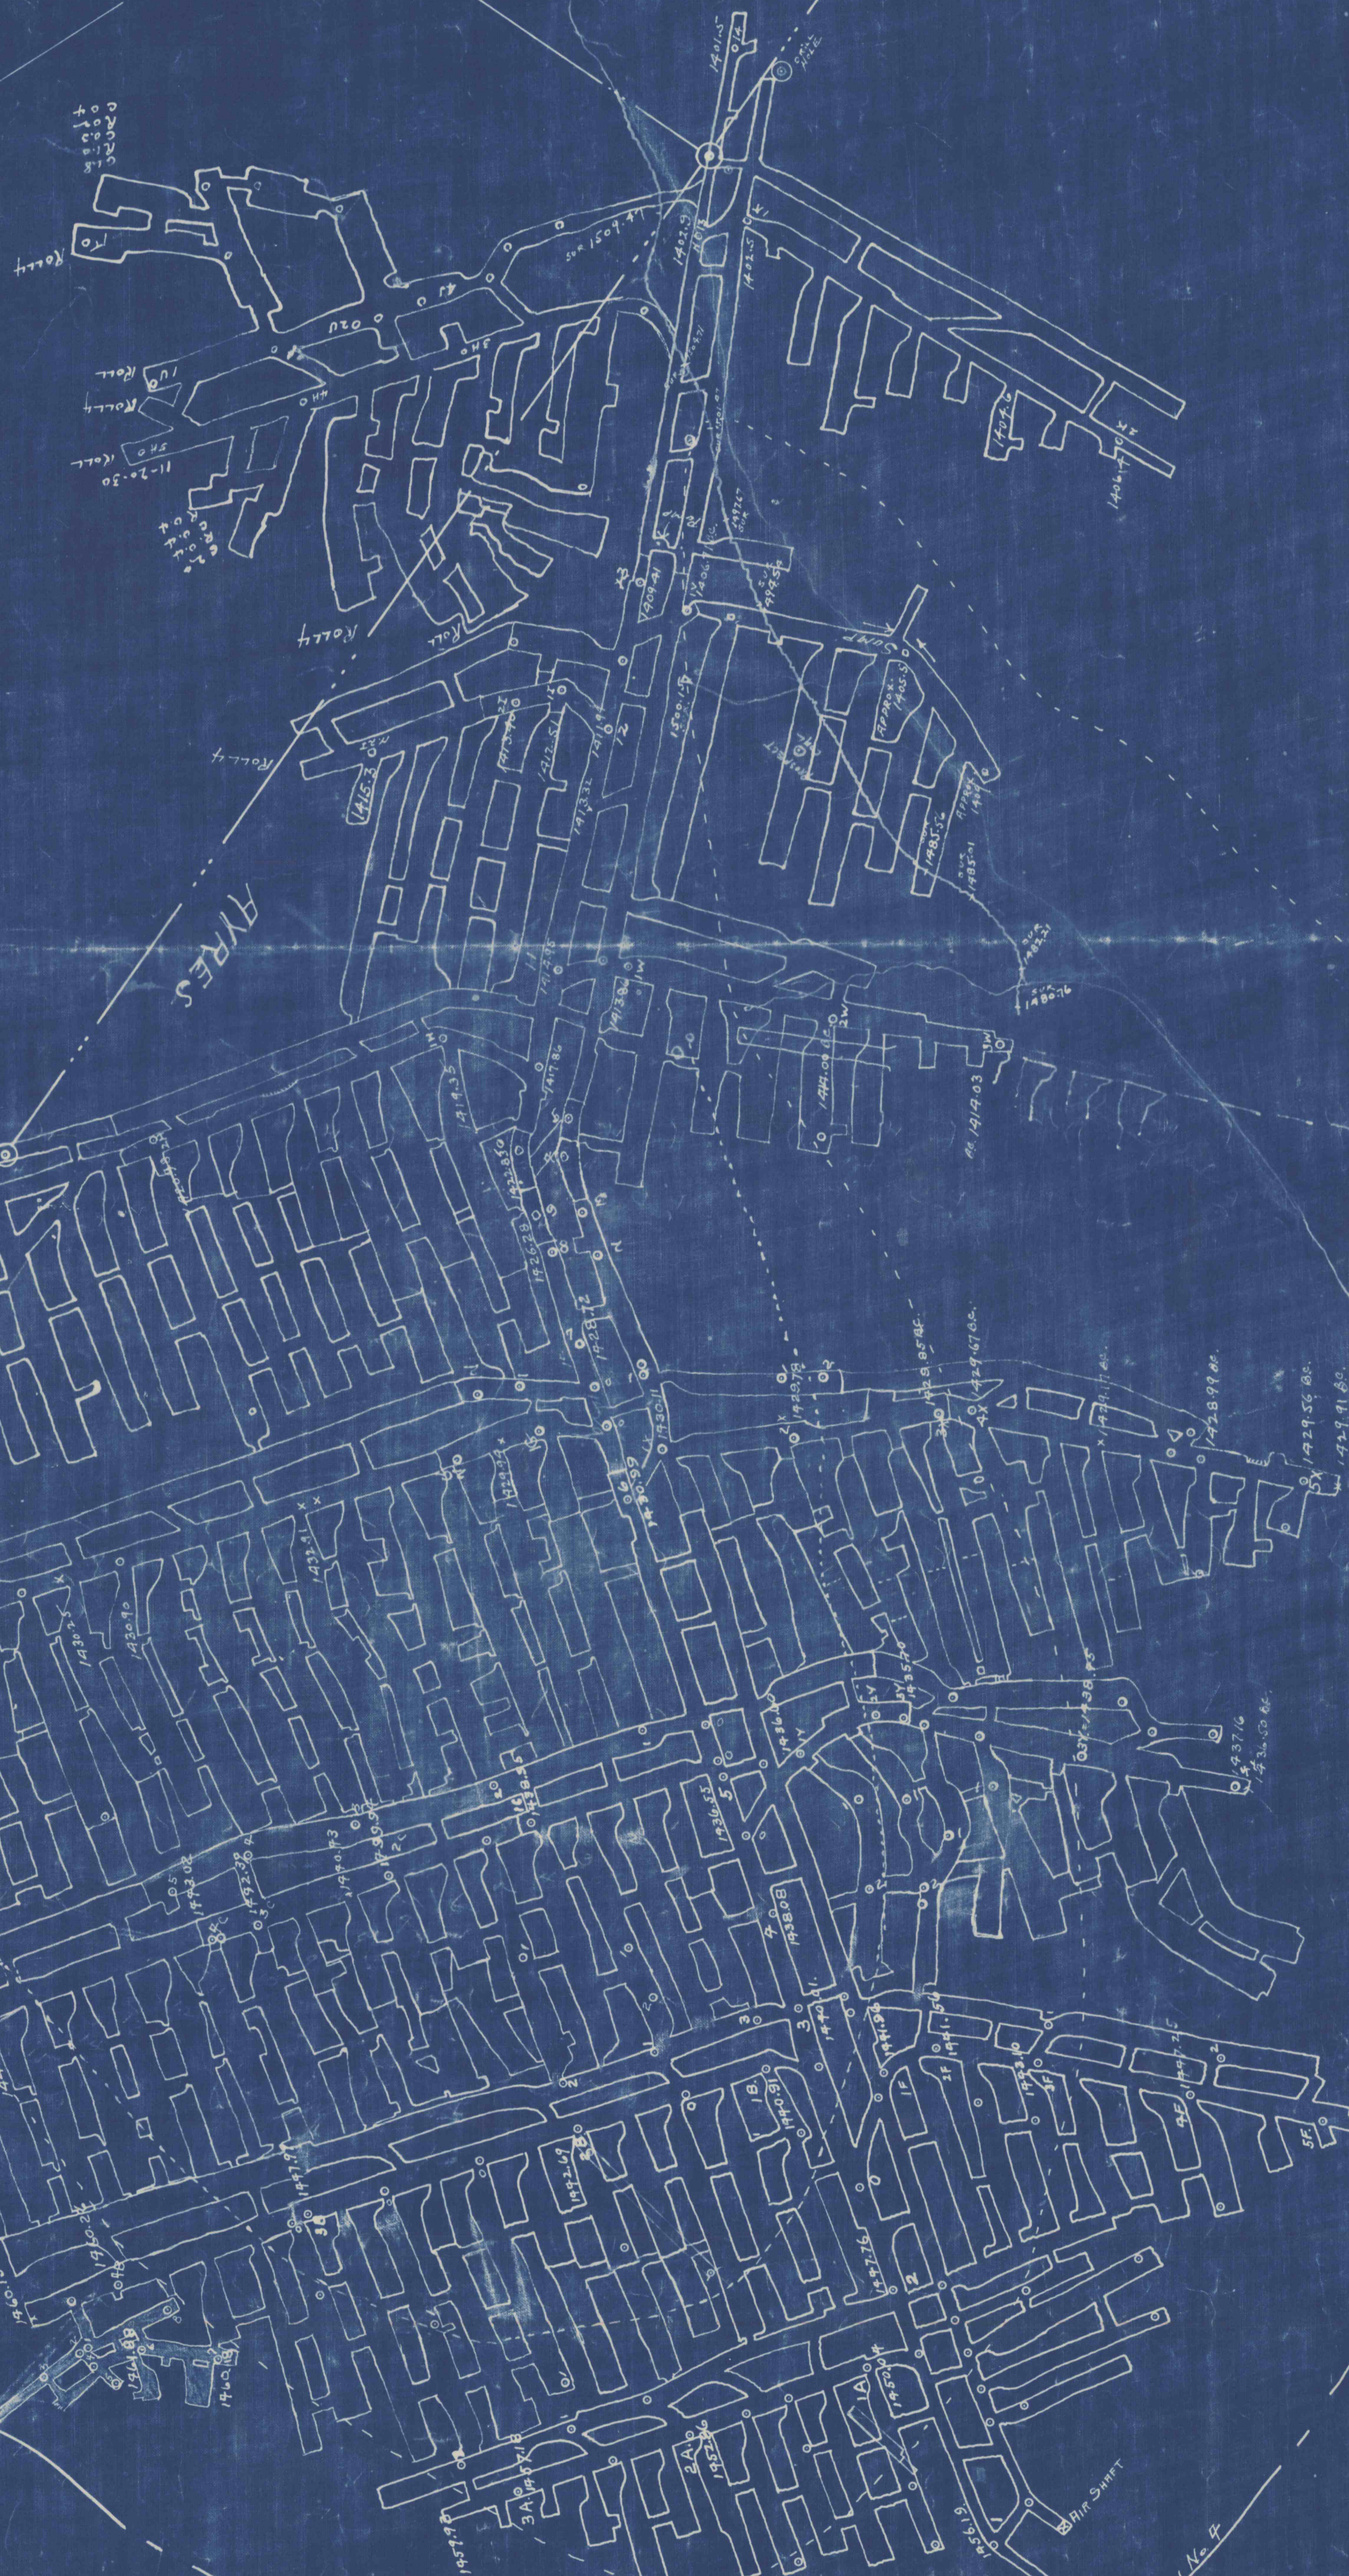

R. C. HALE ES'T

RODEN No-2  
1923.37

RODEN No-1  
1922.50

DANIEL AYRES ES'T

BEAVER

BEAVER RUN

5377