


5395

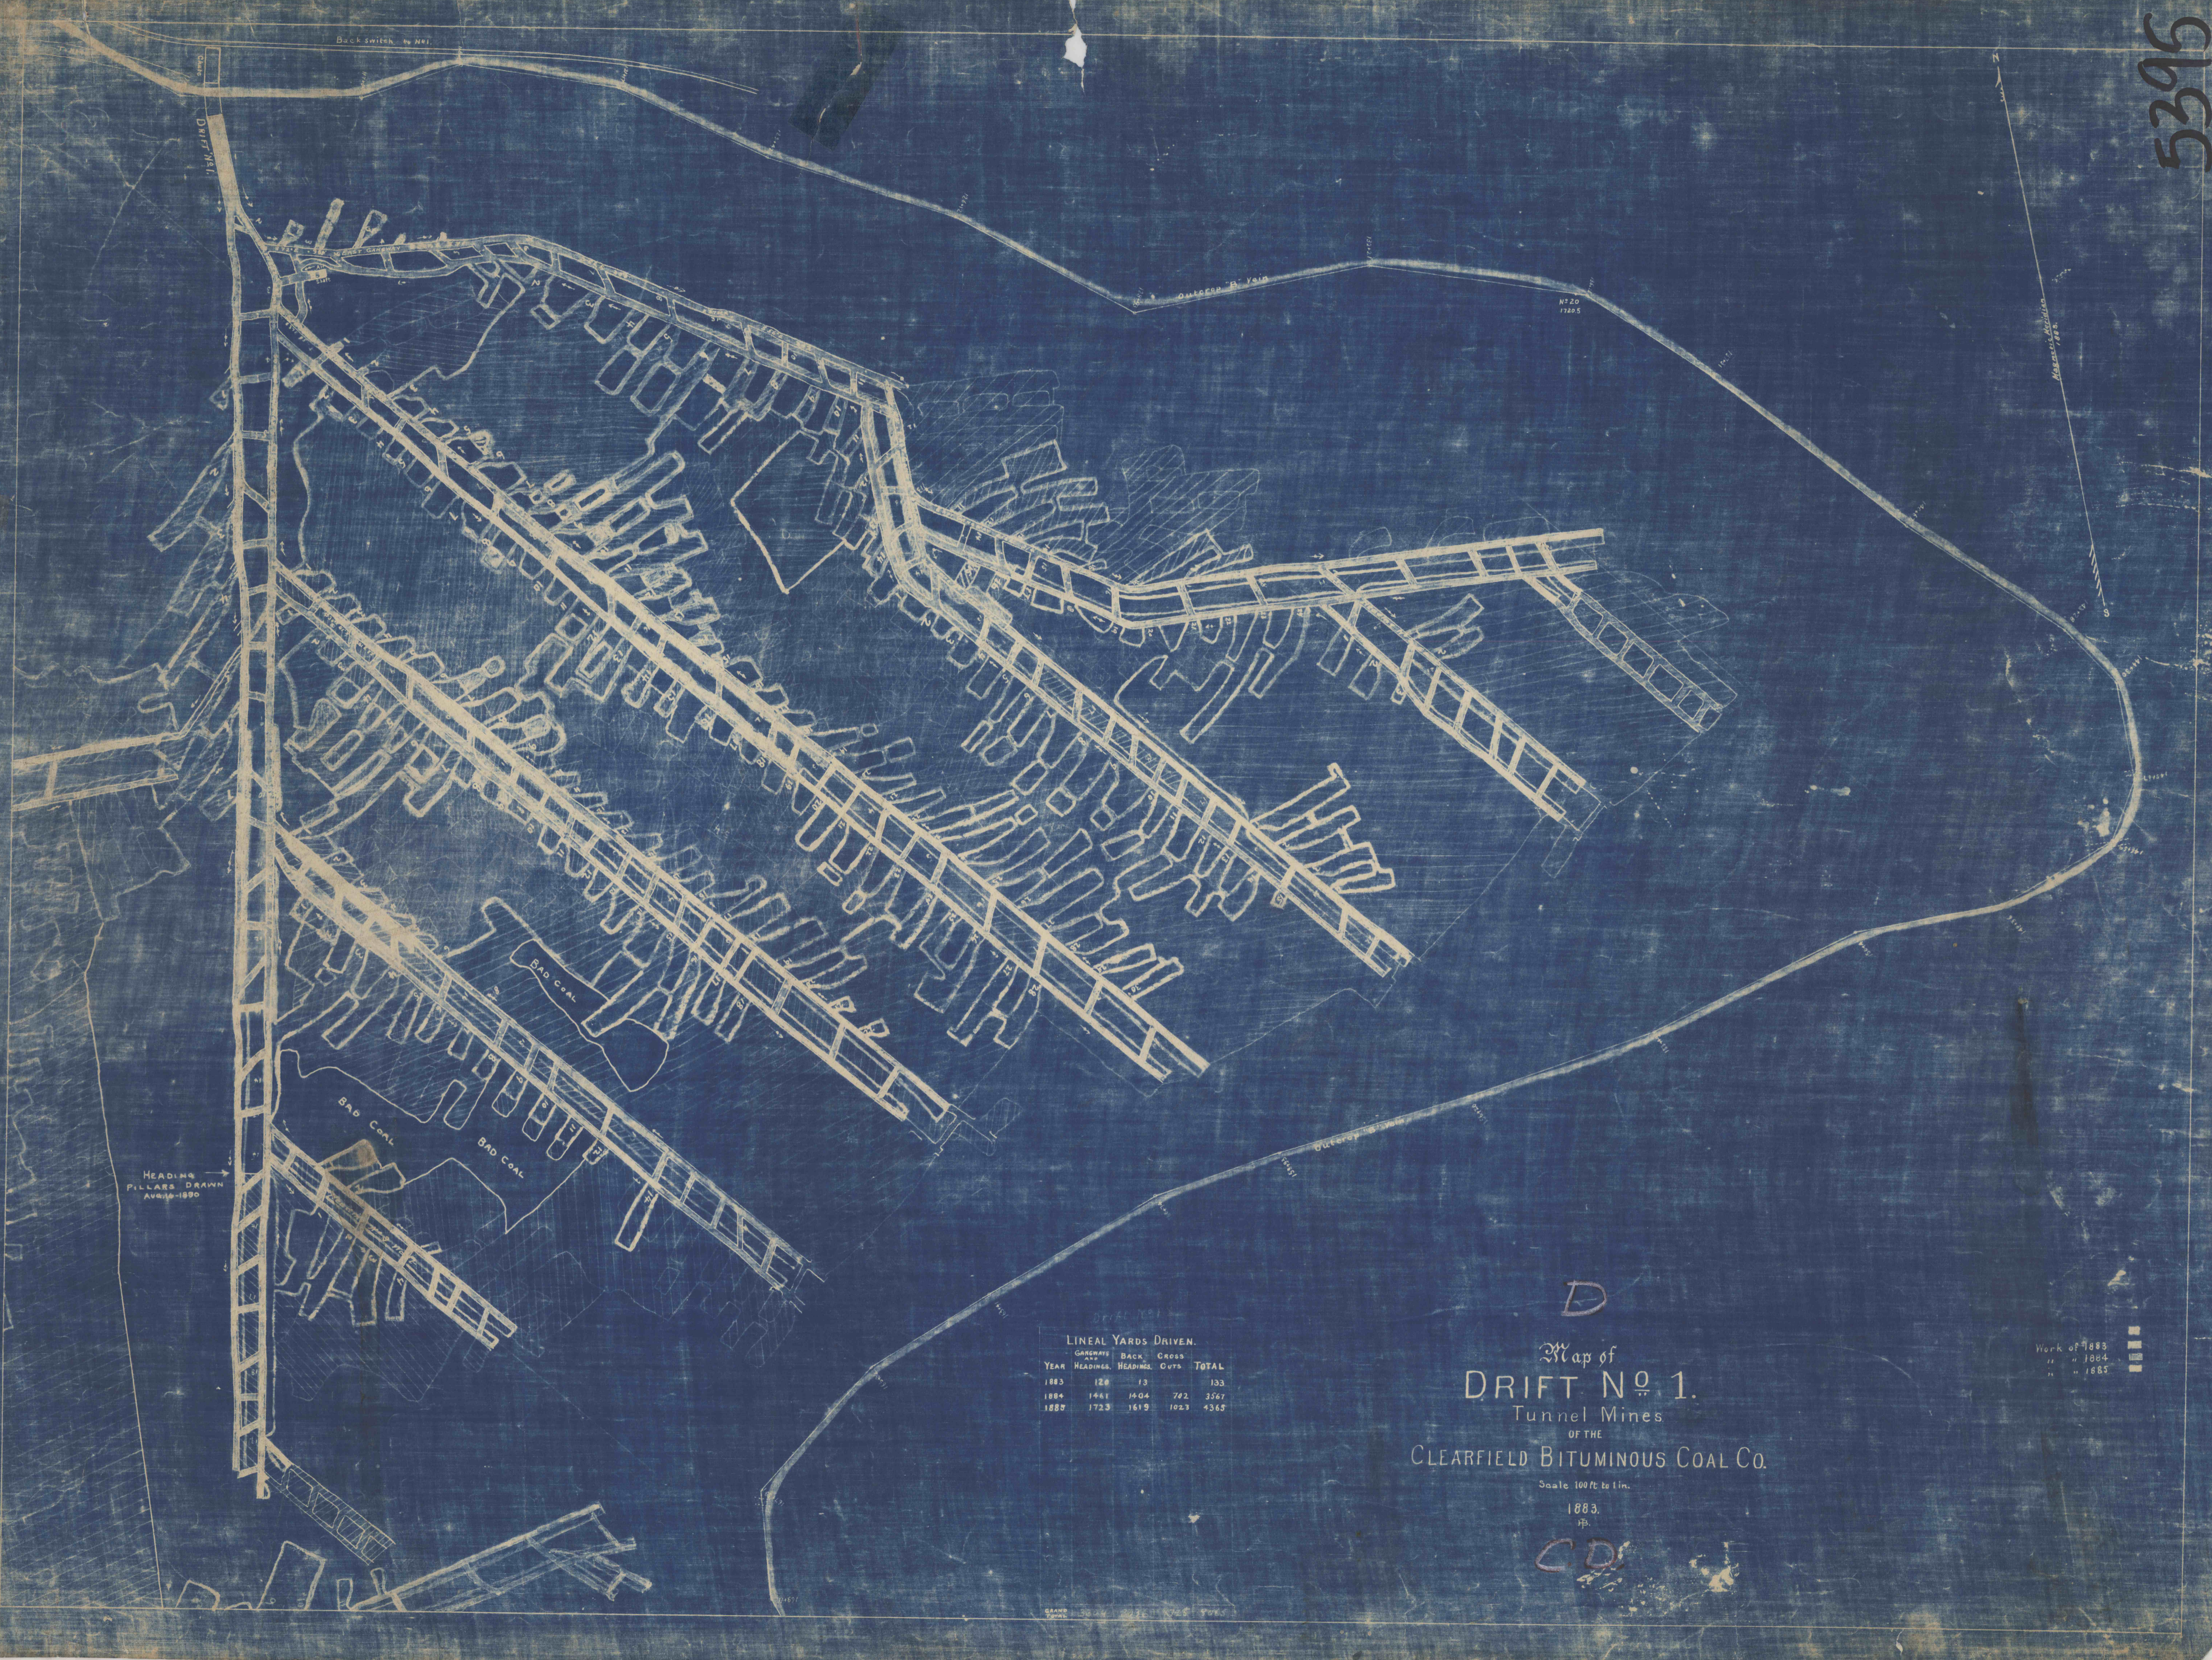

LINEAL YARDS DRIVEN.

YEAR	GARRETT HEADINGS	BACK HEADINGS	CROSS CUTS	TOTAL
1883	126	13		133
1884	1461	1404	762	3567
1885	1723	1619	1023	4365

D

Map of
DRIFT No. 1.
 Tunnel Mines
 OF THE
CLEARFIELD BITUMINOUS COAL CO.

Scale 100 ft to 1 in.
 1885.
 J.P.

CD

Work of 1883
 " " 1884
 " " 1885