


J. R. NORRIS FARM
M. A. CALDWELL - COAL

ISAAC CALDWELL

F. NORRIS

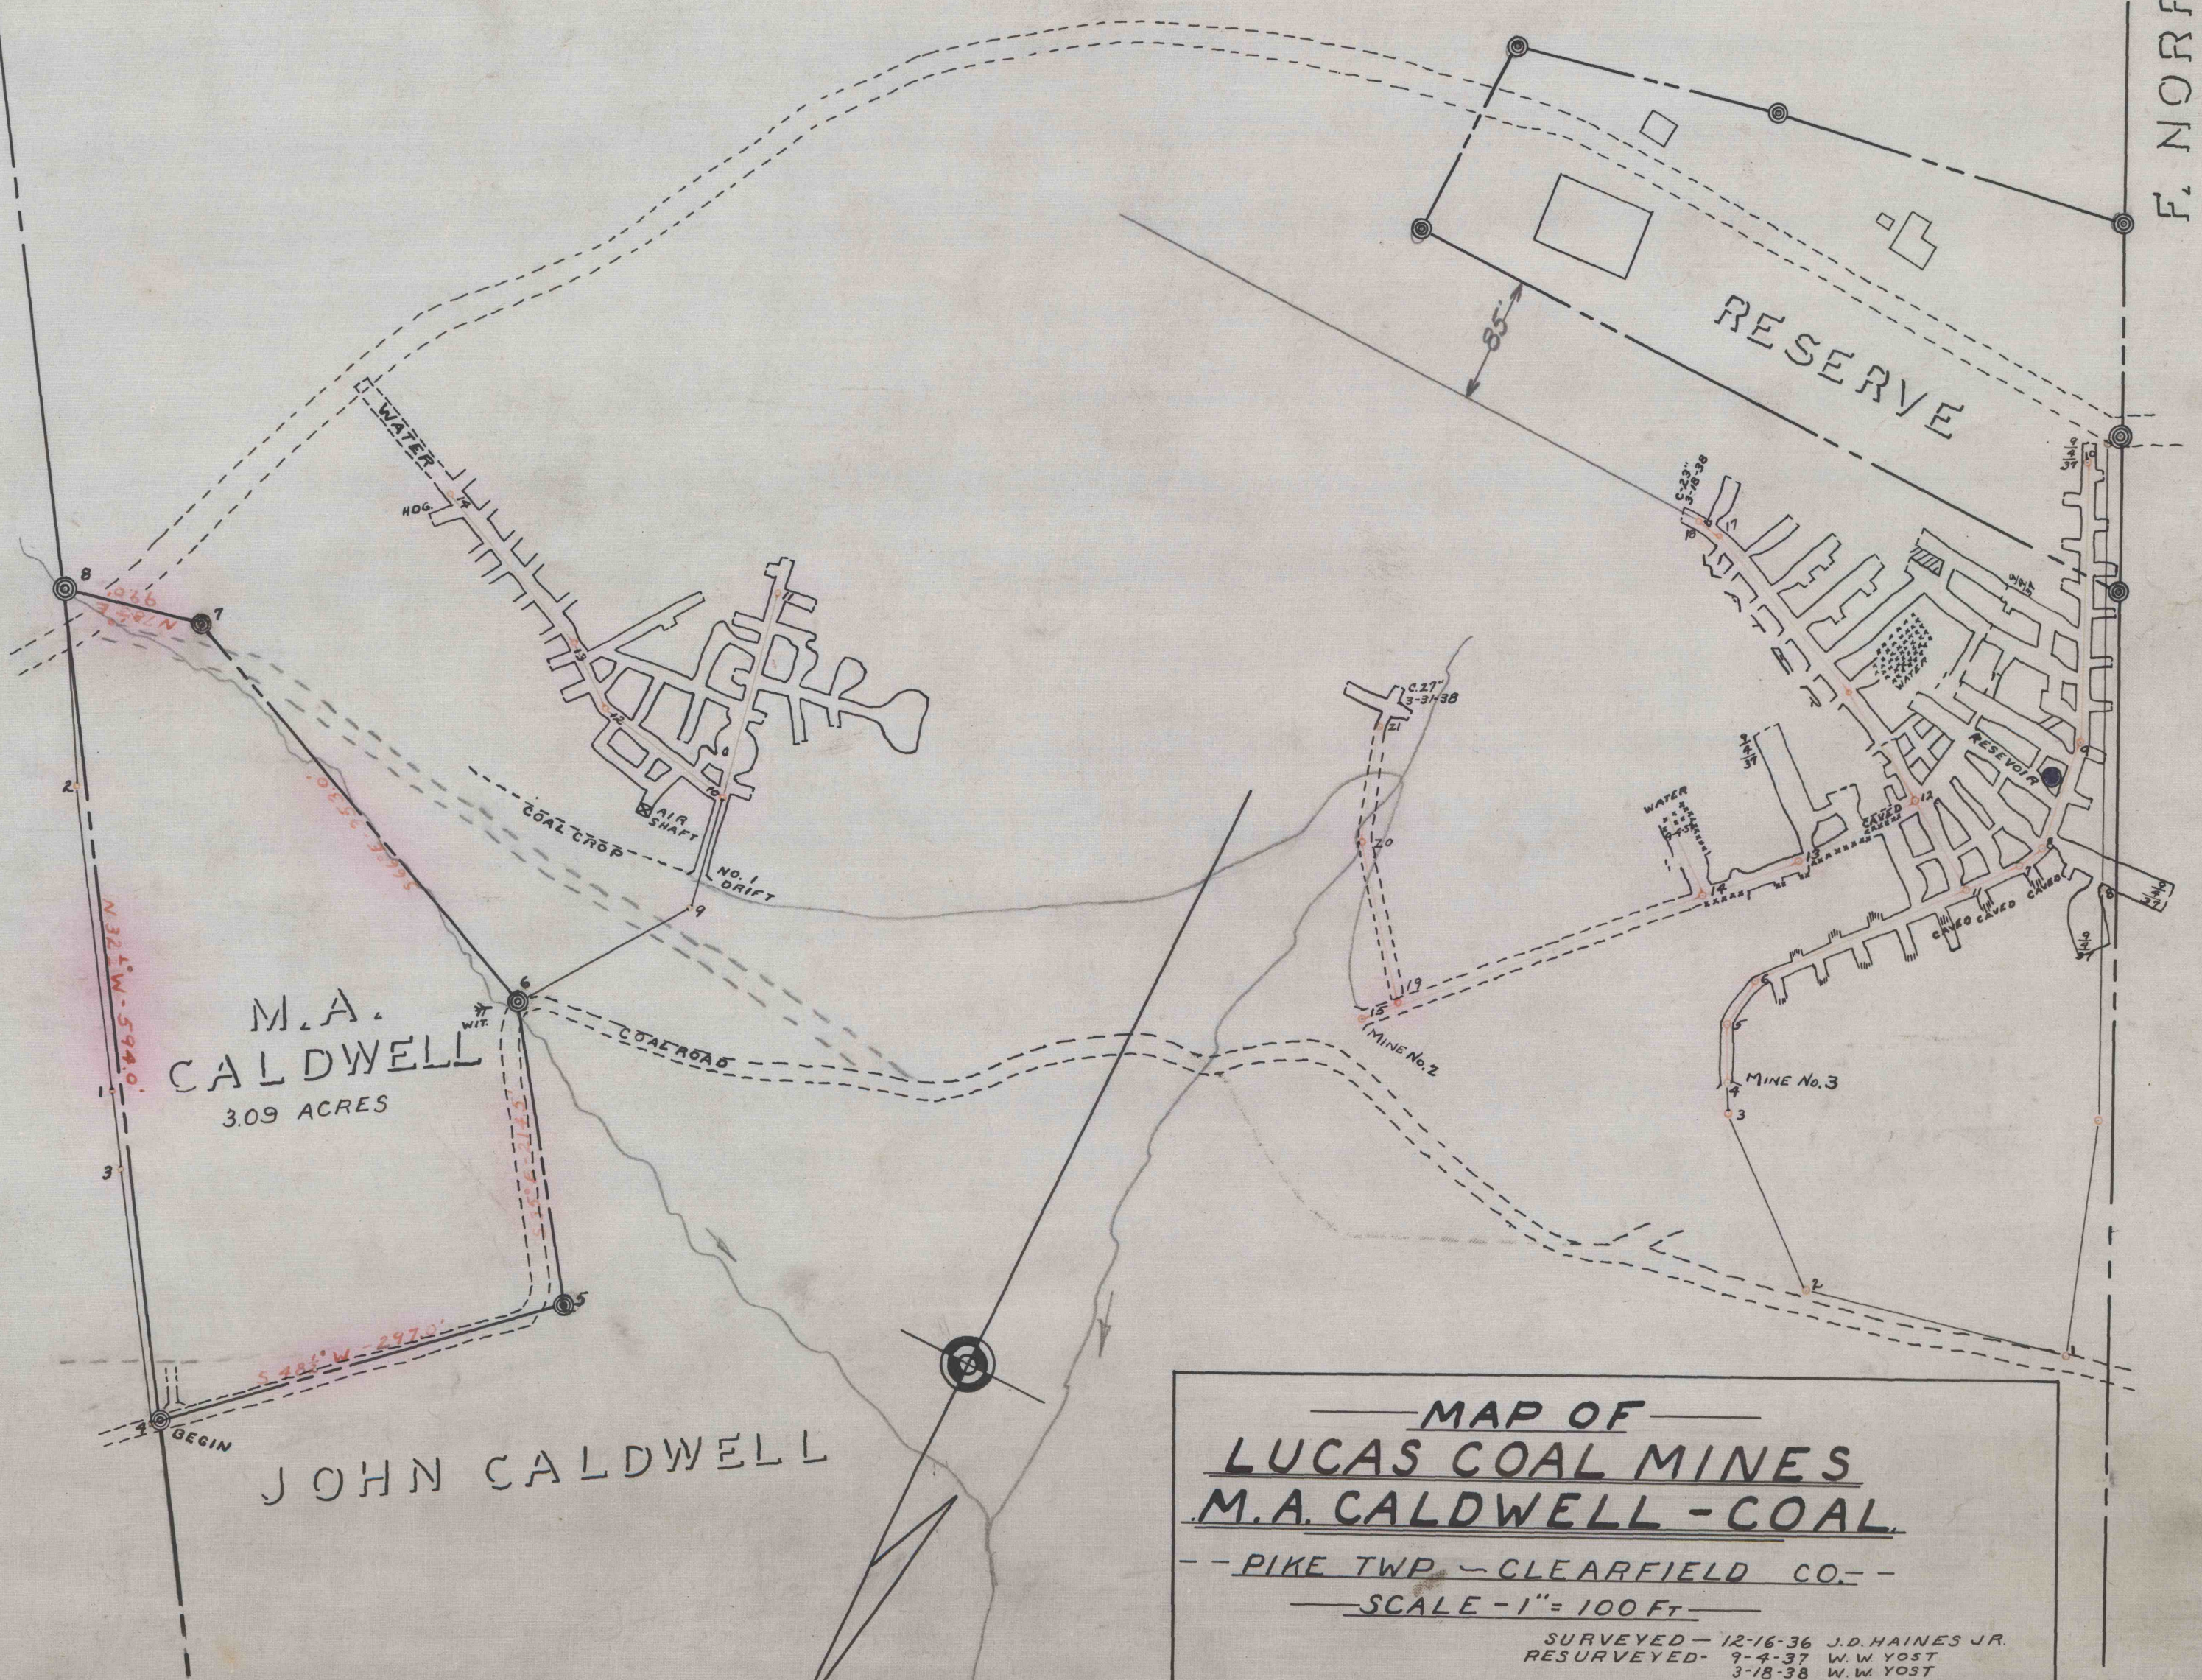

MAP OF
LUCAS COAL MINES
M. A. CALDWELL - COAL
-- PIKE TWP - CLEARFIELD CO. --
SCALE - 1" = 100 FT.
SURVEYED - 12-16-36 J. D. HAINES JR.
RESURVEYED - 9-4-37 W. W. YOST
 3-18-38 W. W. YOST
DRAWN BY - *W.W.* INDEX - 54-2-22
CHECKED BY - *R.S.A.* DATE - MARCH 22, 1938