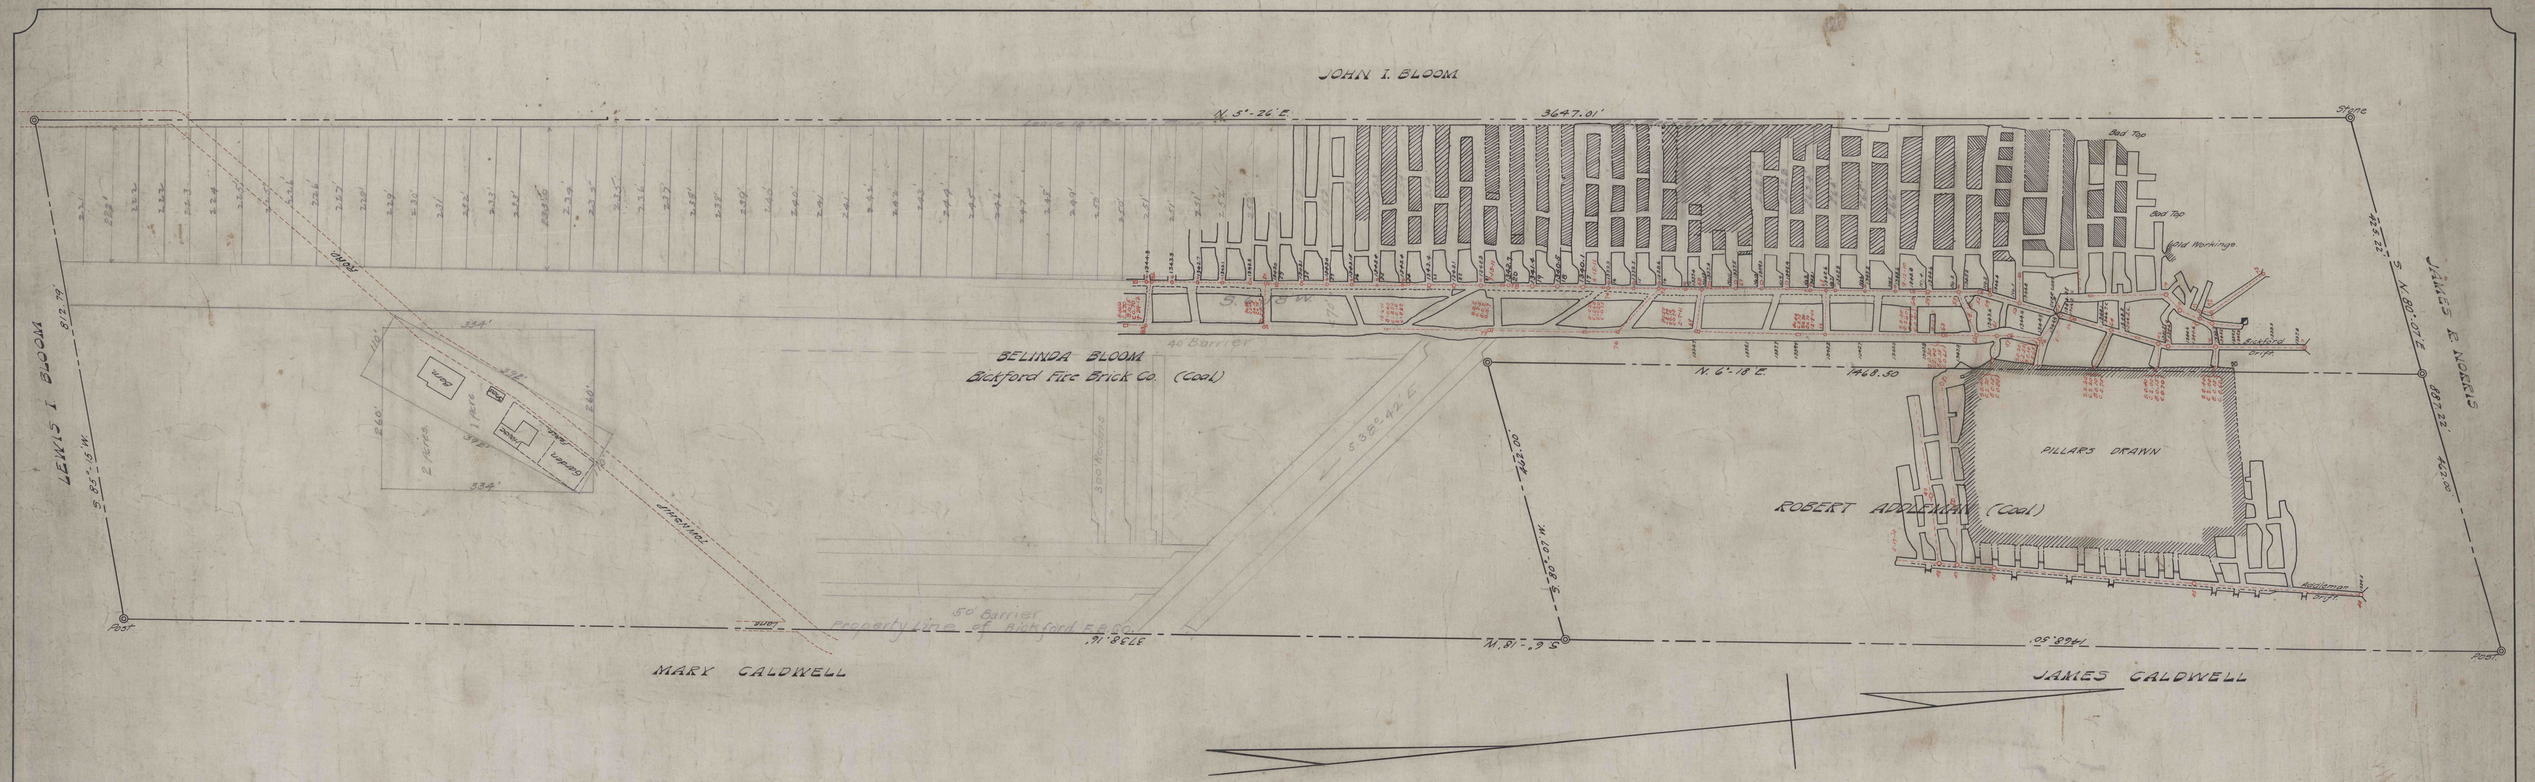


MAP OF COAL MINE

OPERATED BY

BICKFORD FIRE BRICK COMPANY

Curwensville, Pa.

Scale 1"-100'. May-1910.

-N-
3003

W. J. Hinterleitner Engineer

54-2-4