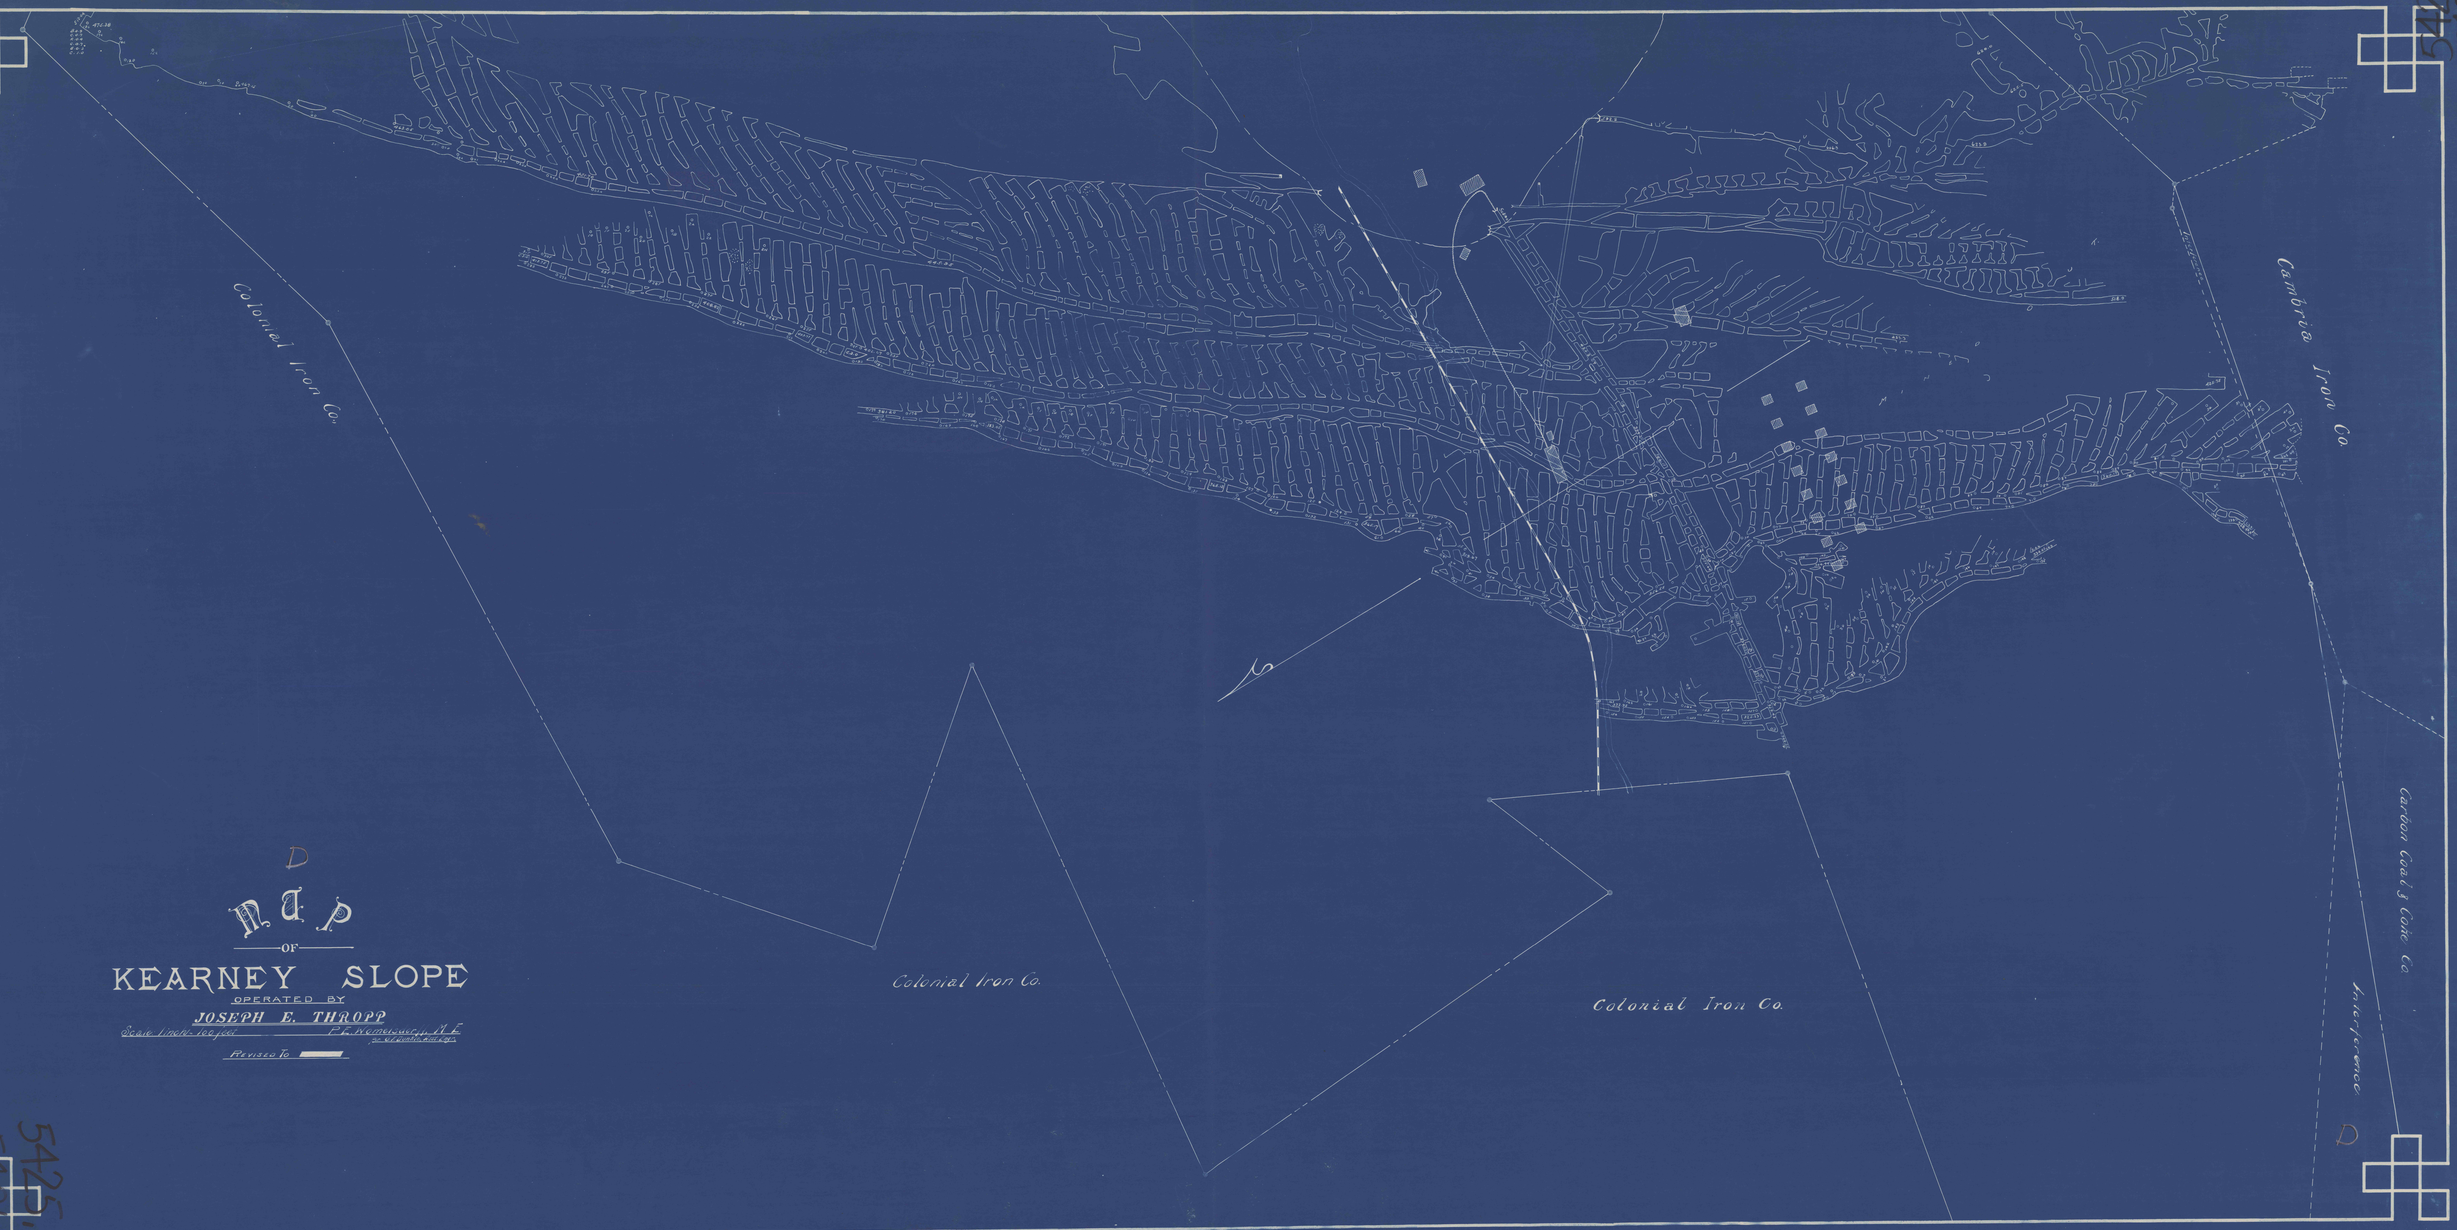

MAP
OF
KEARNEY SLOPE
OPERATED BY
JOSEPH E. THROPP

Scale 1 inch = 100 feet — P. H. Weinsweig, M. E. Surveyor

Revised To _____

5425
5426