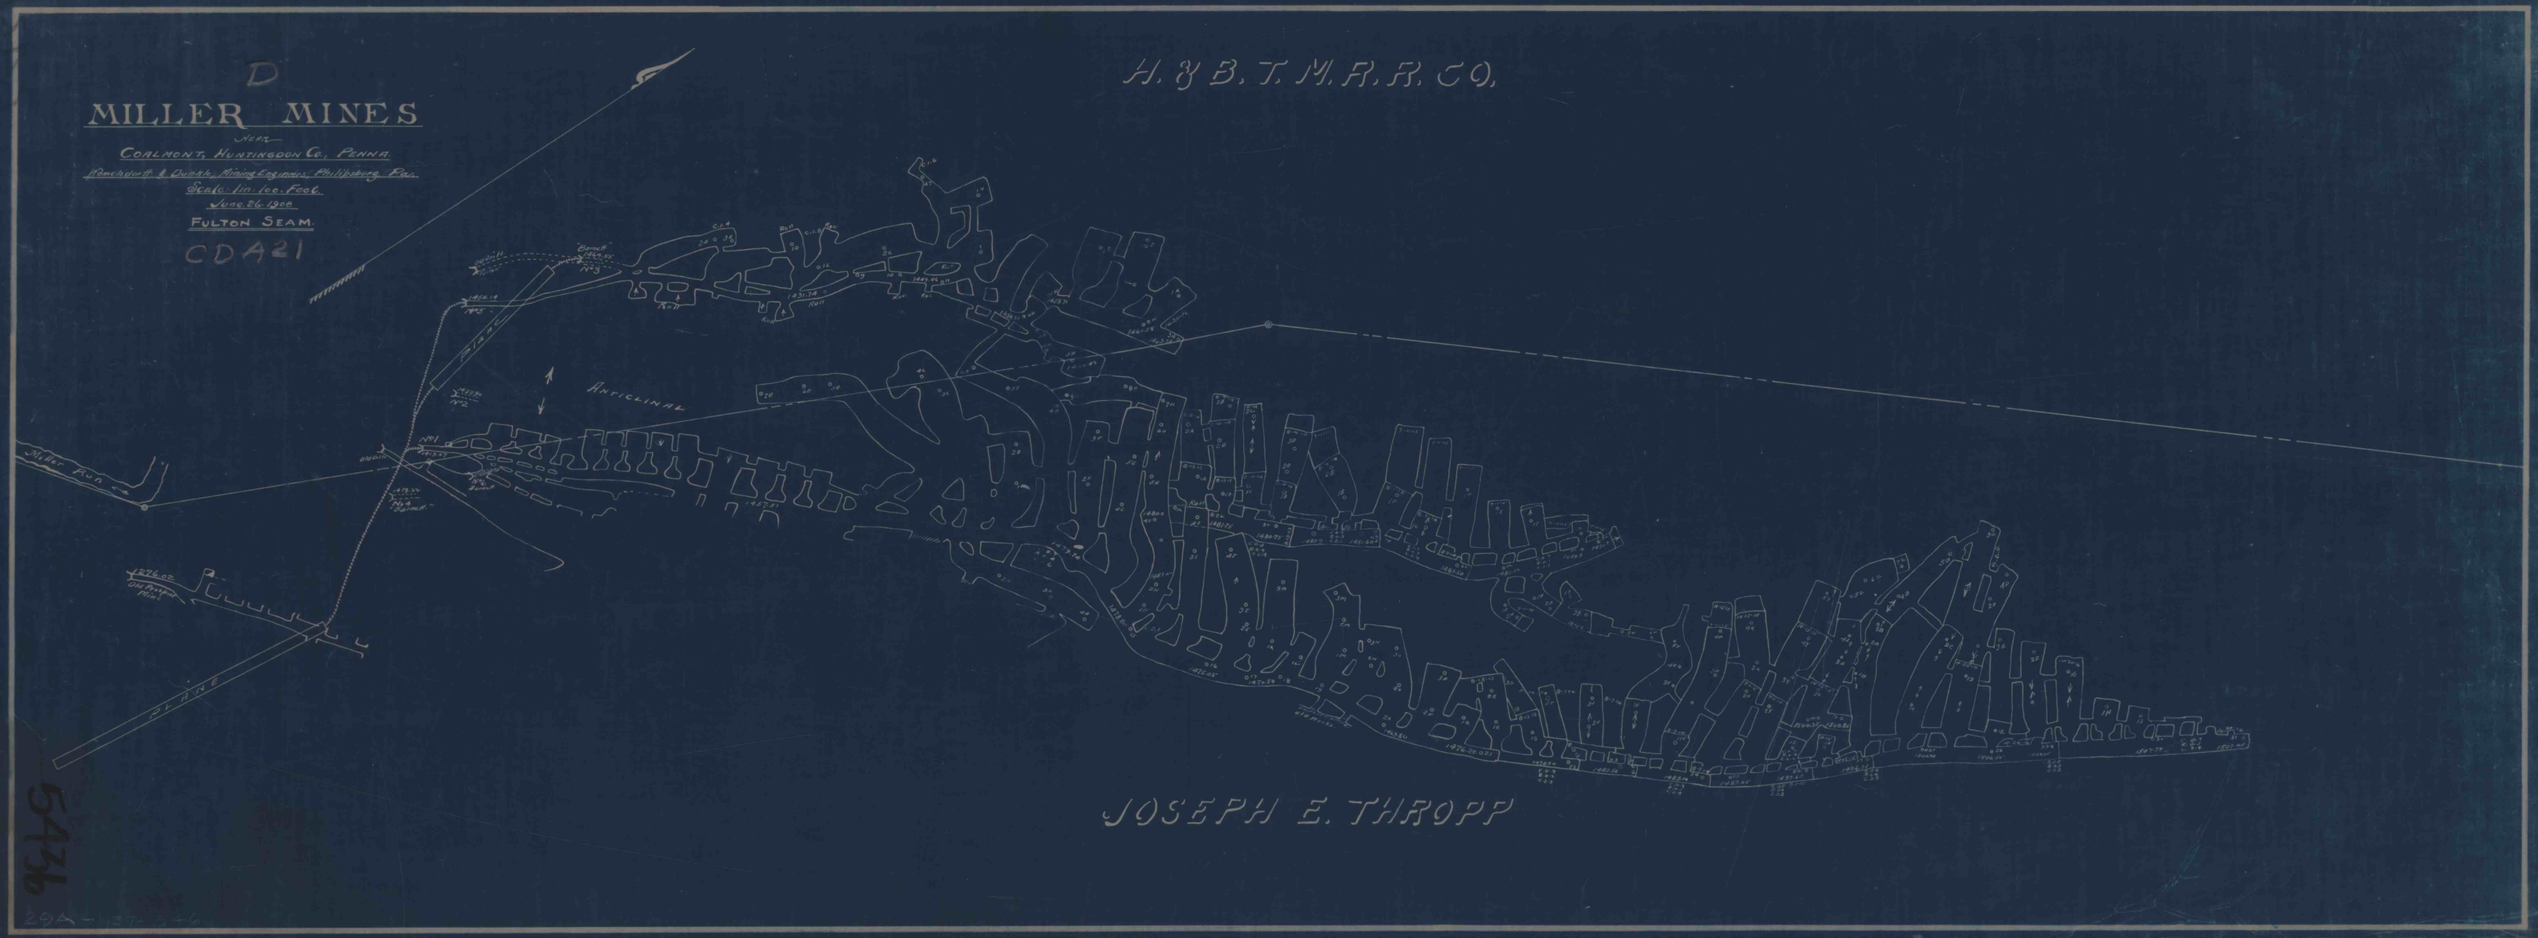
D
MILLER MINES
NEAR
COALMONT, HUNTINGDON CO., PENNA.
Hanchdorff & Dunkle, Mining Engineers, Philipsburg, Pa.
Scale: 1 in. 100 Feet.
June 26 1908
FULTON SEAM.
CDA21
H. & B. T. M. R. R. CO.
ANTICLINAL
Miller Run
PLANE
JOSEPH E. THROPP
5436