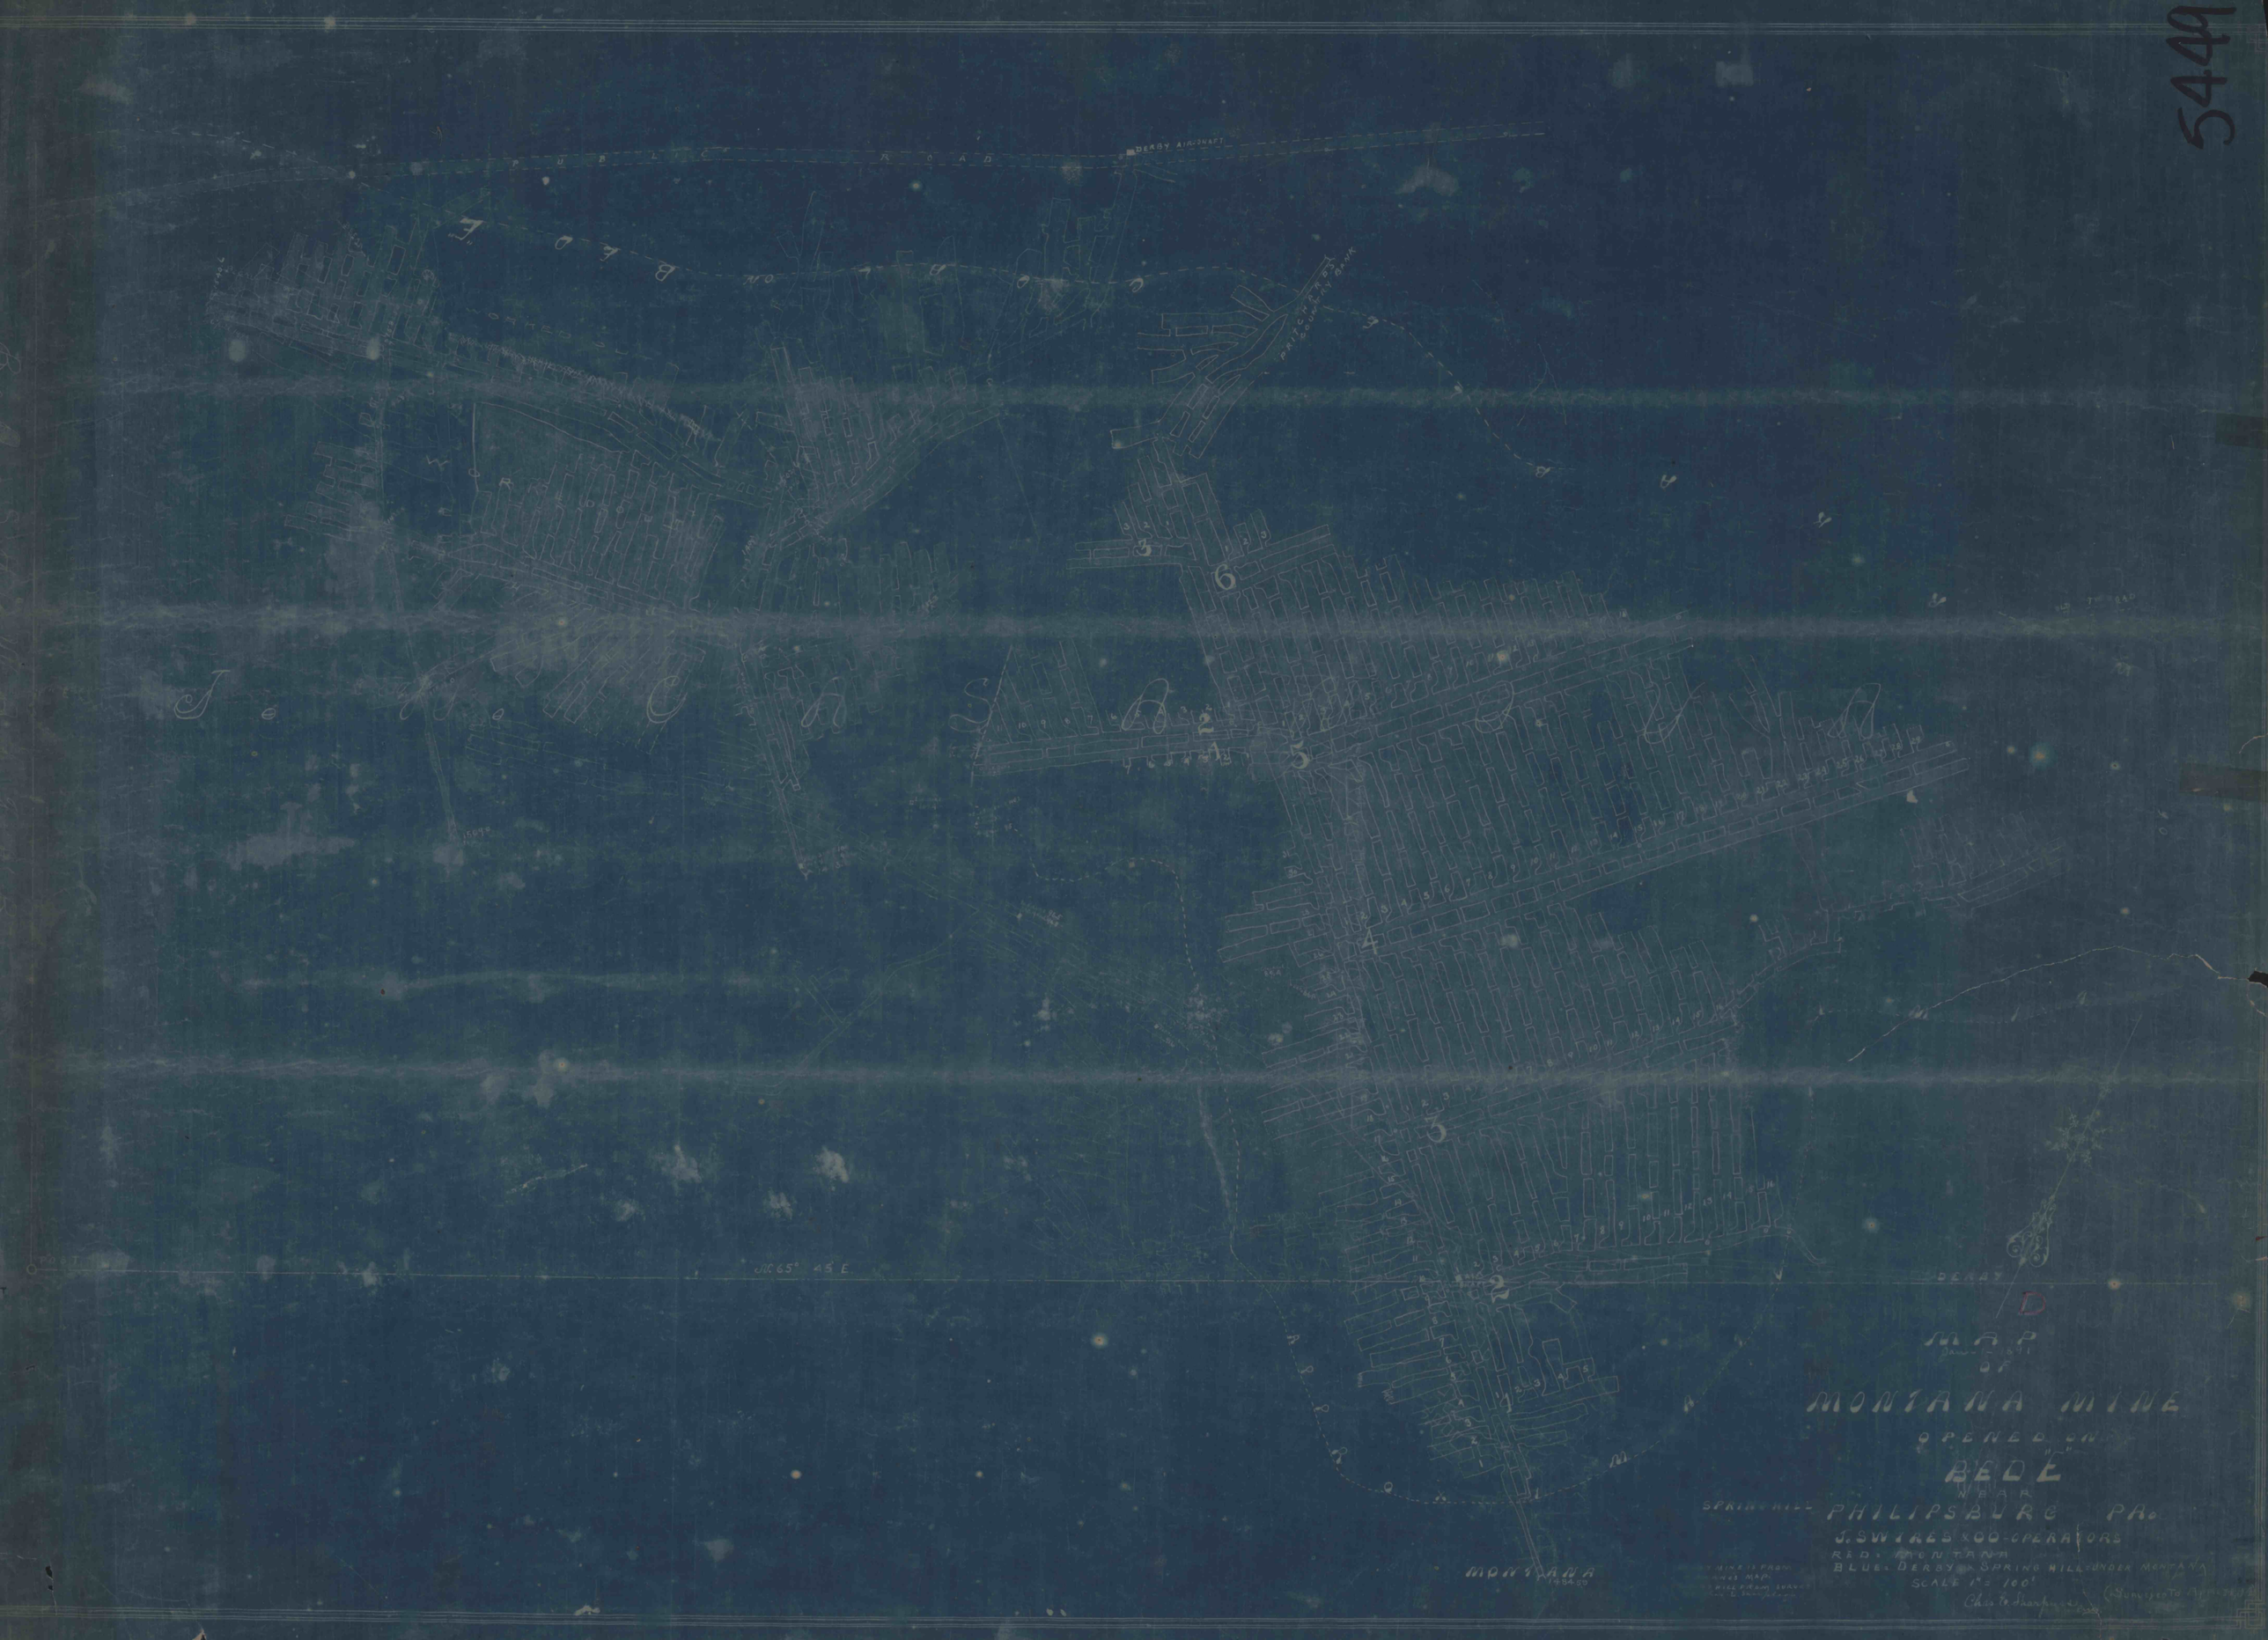
5449
MAP
OF
MONTANA MINE
OPENED ON
"E"
BEDE
NEAR
PHILIPSBURG PA.
J. SWIRES & CO-OPERATORS
RED: MONTANA
BLUE: DERBY & SPRING HILL = UNDER MONTANA
SCALE 1" = 100'
Chas. E. Sharpless
(Surveyed to Approx.)
MONTANA
DERBY
D
N 65° 45 E