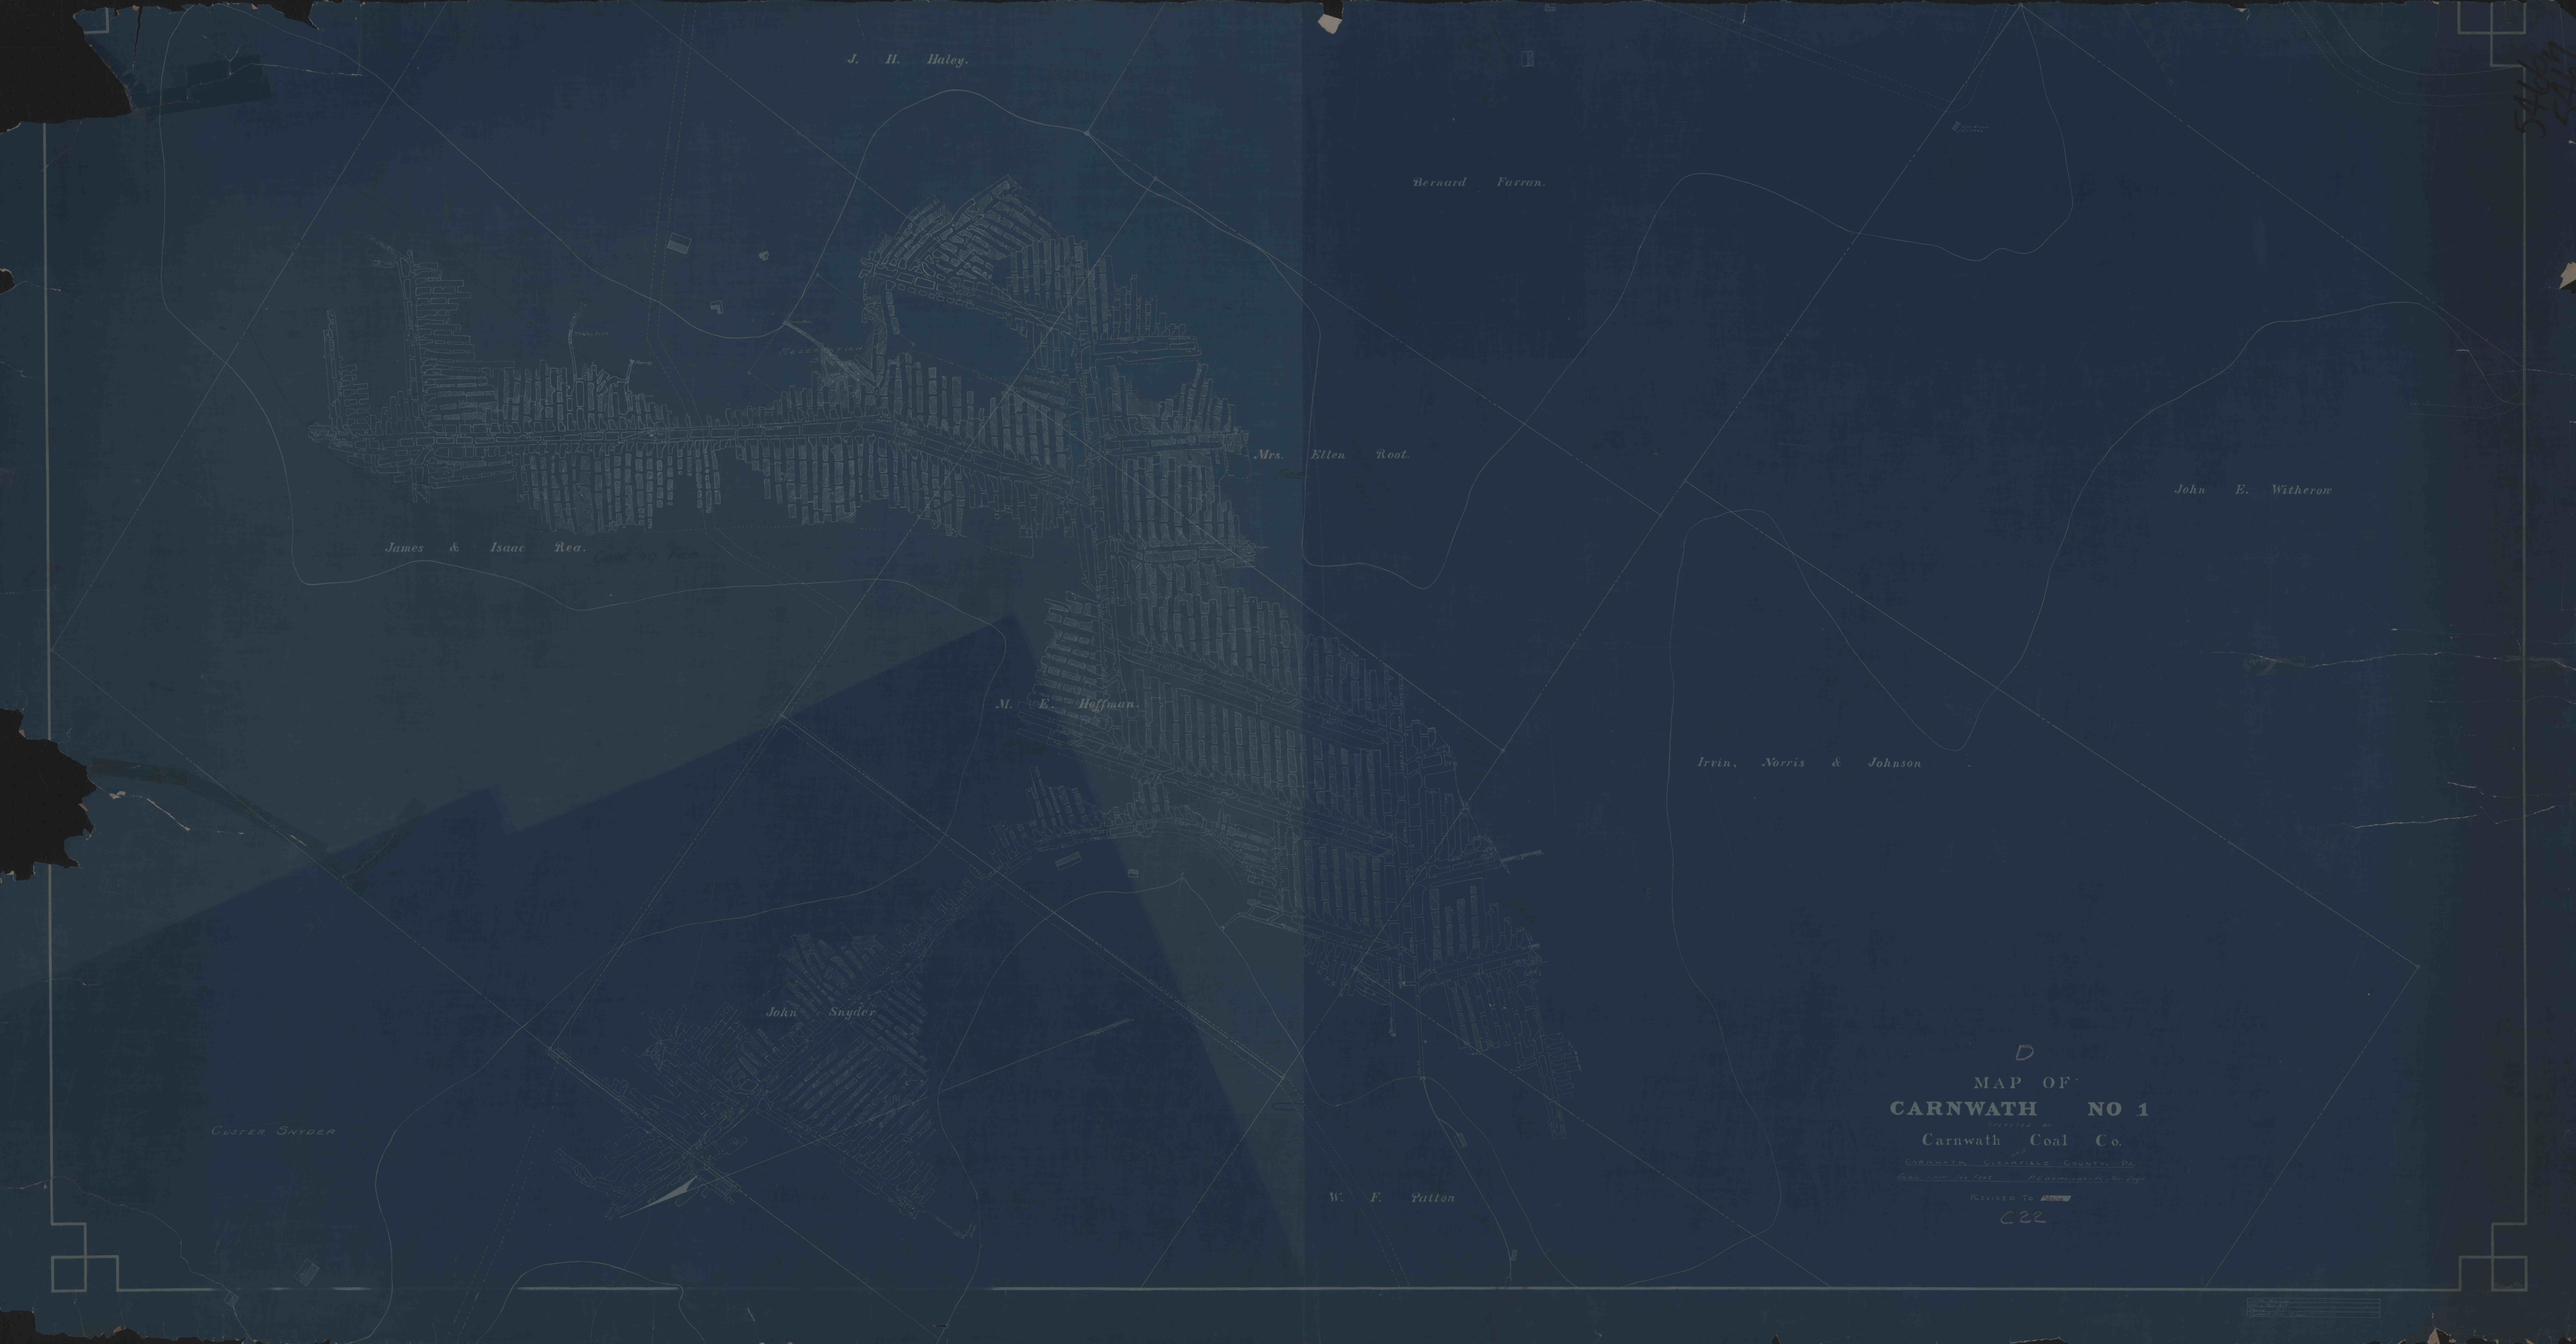
J. H. Haley.
Bernard Farran.
Mrs. Ellen Root.
John E. Witherow
James & Isaac Rea.
M. E. Huffman.
Irvin, Norris & Johnson
John Snyder
Custen Snyder
W. F. Patton
D
MAP OF
CARNWATH NO 1
Carnwath Coal Co.
C22