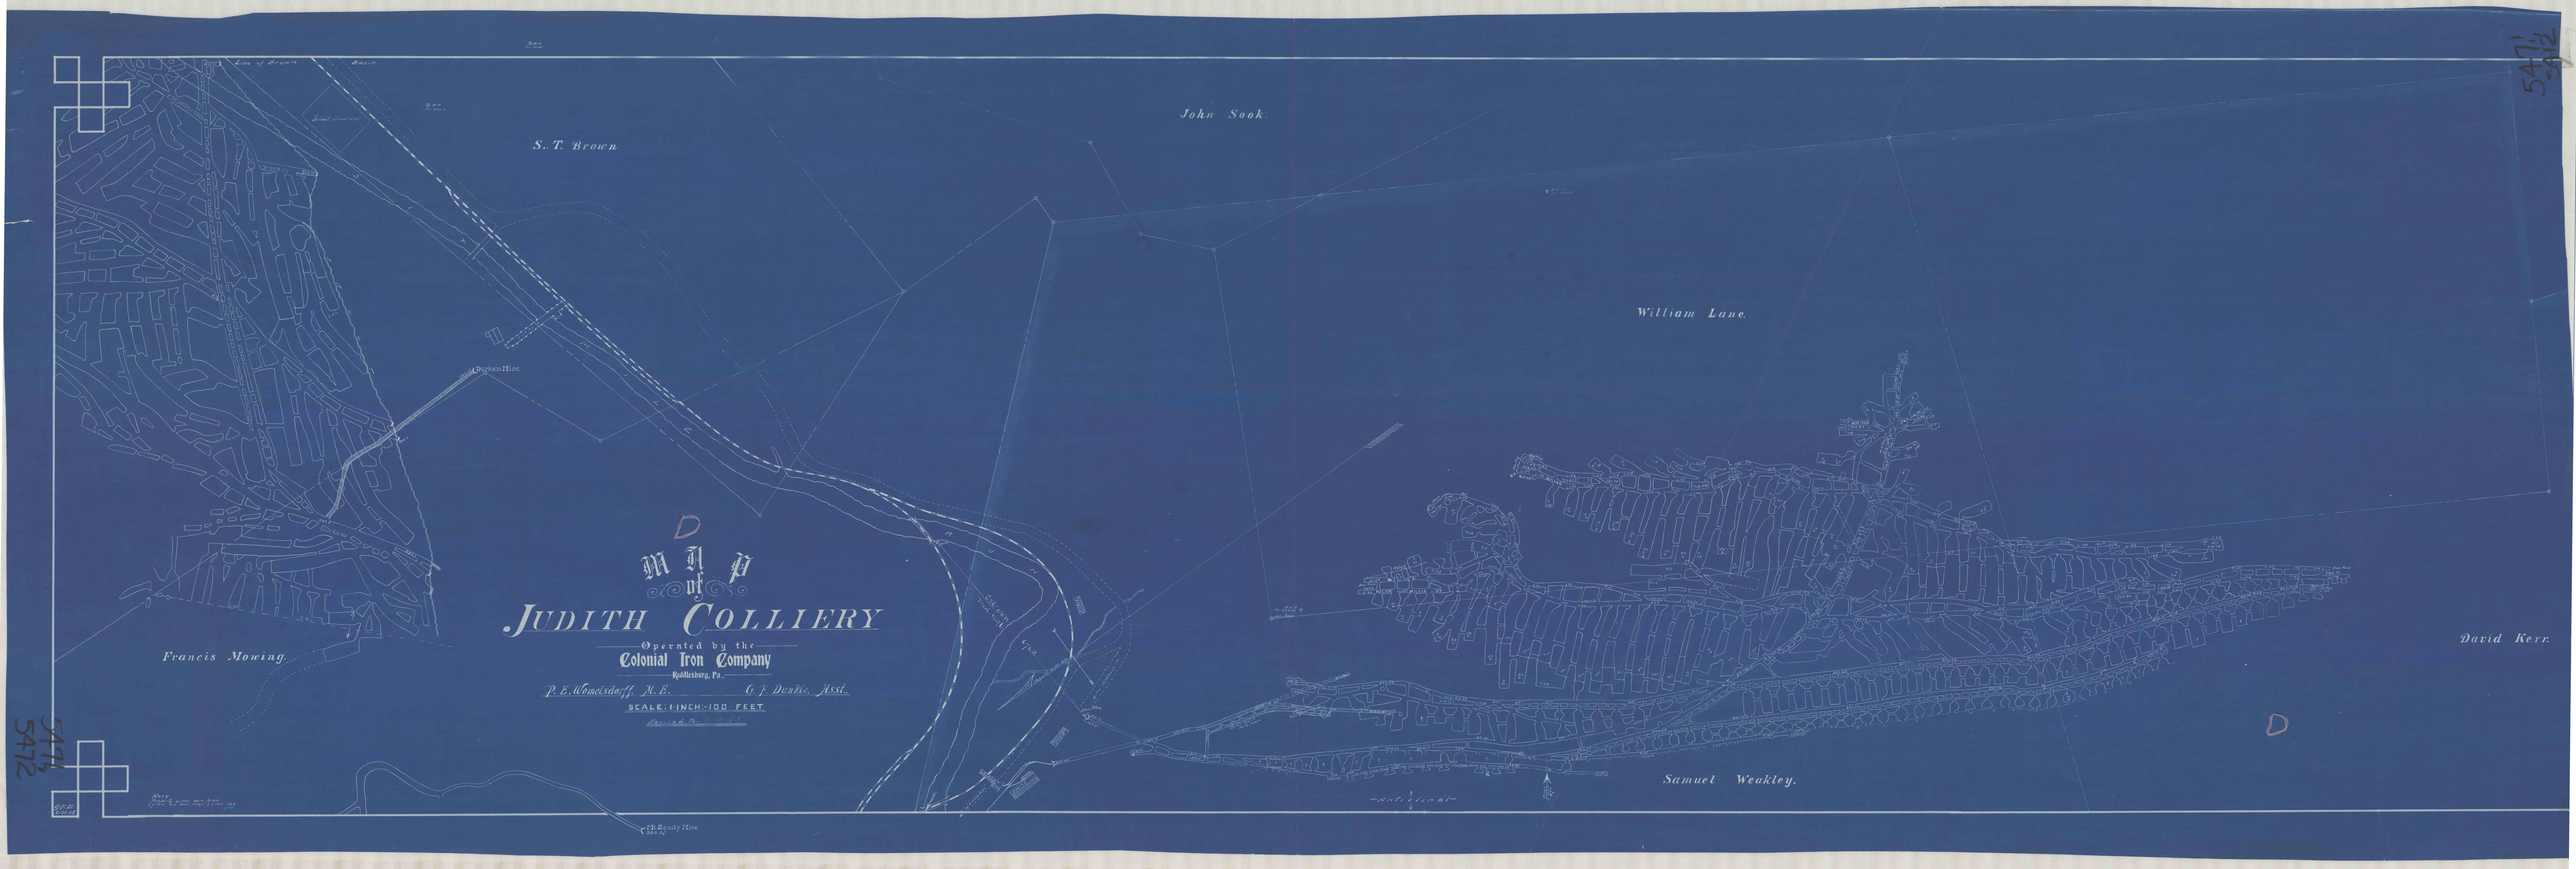
Map of
JUDITH COLLIERY
Operated by the
Colonial Iron Company
Ruddlesburg, Pa.
P. E. Womelsdorff M. E.
G. J. Deatte, Asst.
SCALE: 1 INCH = 100 FEET
S. T. Brown
John Sook
William Lane
Francis Mowing
David Kerr
Samuel Weakley
Dugan Mine
Line of Brown
Basin
Rotation
5471
5472