

5488

Note: The Property Lines  
Here Taken From

5488 D


# Map of MARTHA SLOPE

OPERATED BY  
**SHANNON COMPANY**  
DUDLEY, HUNTINGDON COUNTY, PENNA.

Womelsdorff & Dunkle, Mining Engineers, Philipsburg, Pa.  
Scale: 1 inch = 100 Feet.  
REVISED TO 9-15-22.

Property Lines from 4th 1872  
and 5th 1872

CDA14

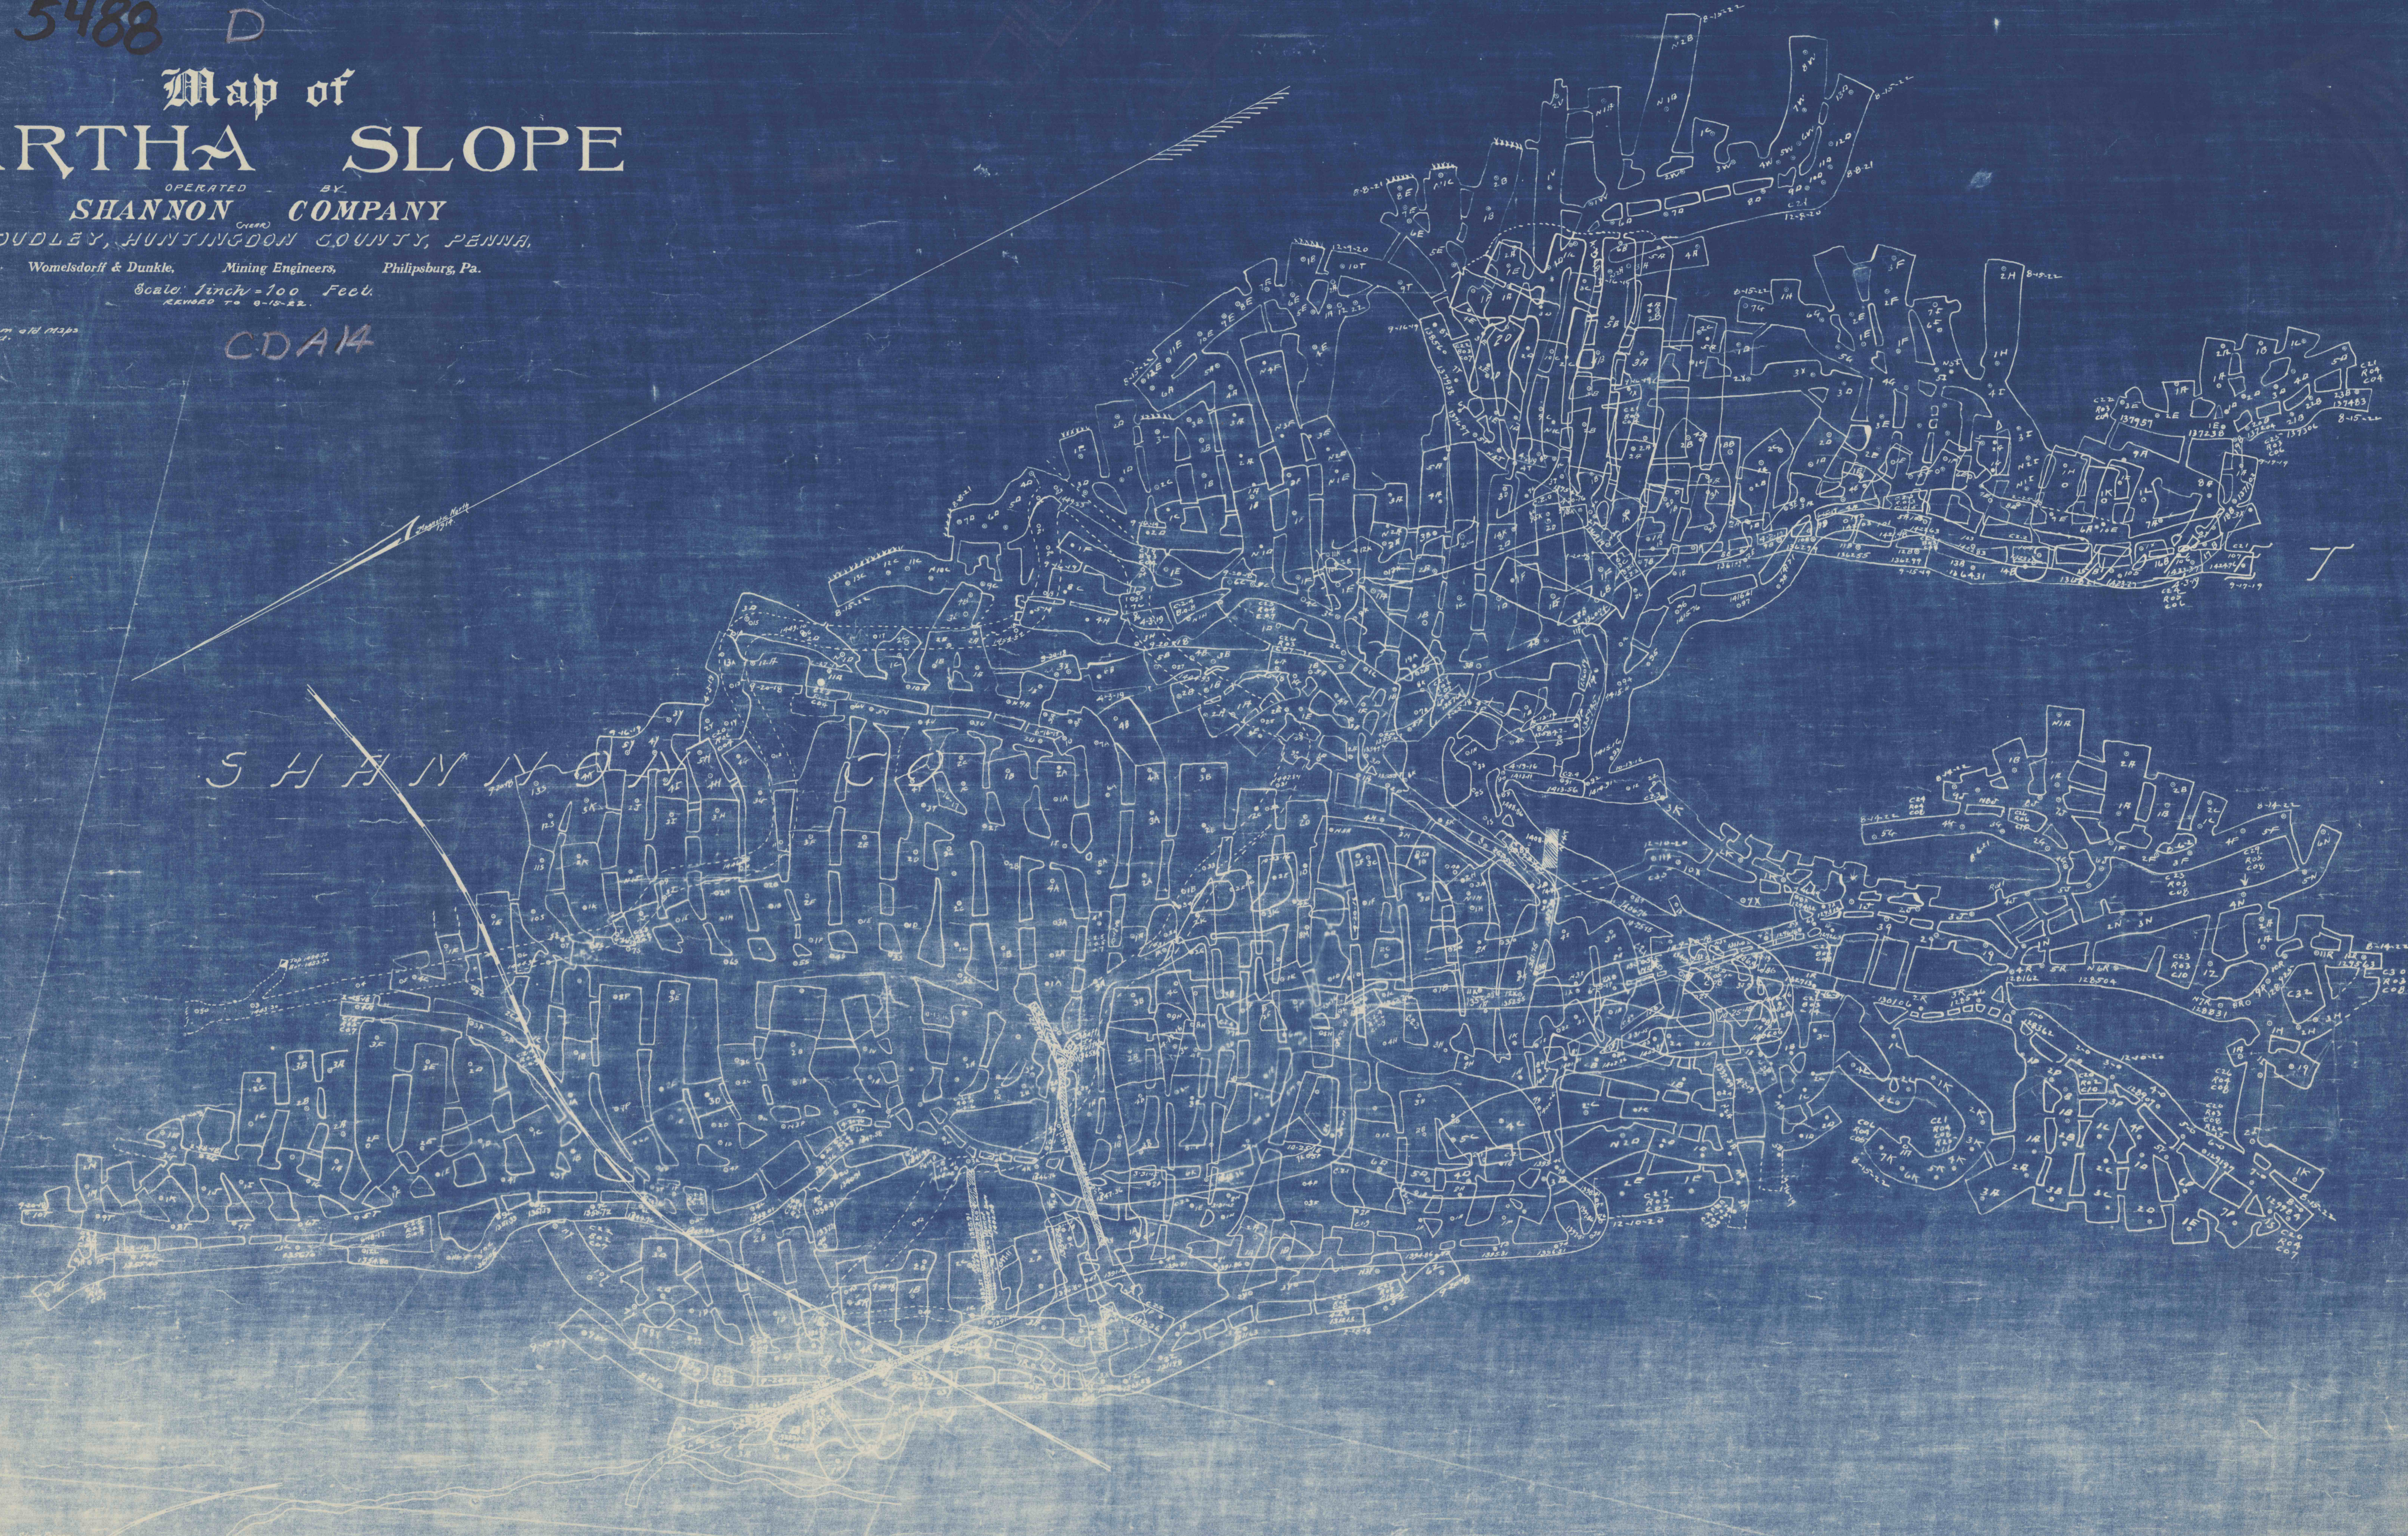

S H A N N O N

E F G O U L D

539 E

5488