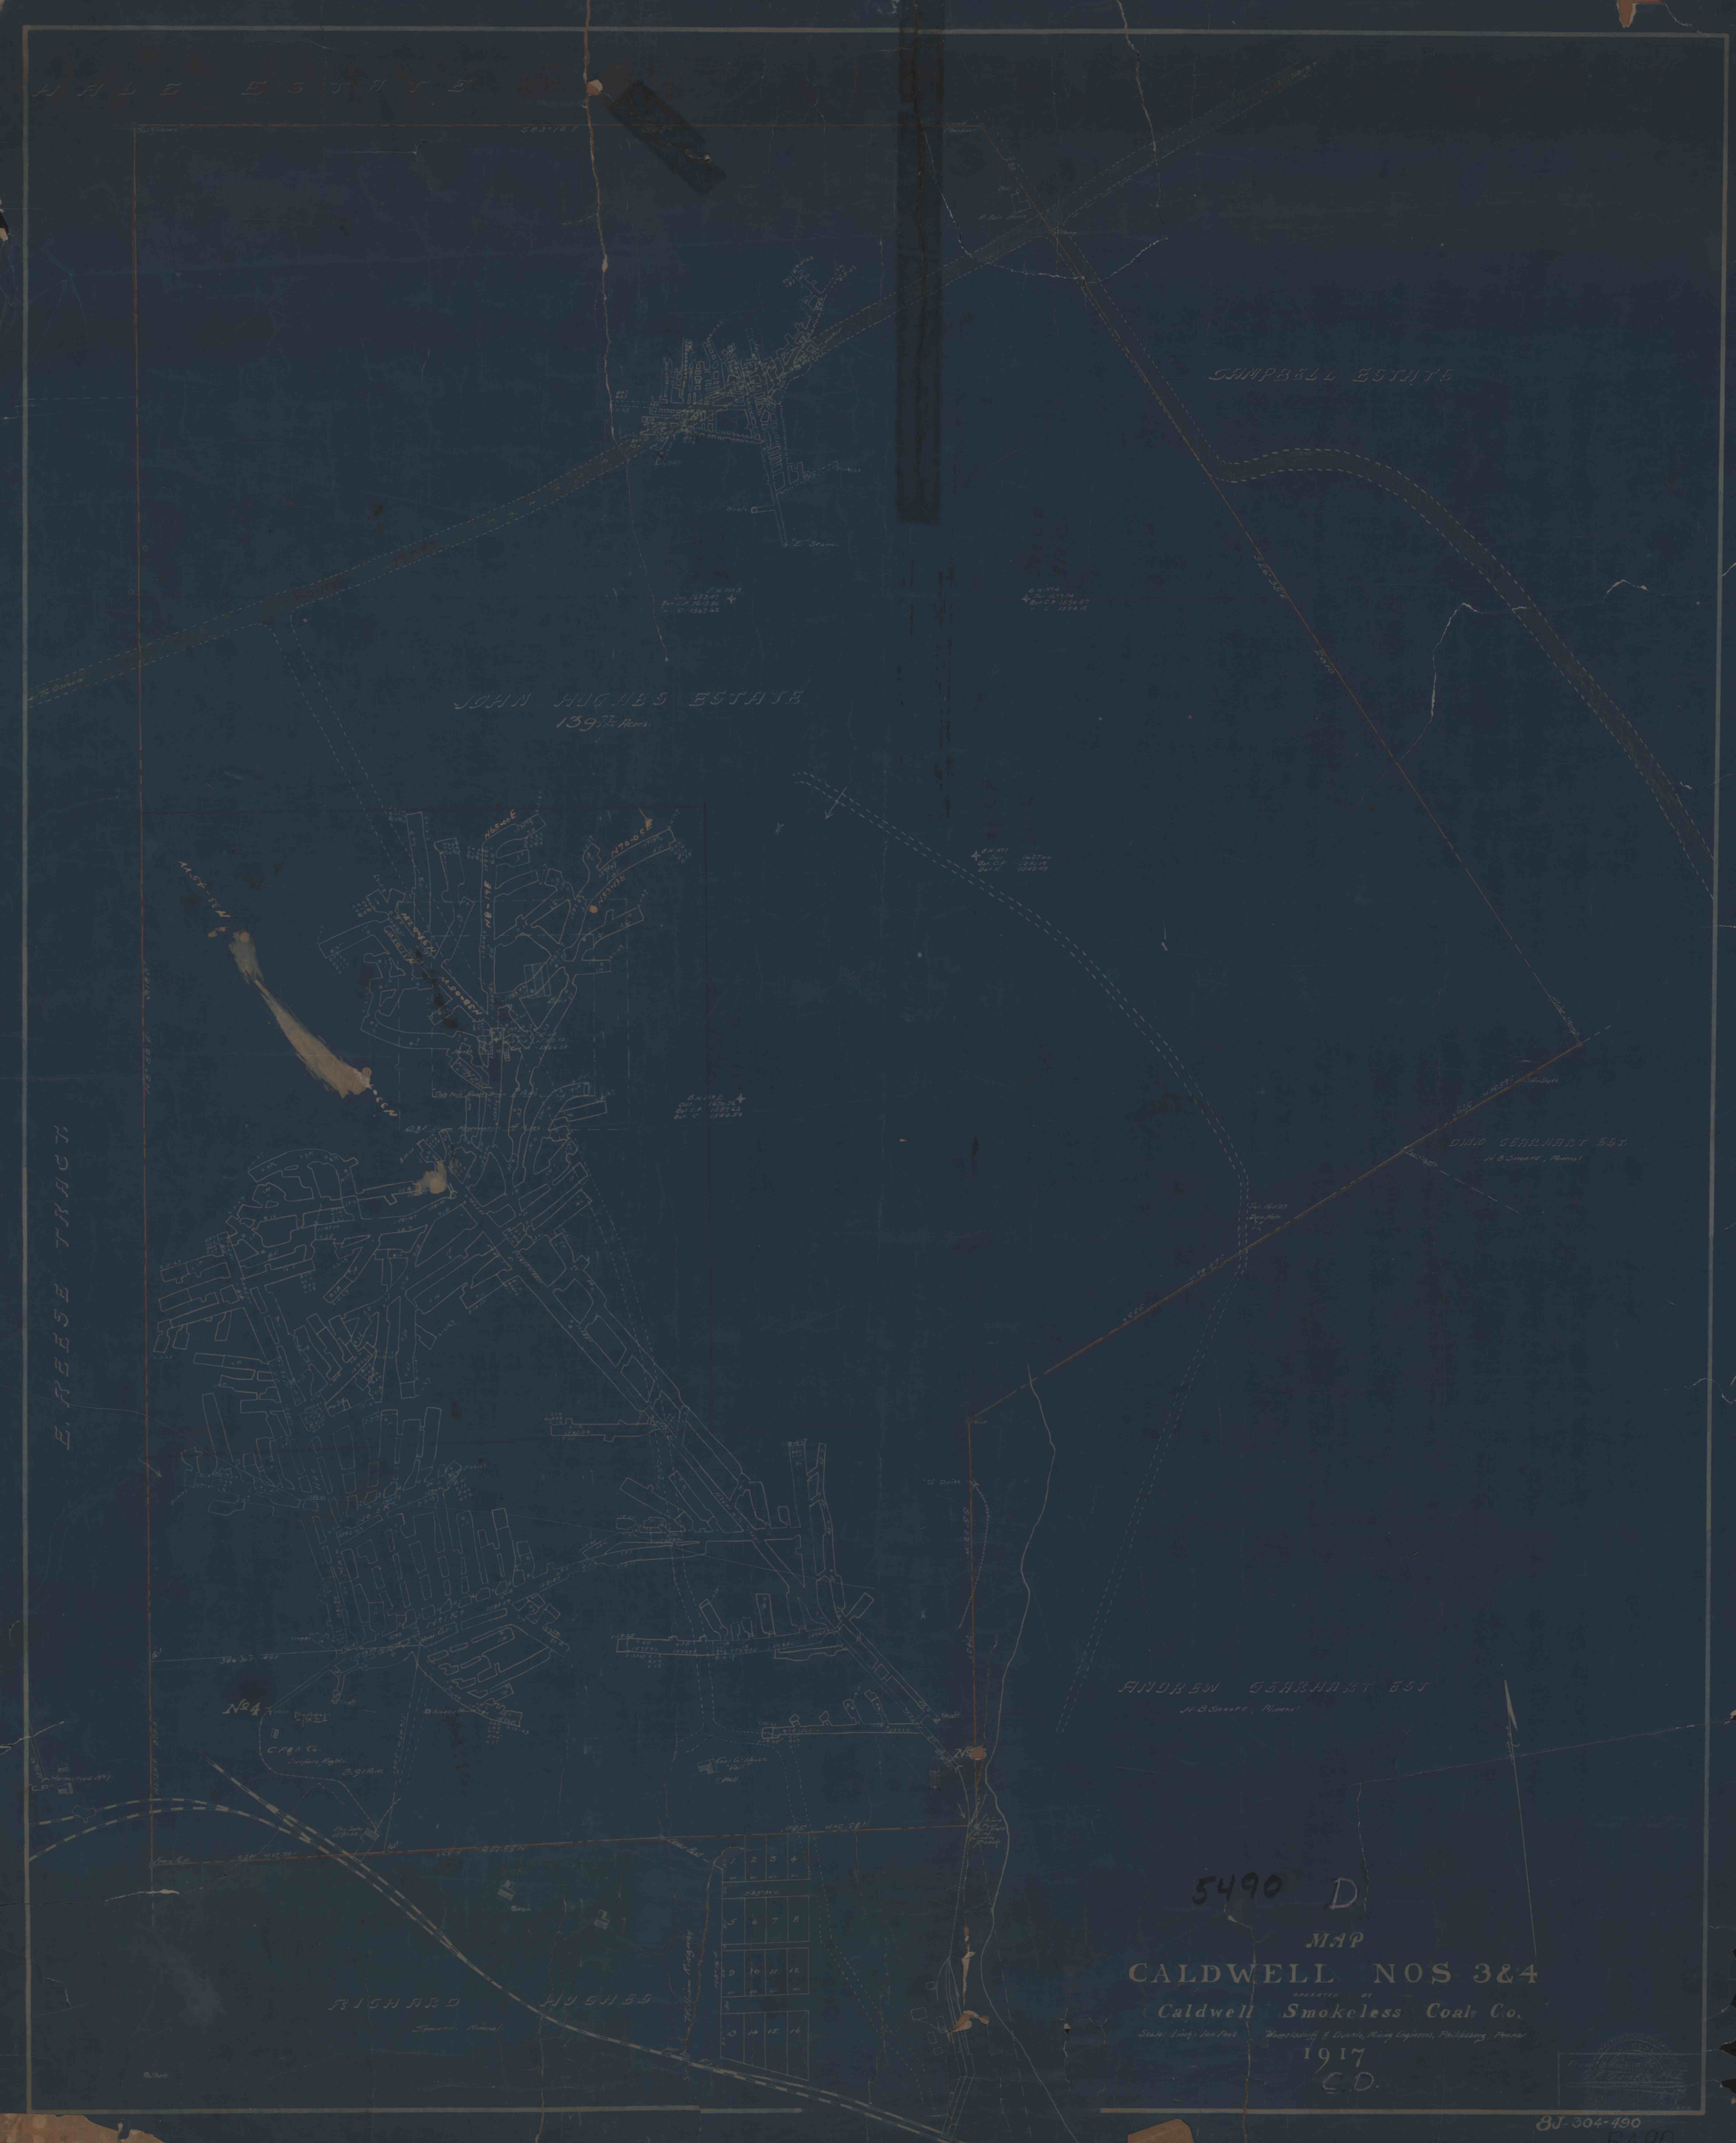

5490 D

MAP

CALDWELL NOS 3&4

OPERATED BY

Caldwell Smokeless Coal Co.

Scale: 1 inch = 100 Feet Wood, Dolloff & Dustin, Mining Engineers, Philipsburg, Penna.

1917

C.D.

BJ-304-490
5490