

JOHN PORTER

07740

M.67.9 W

S 47.24 E

13250

J. B. CALDWELL

MOSES OWENS

43740


TRACT

IRE BRICK CO.

ACRES.

LAFAYETTE McCLURE

N 45.19 W

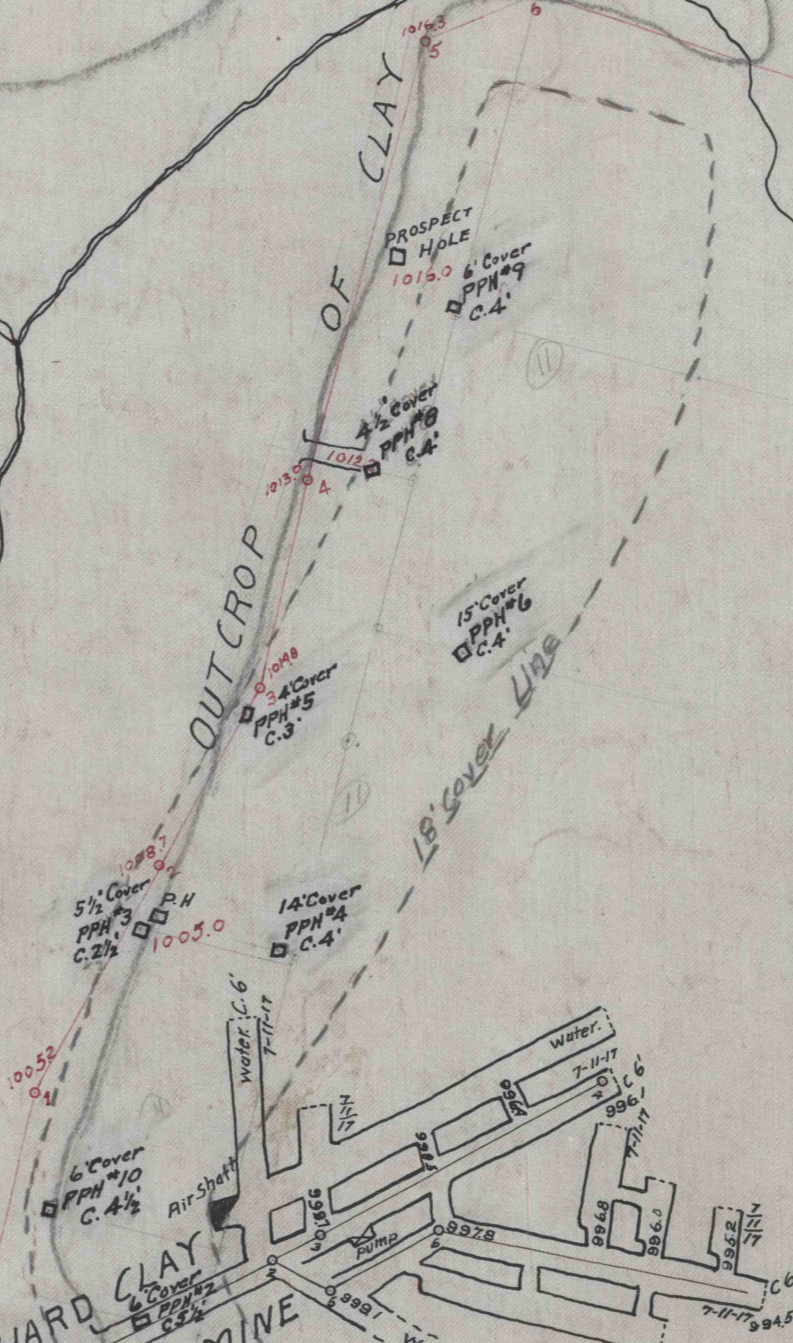

STATE

BRANCH OF SUSQUEHANNA RIVER

HIGHWAY

OUT CROP

OF

CLAY

WEST

RIVER

55-3-11A

2004