


5505  
5506

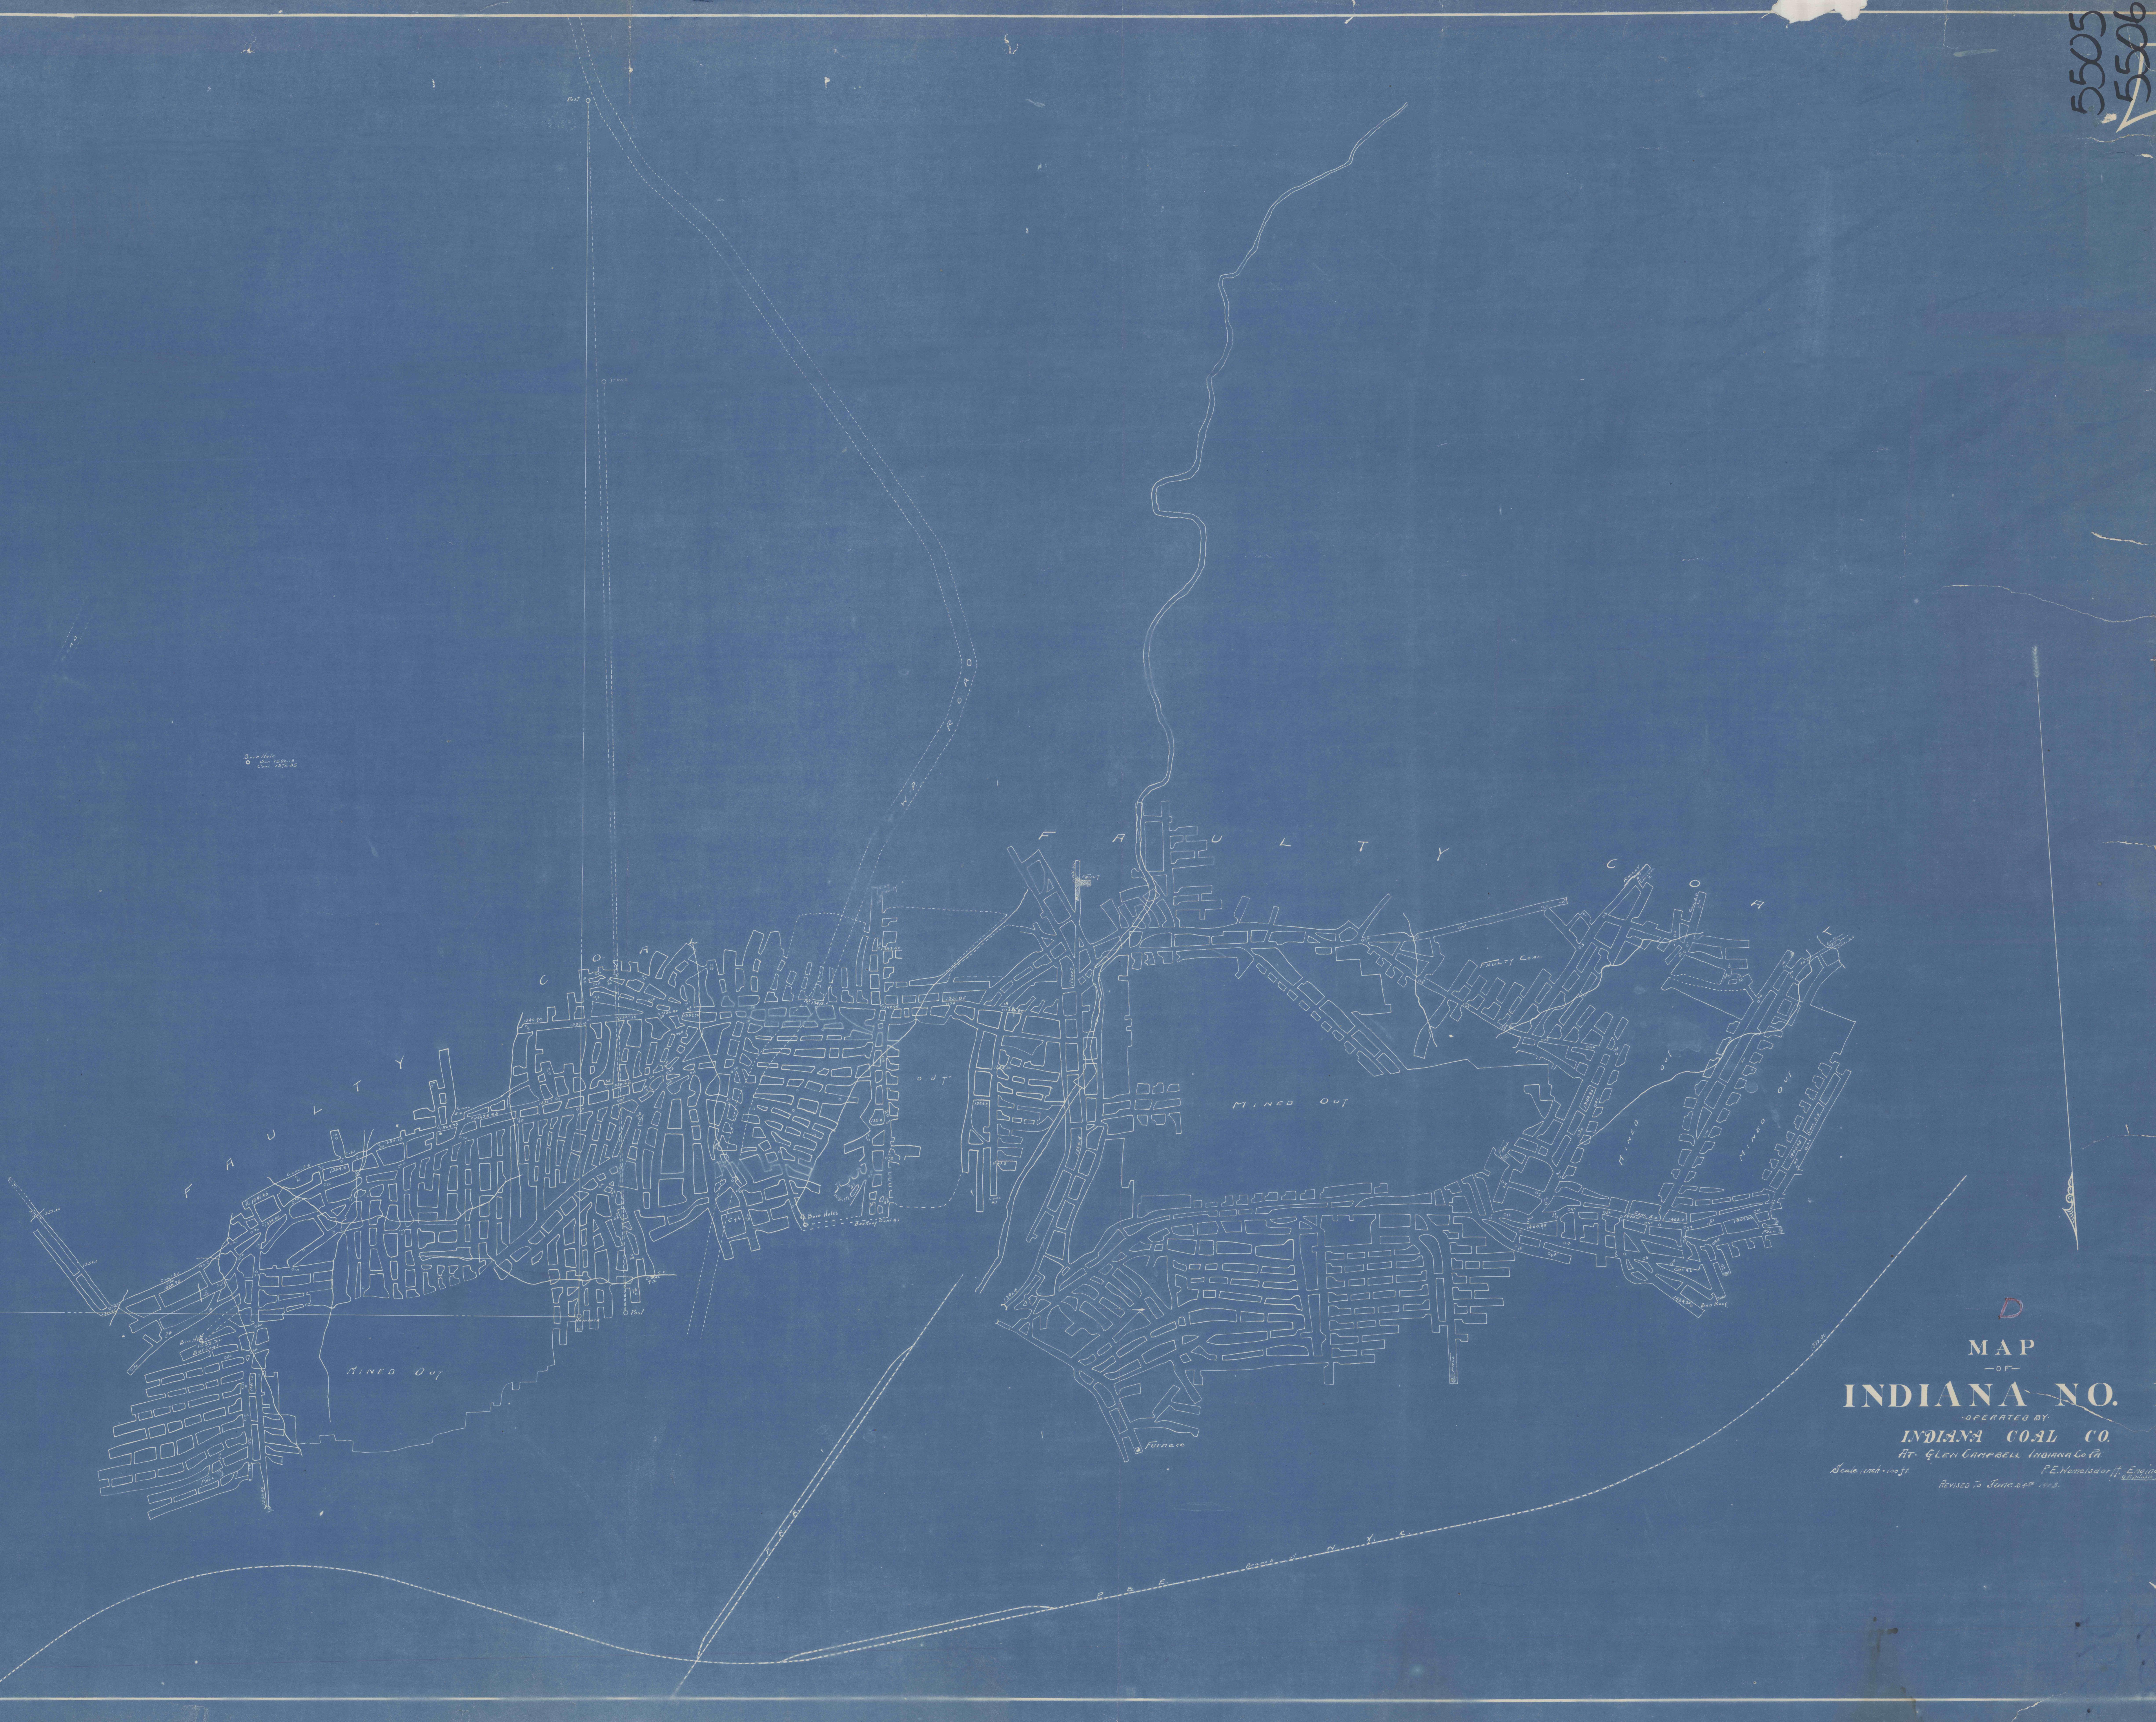

D  
MAP  
-OF-  
**INDIANA NO. 1**  
OPERATED BY  
**INDIANA COAL CO.**  
BY GLEN CAMPBELL, INDIANA CO. CO.  
REVISED TO JUNE 29, 1913.  
P.E. Holsinger & Co., Engineers,  
