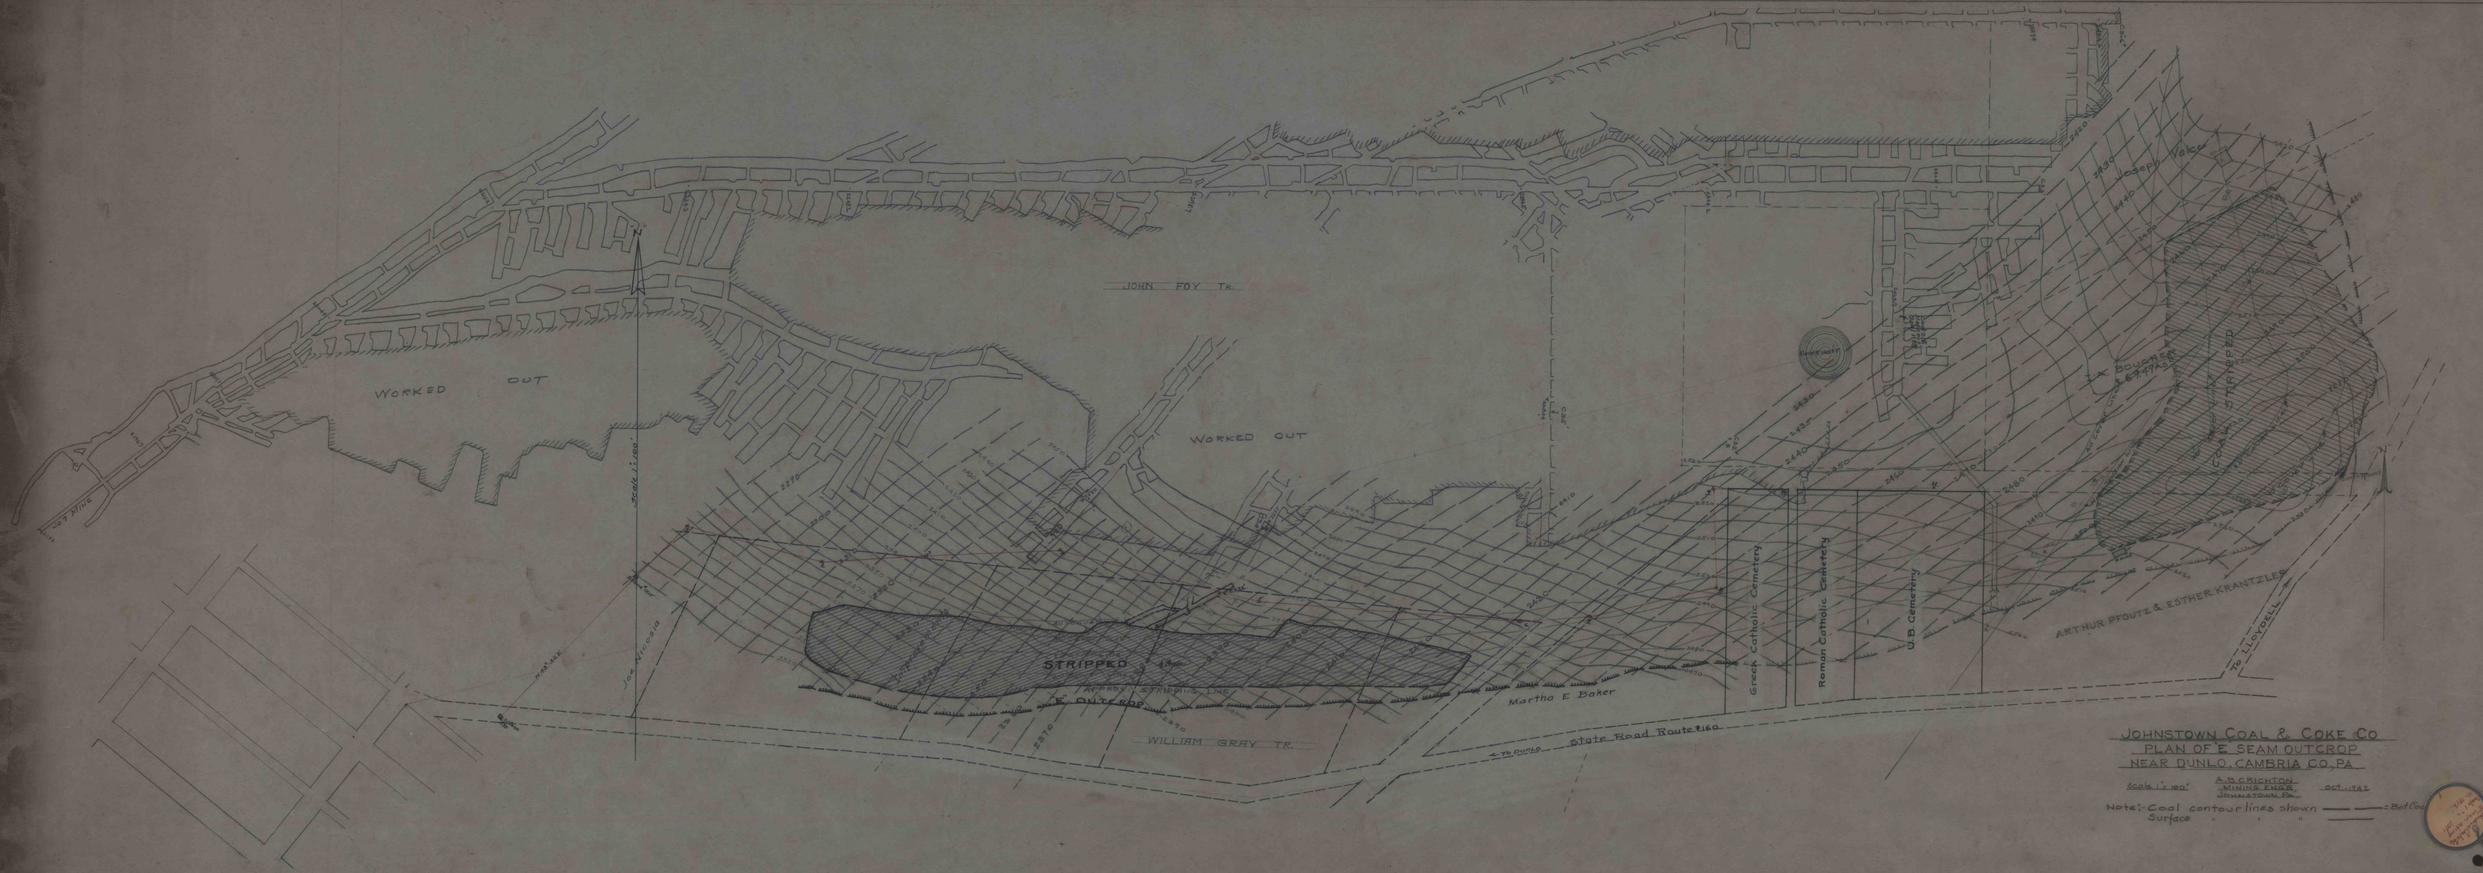

JOHNSTOWN COAL & COKE CO
PLAN OF E SEAM OUTCROP
NEAR DUNLO, CAMBRIA CO. PA

Scale 1" = 200' A. B. CRICHTON MINING ENGR. JOHNSTOWN, PA. OCT. 1942

Note: Coal contour lines shown ——— = Bottom
Surface . . . . . .