



JOHN MOORE

FLORIAN EF'S COAL MINE
RIVERVIEW
WHEELS MINE

JOPLING

GEORGE'S KITTO

BEYER & KIRK

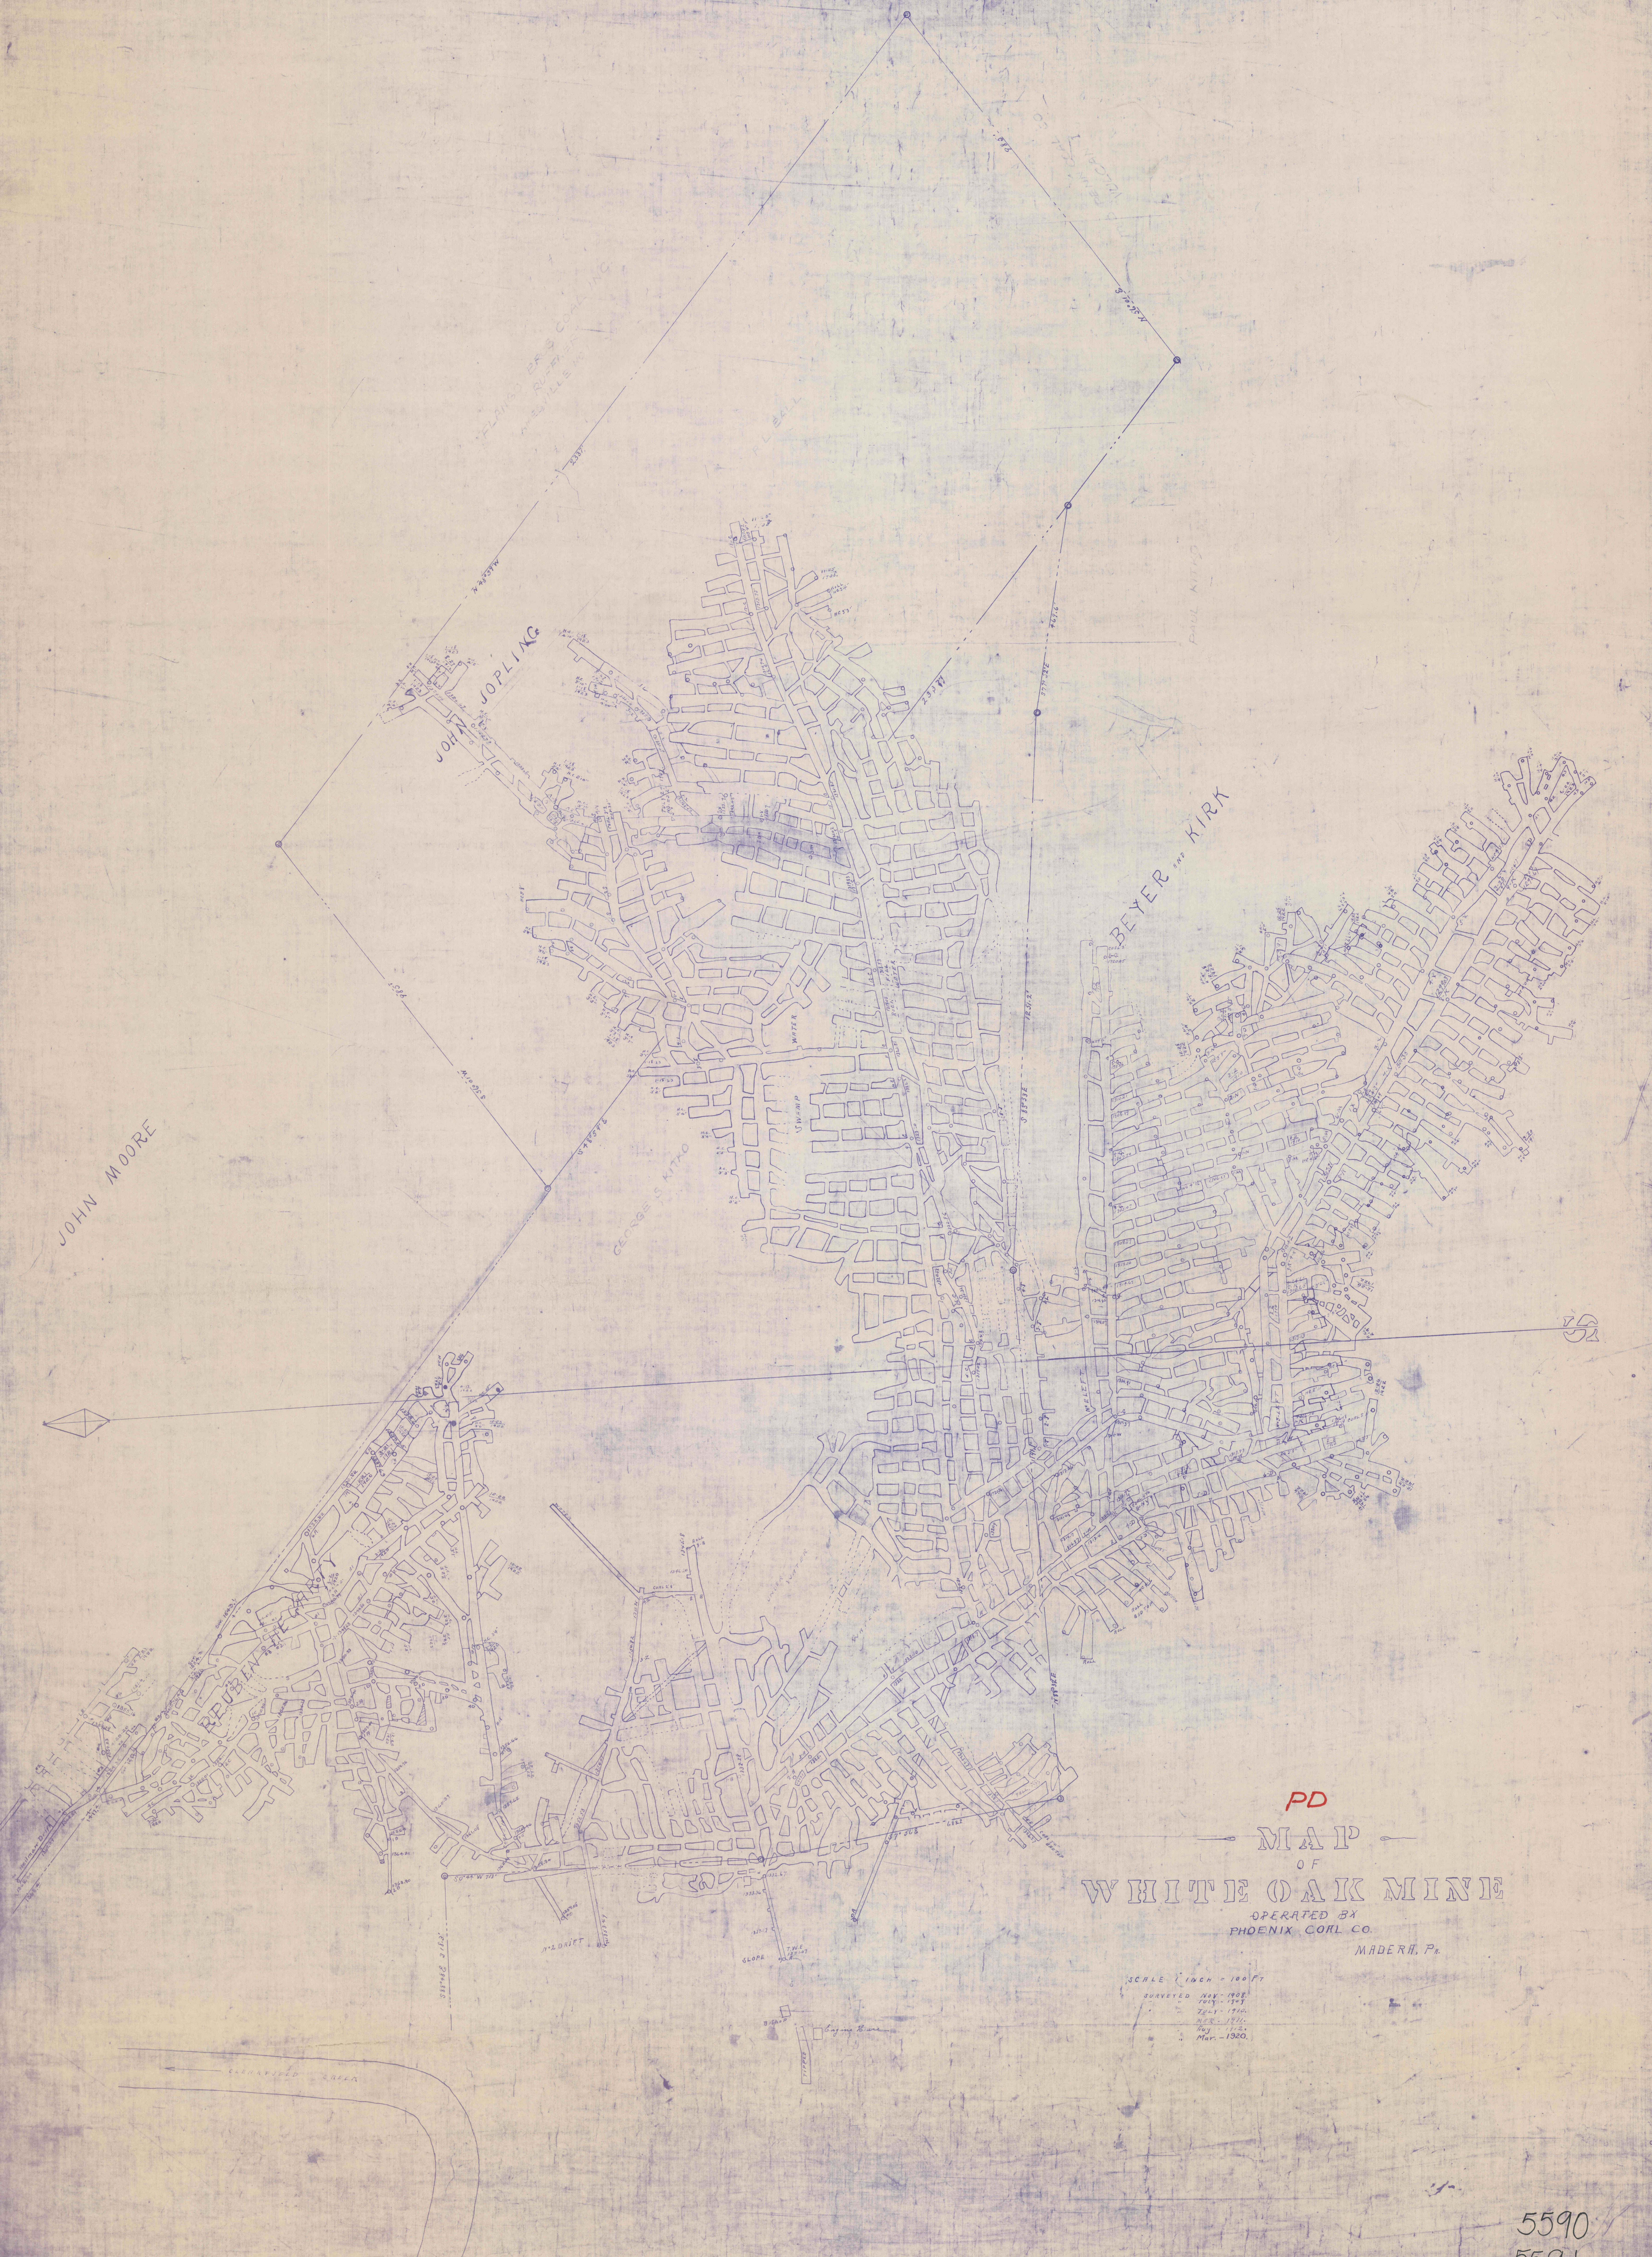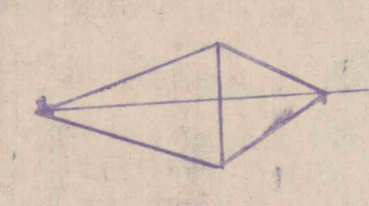

PD

MAP

OF

WHITE OAK MINE

OPERATED BY
PHOENIX COAL CO.

MADRID, Pa.

SCALE 1 INCH = 100 FT.

SURVEYED NOV. 1908
1909 - 1910
22nd 1910
REV. 1911
2nd
Mar. 1920.

5590
5591