


MAXTON COAL CO.

JOHN TODD

North  
1 in = 100 ft.

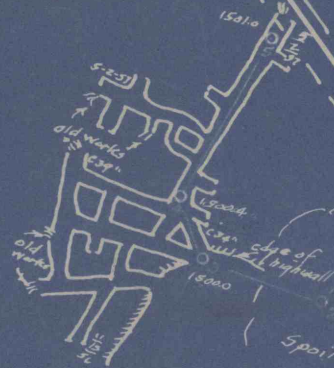

Map for  
**CLEM WATSON**

Showing  
**E Seam Deep Mine**

Morris Twp      Clearfield Co., Pa.

SCALE 1 in = 100 ft.

May 26, 1957

E. L. Gray

5721