


SAMUEL SNOWERS TRACT
S. RUSNAK

JACOB MYER TRACT
S. RUSNAK

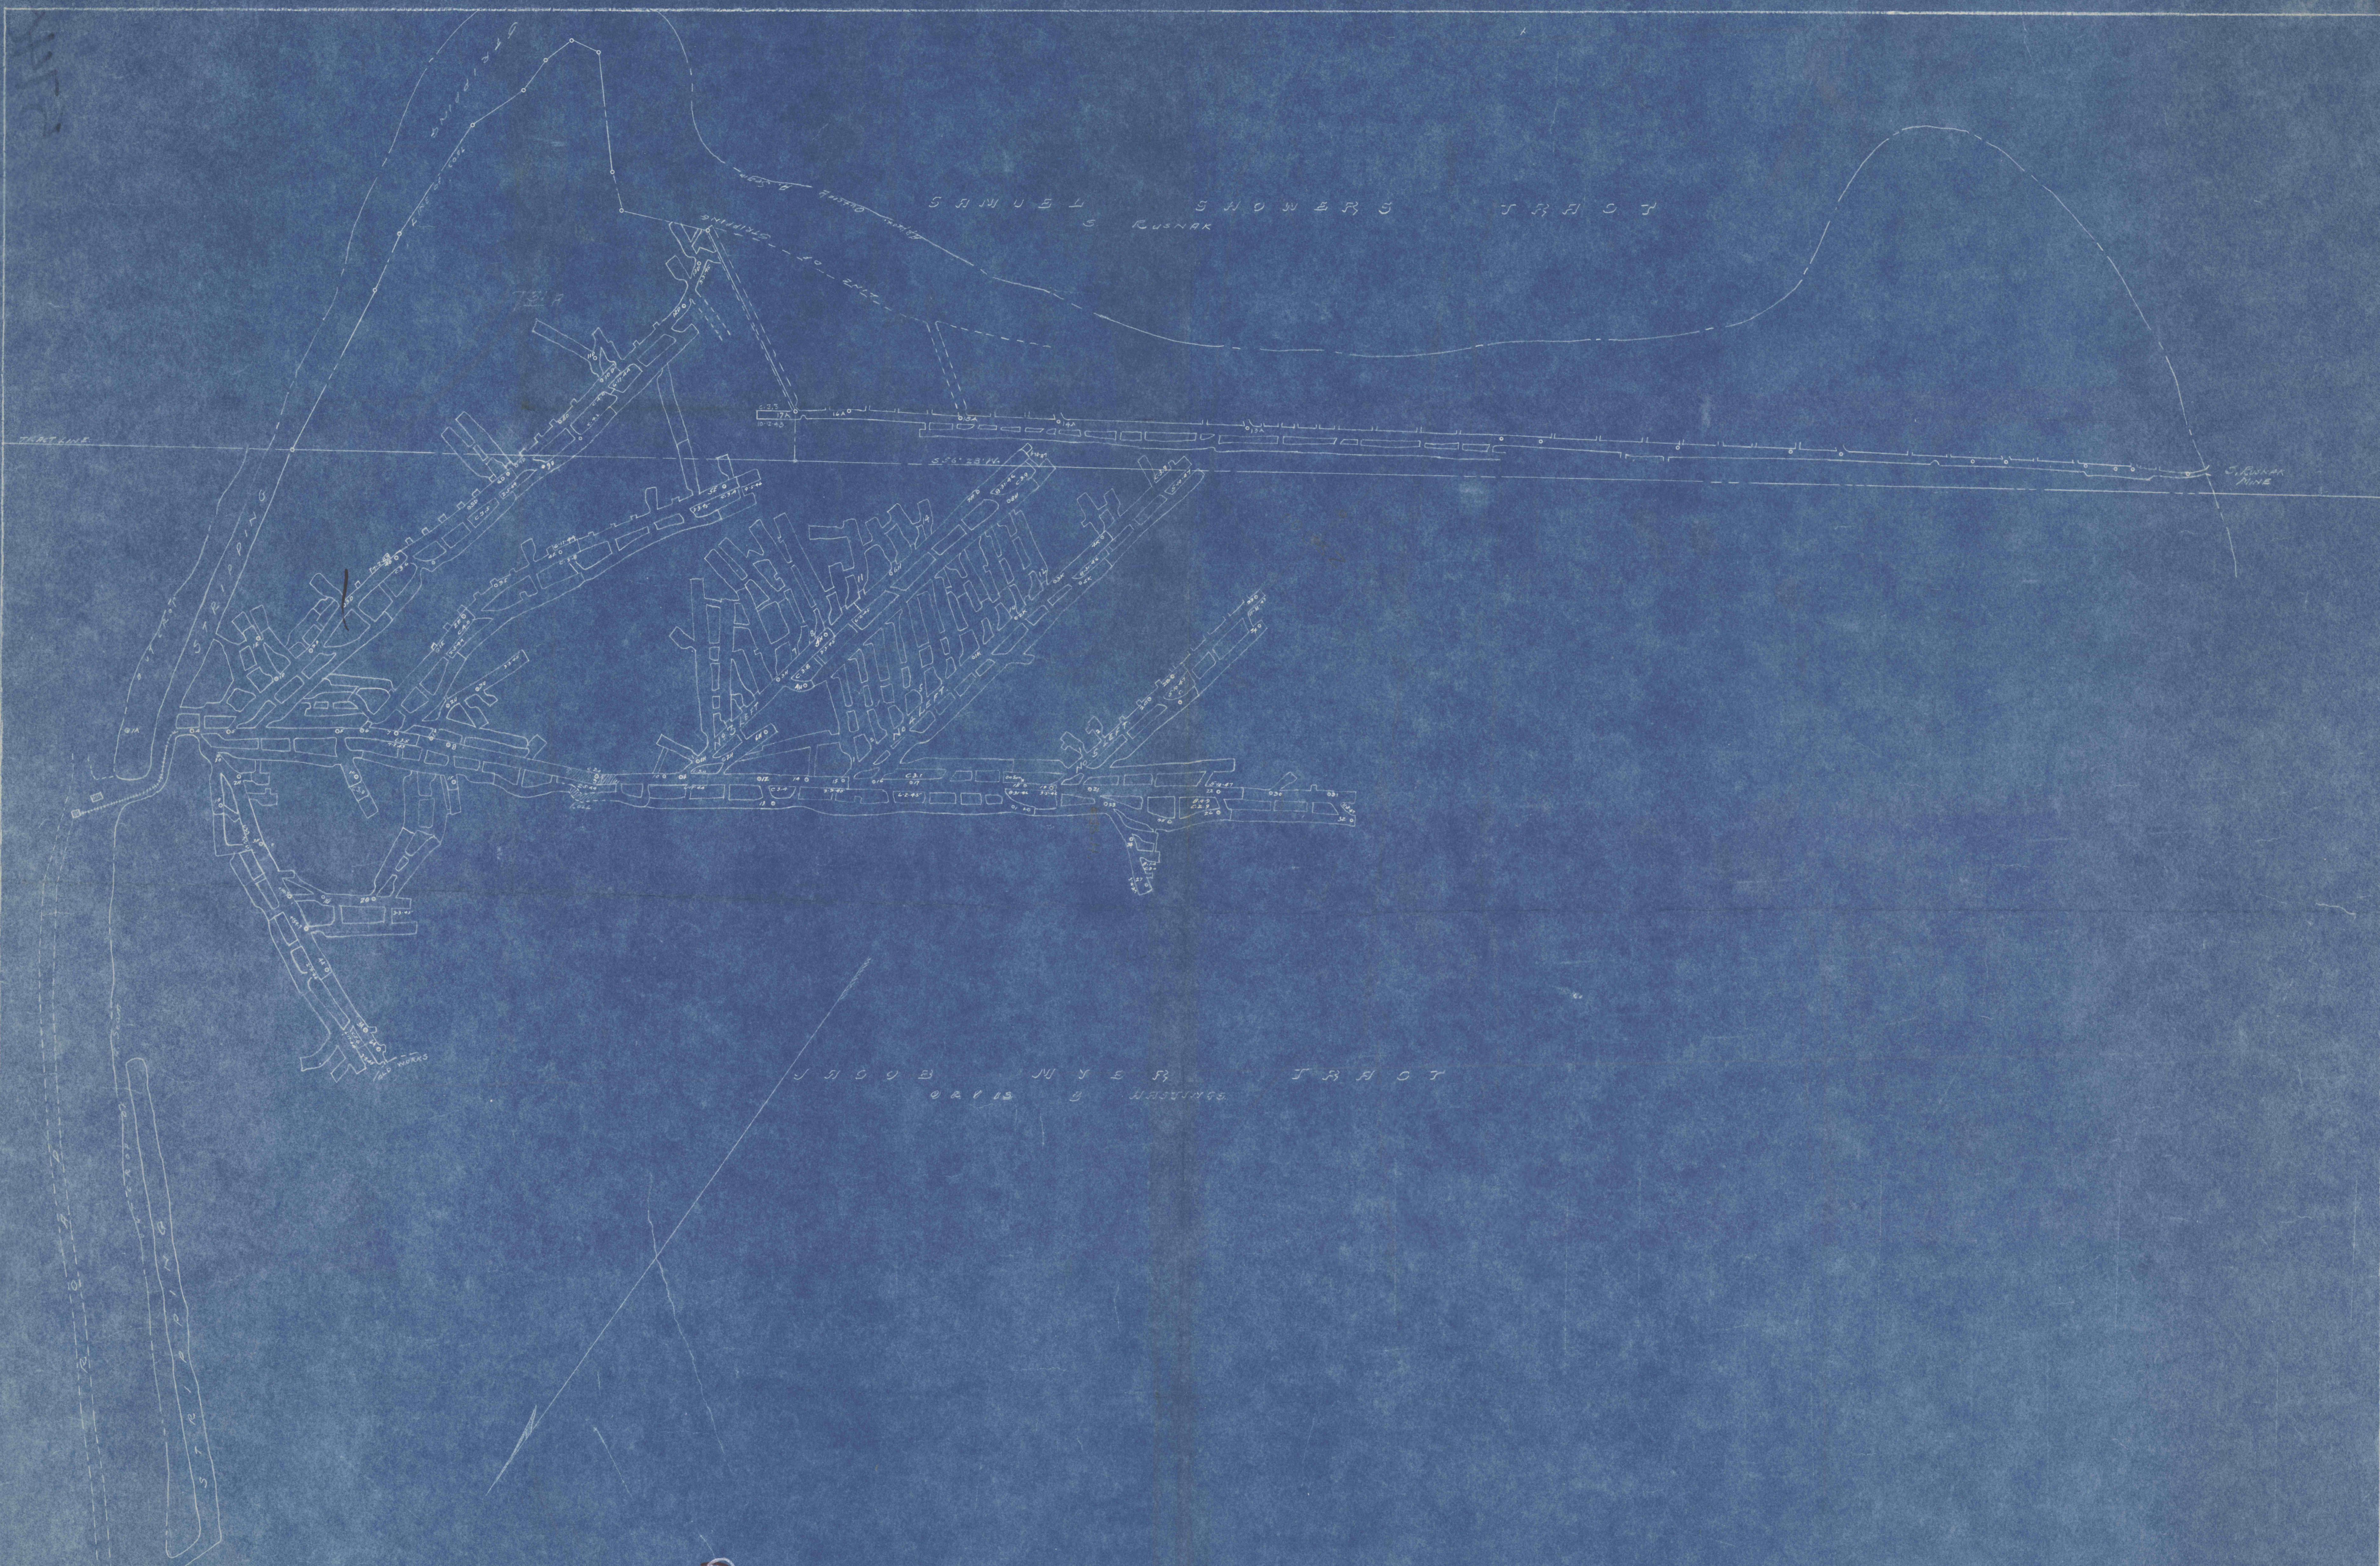

D

MAP OF
No 28 MINE

OPERATED BY THE
HICKS RUN COAL MINING CO
G. F. DUNN, Eng.
JULY 2, 1943
OCT 12, 1943
FEB 12, 1944
JUNE 17, 1944
MAY 15, 1945
AUG 31, 1946
MAY 10, 1947



5740

5740

5740