



8178
5778

R. C. HALE ESTATE

D
MAP OF
IMPERIAL No-1 & 2 AND DUNBAR
MINE WORKINGS
ON THE
R. C. HALE ESTATE.
Clearfield County, Pennsylvania.
SCALE 1"=100' 1921. Geo. H. Ayres Eng'g.

GREEN "TRACT"

CD.

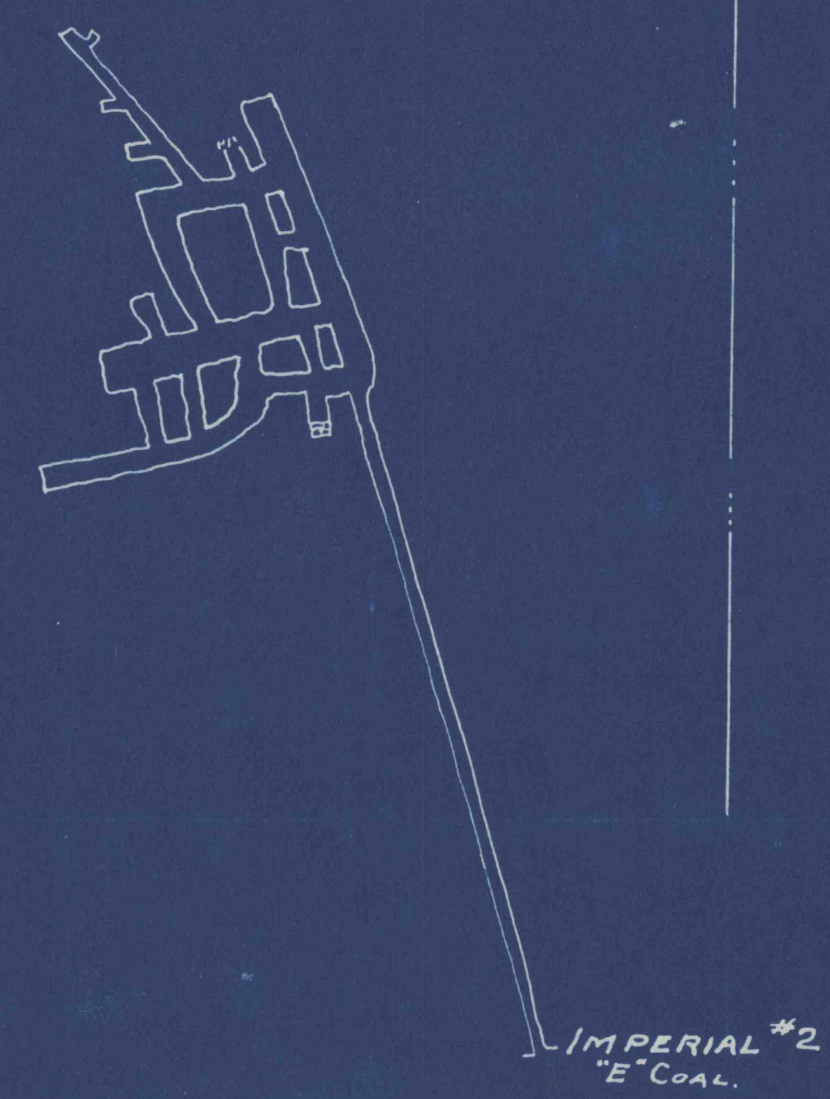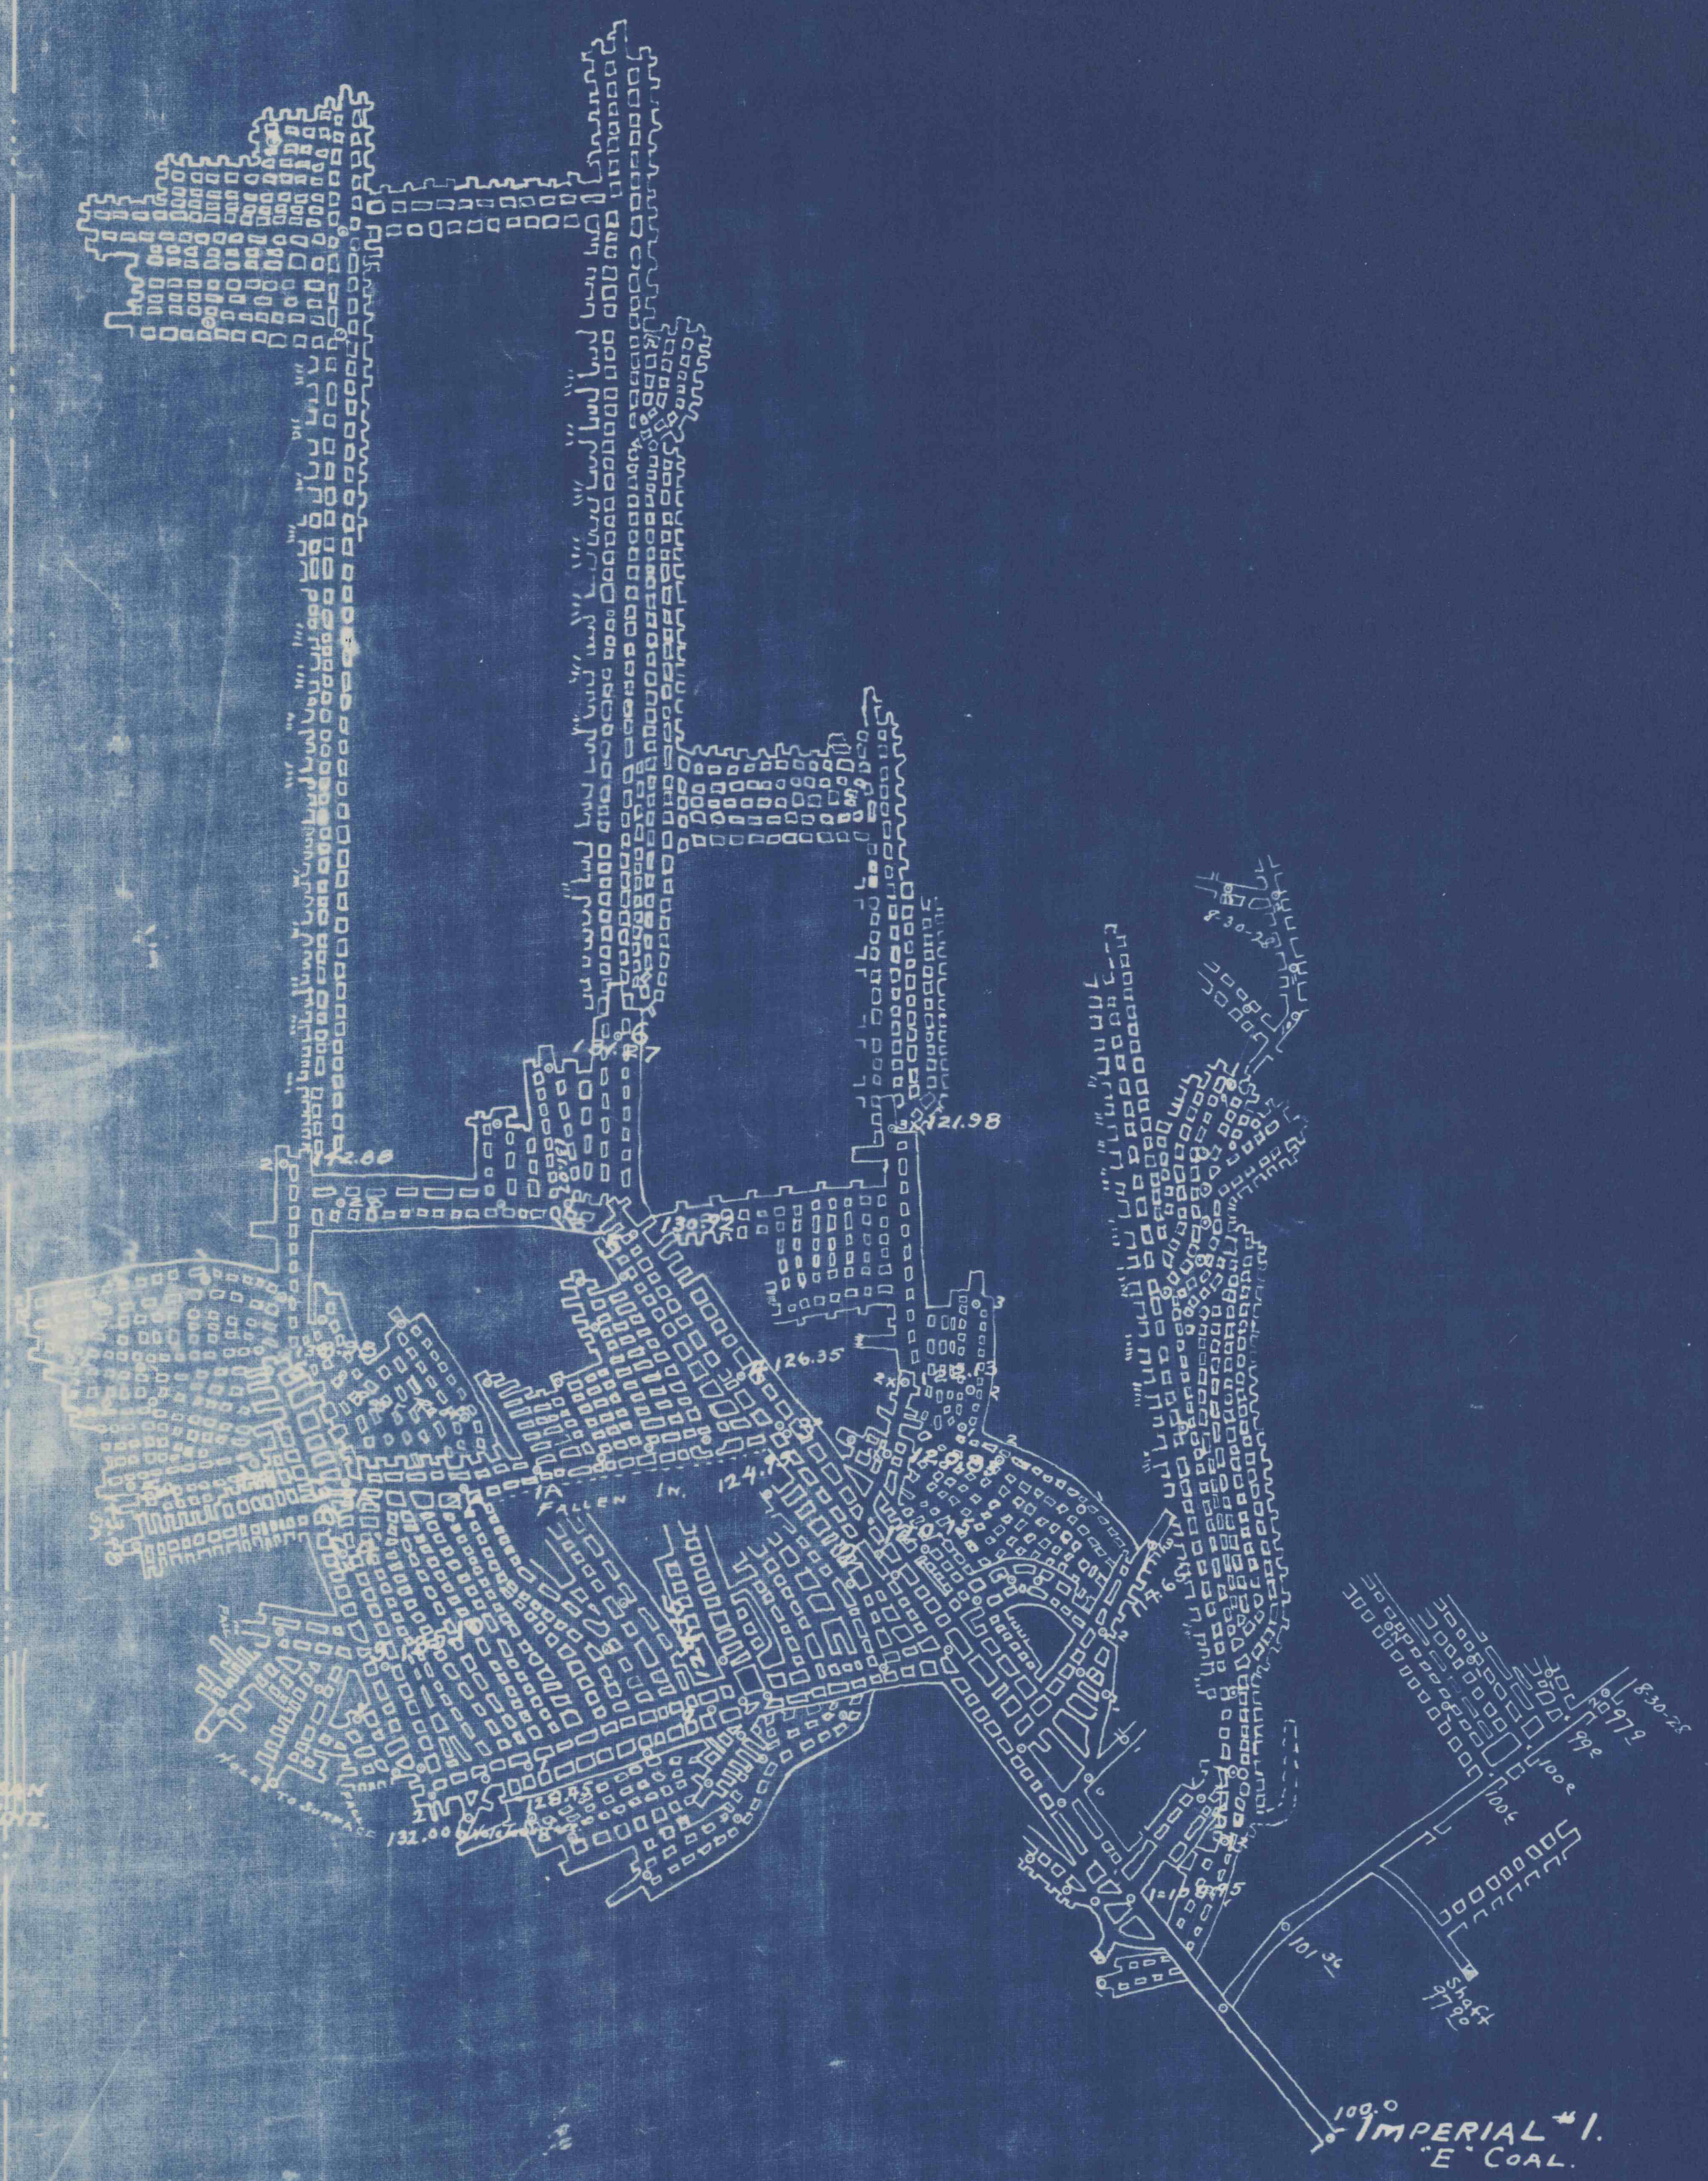

SHAW "FARM"

DRANE