


1872

5181

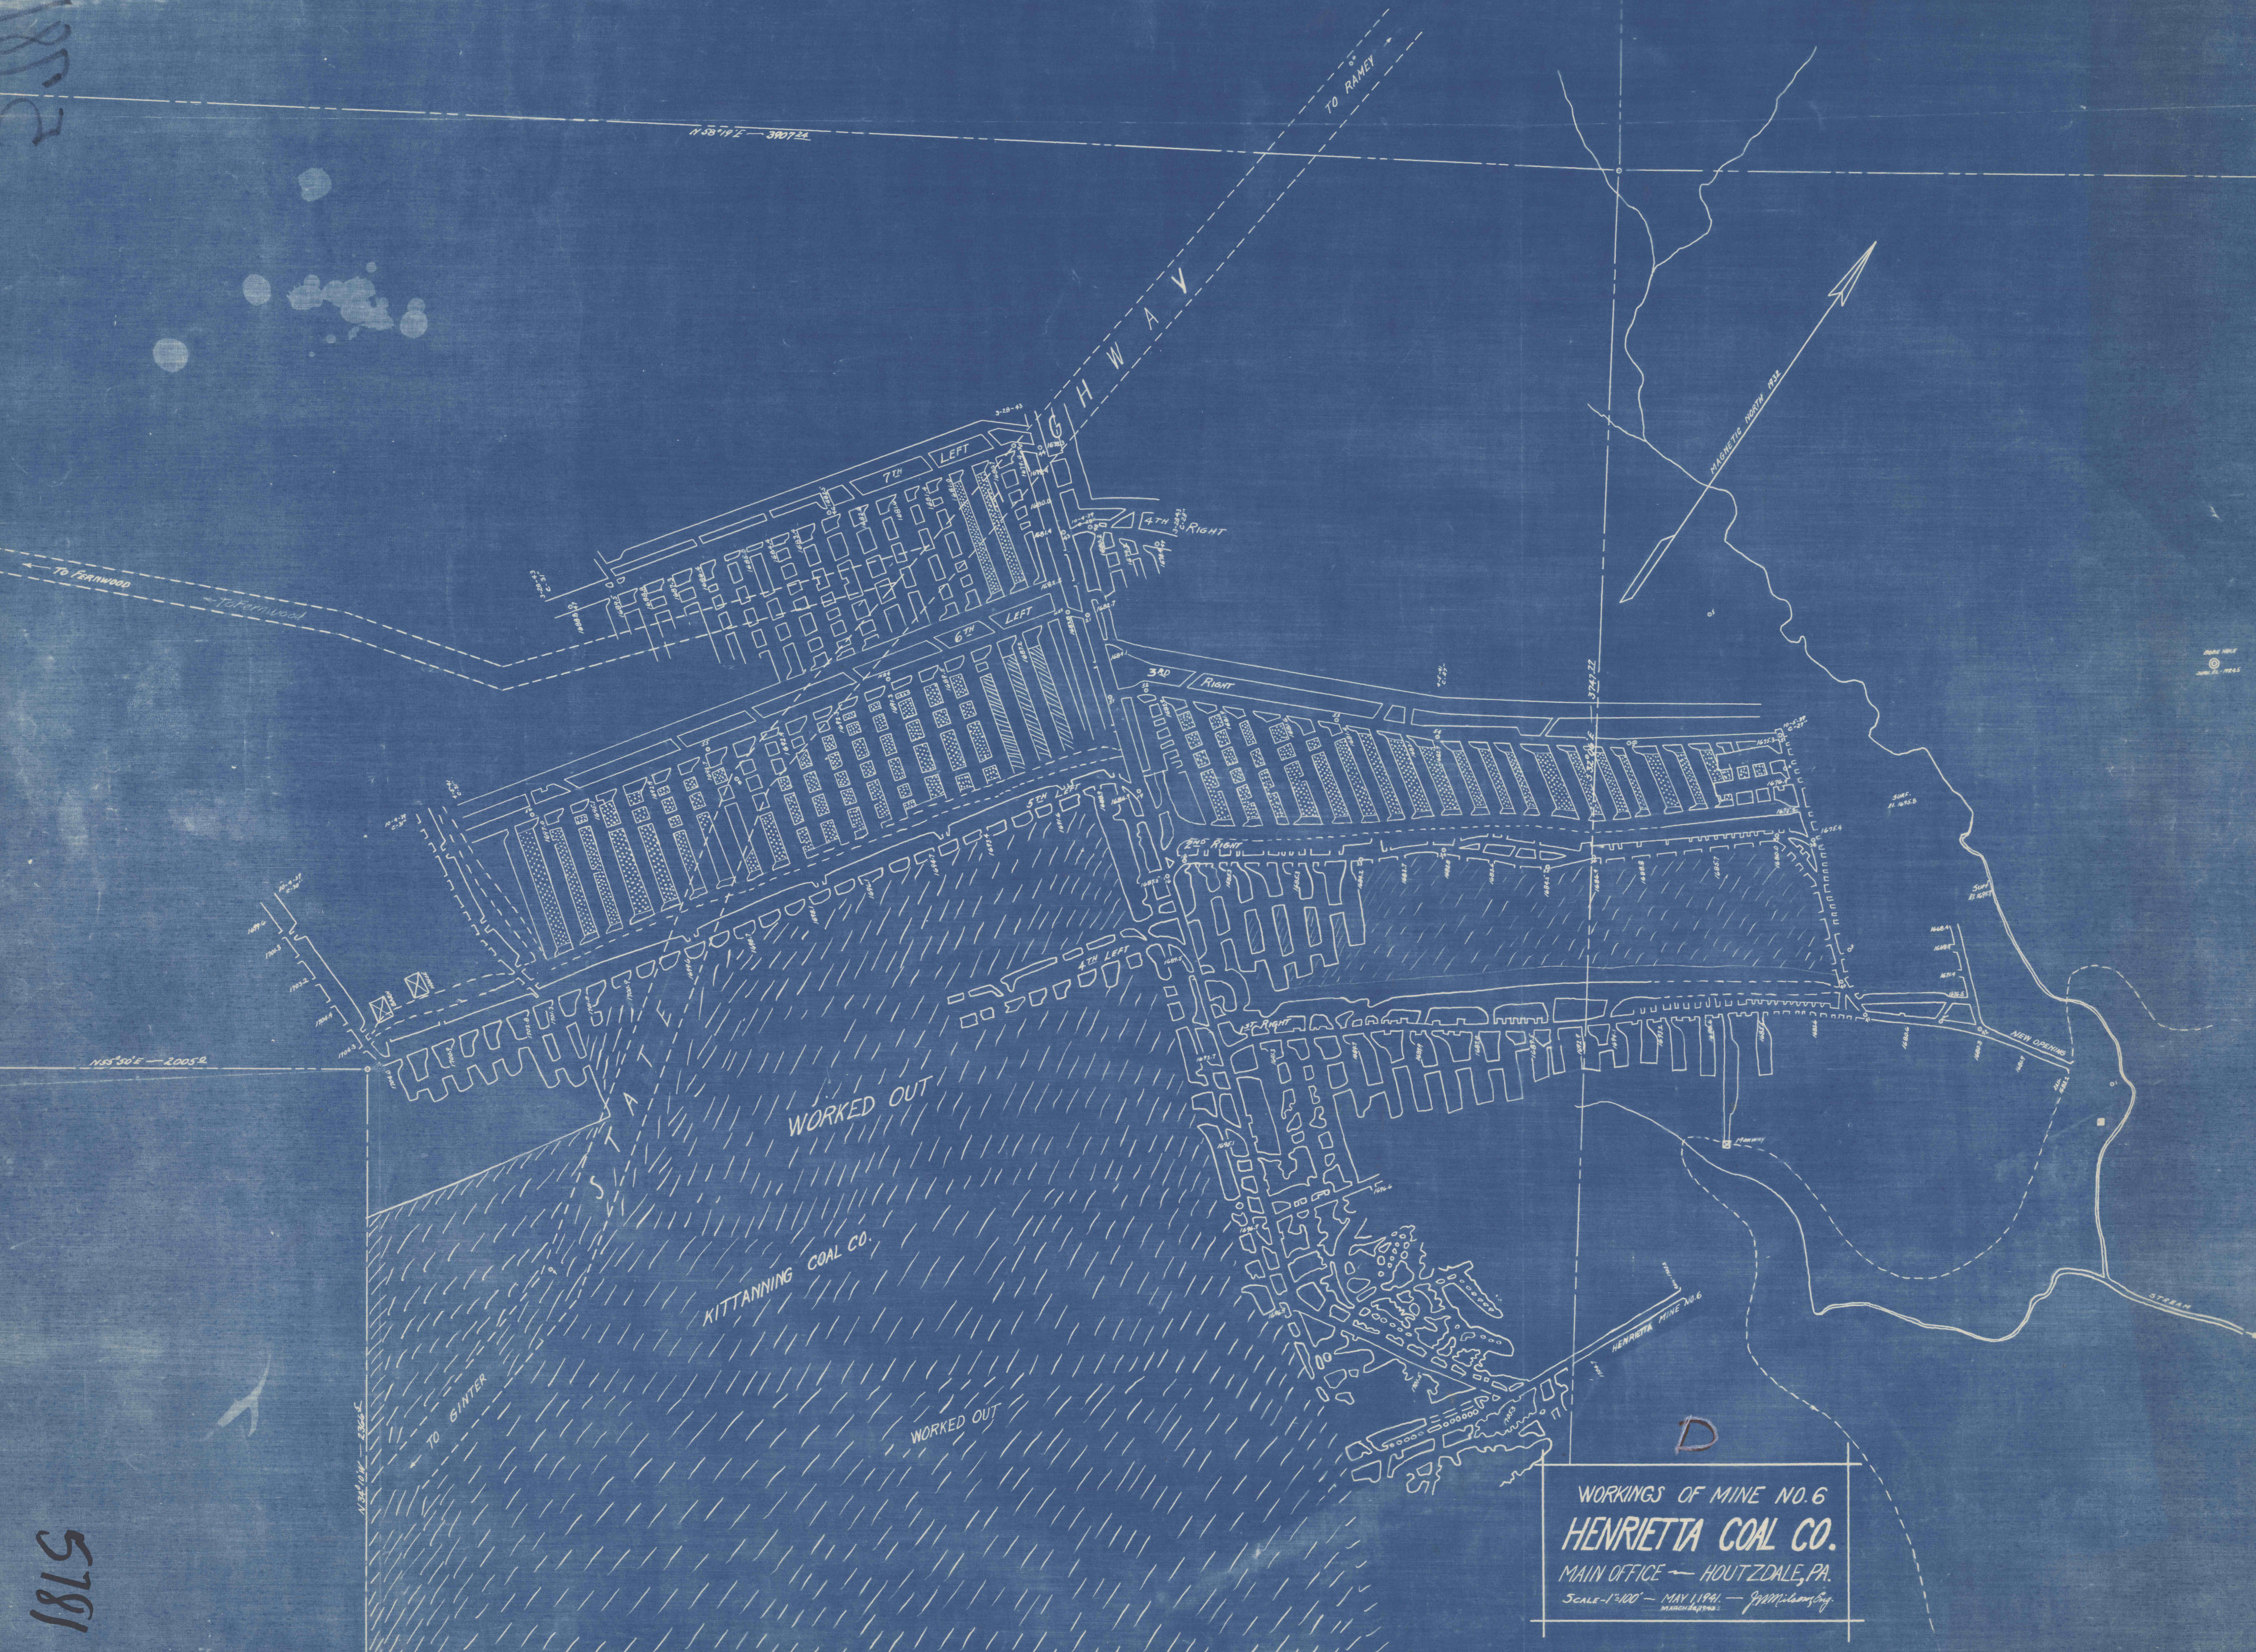

WORKINGS OF MINE NO. 6
HENRIETTA COAL CO.
 MAIN OFFICE — HOUTZDALE, PA.
 SCALE — 1"=100' — MAY 1, 1891. — J. M. [Signature]