

E. H. HUGHES

**D**  
**MAP OF**  
**RODEN COAL CO'S**  
OPERATION  
ON  
DANIEL AYRES EST.  
CLEARFIELD CO, PA.  
1921.

Scale 1"=100'  
SURVEYED TO  
DEC. 6<sup>TH</sup> 1922  

R. D. SHOWALTER EST

PHILIPS


PHILIPS

PHILIPS

R. C. HALE EST

DANIEL AYRES EST

5786

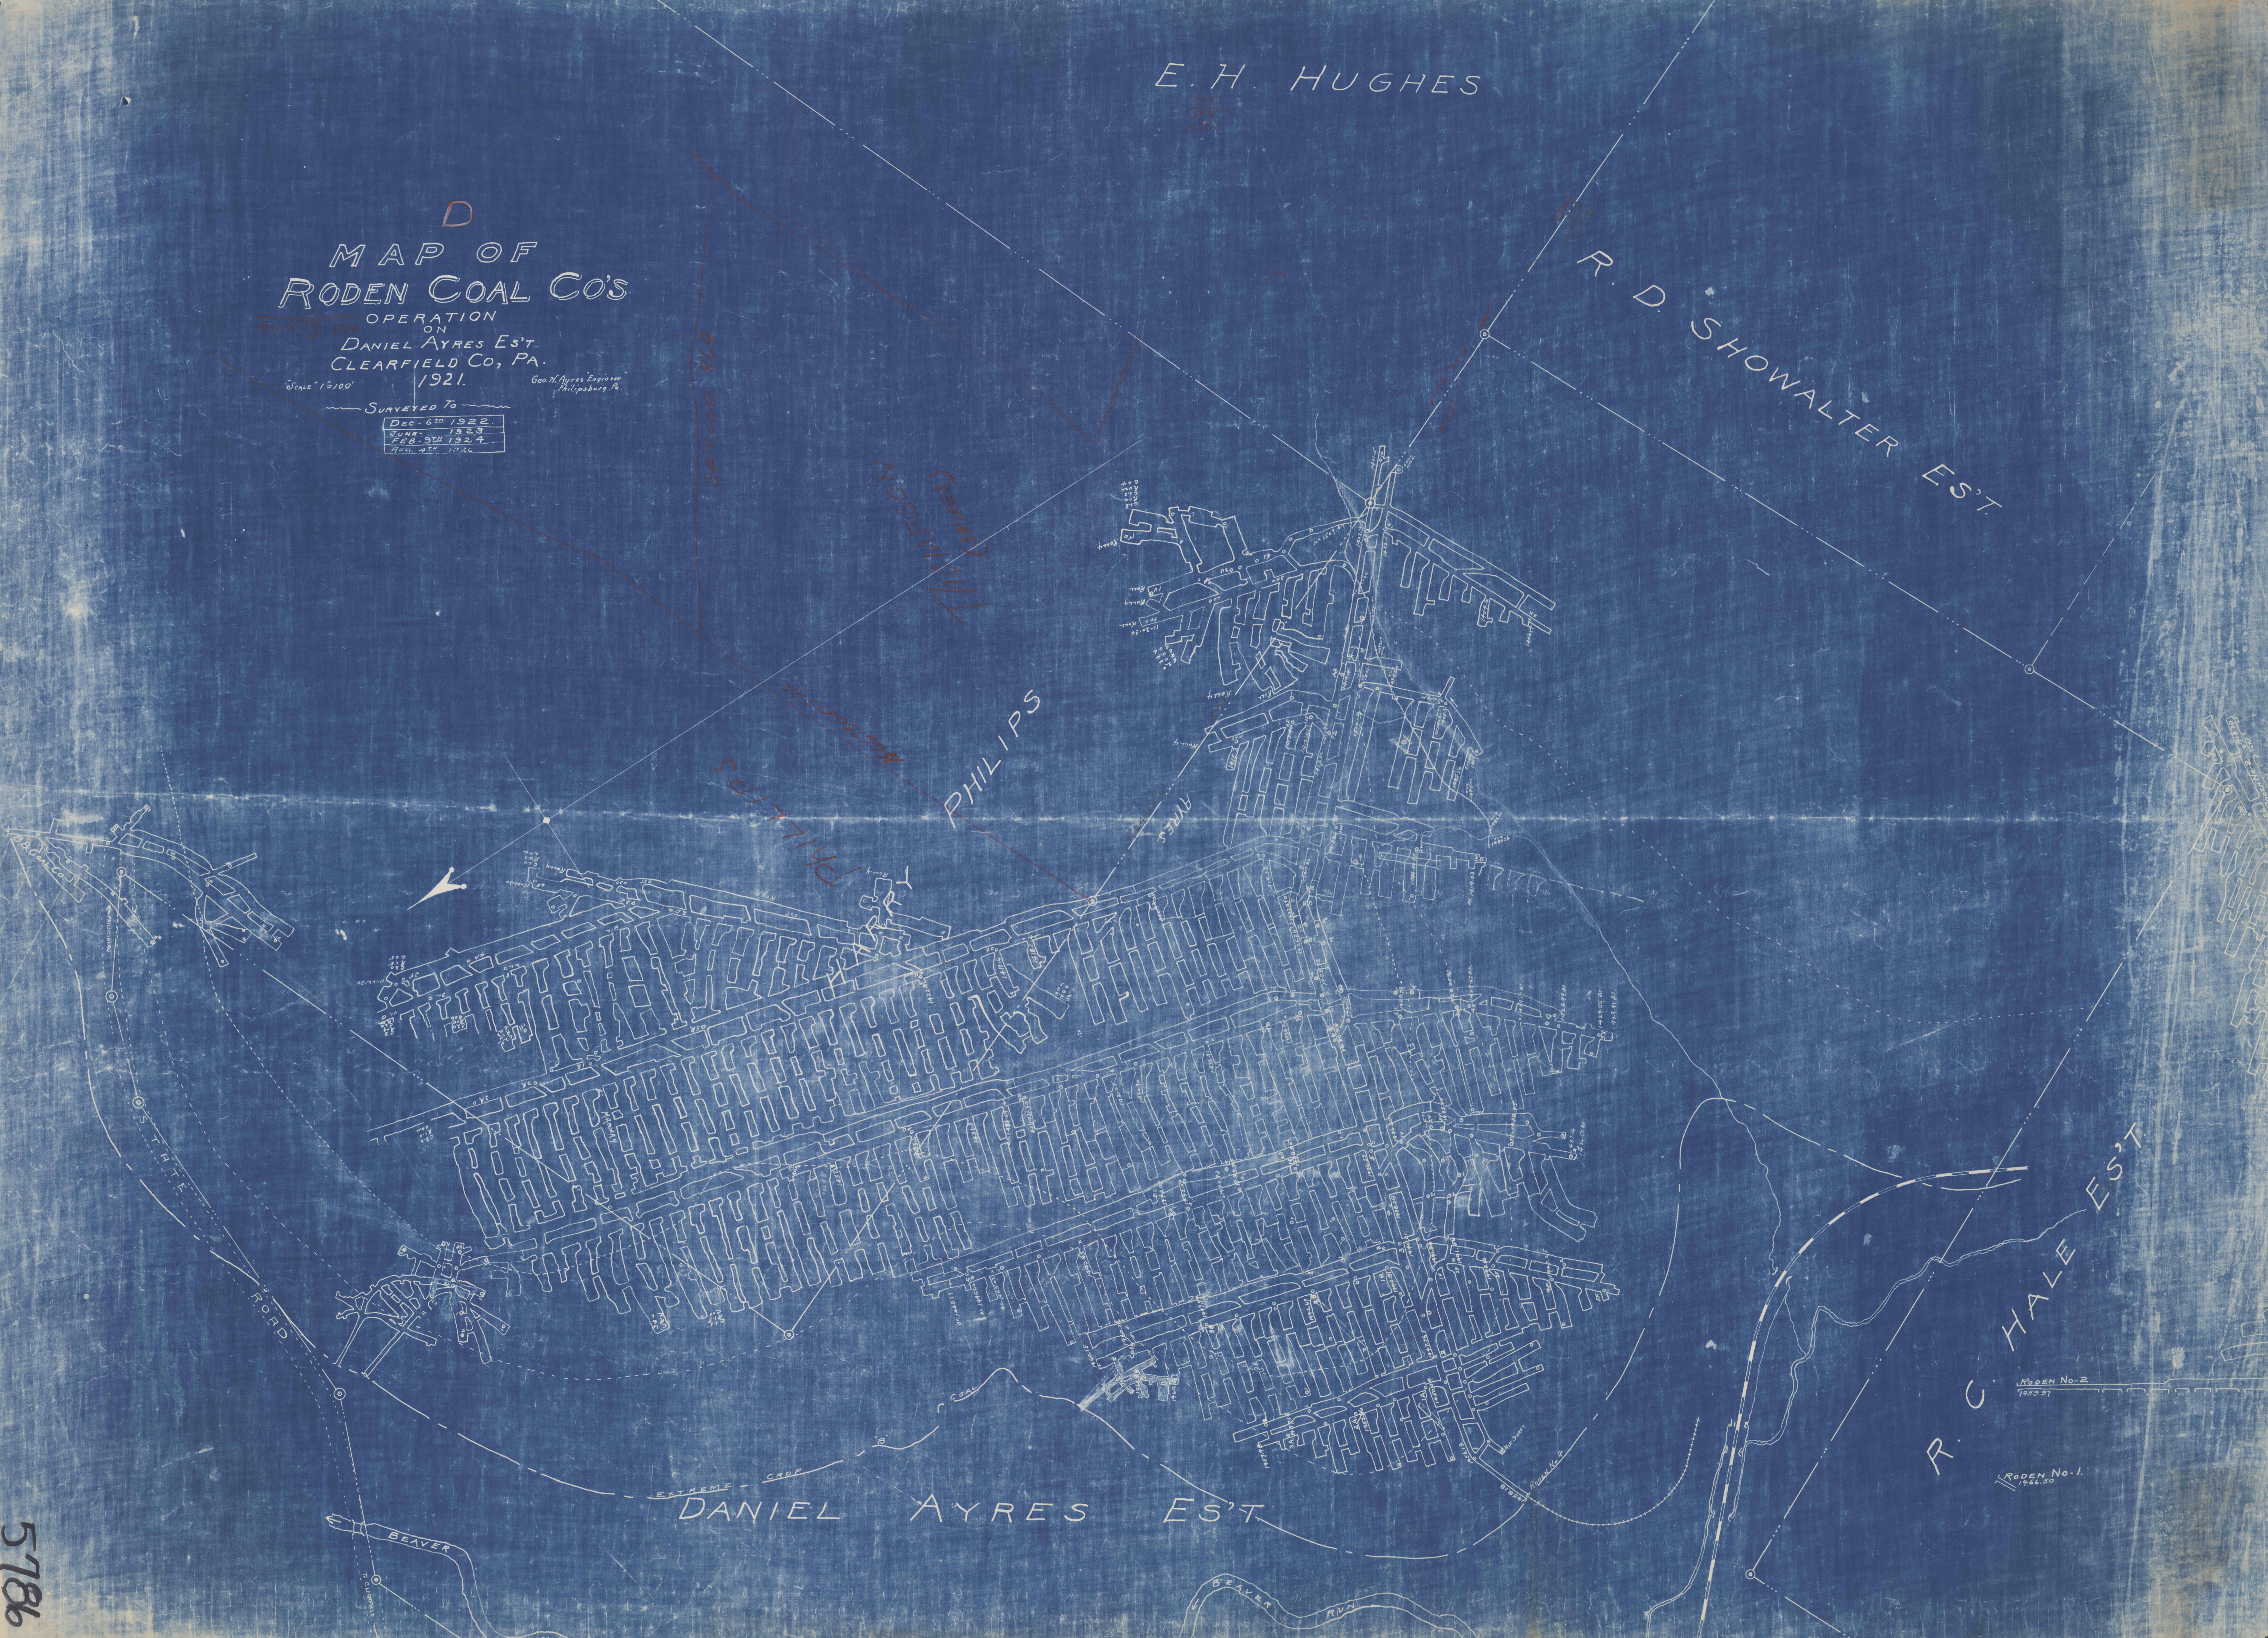

RODEN No. 2  
1923.37

RODEN No. 1  
1926.50