


CASPER COLLIER

PHILIPSBURG COAL & LAND CO

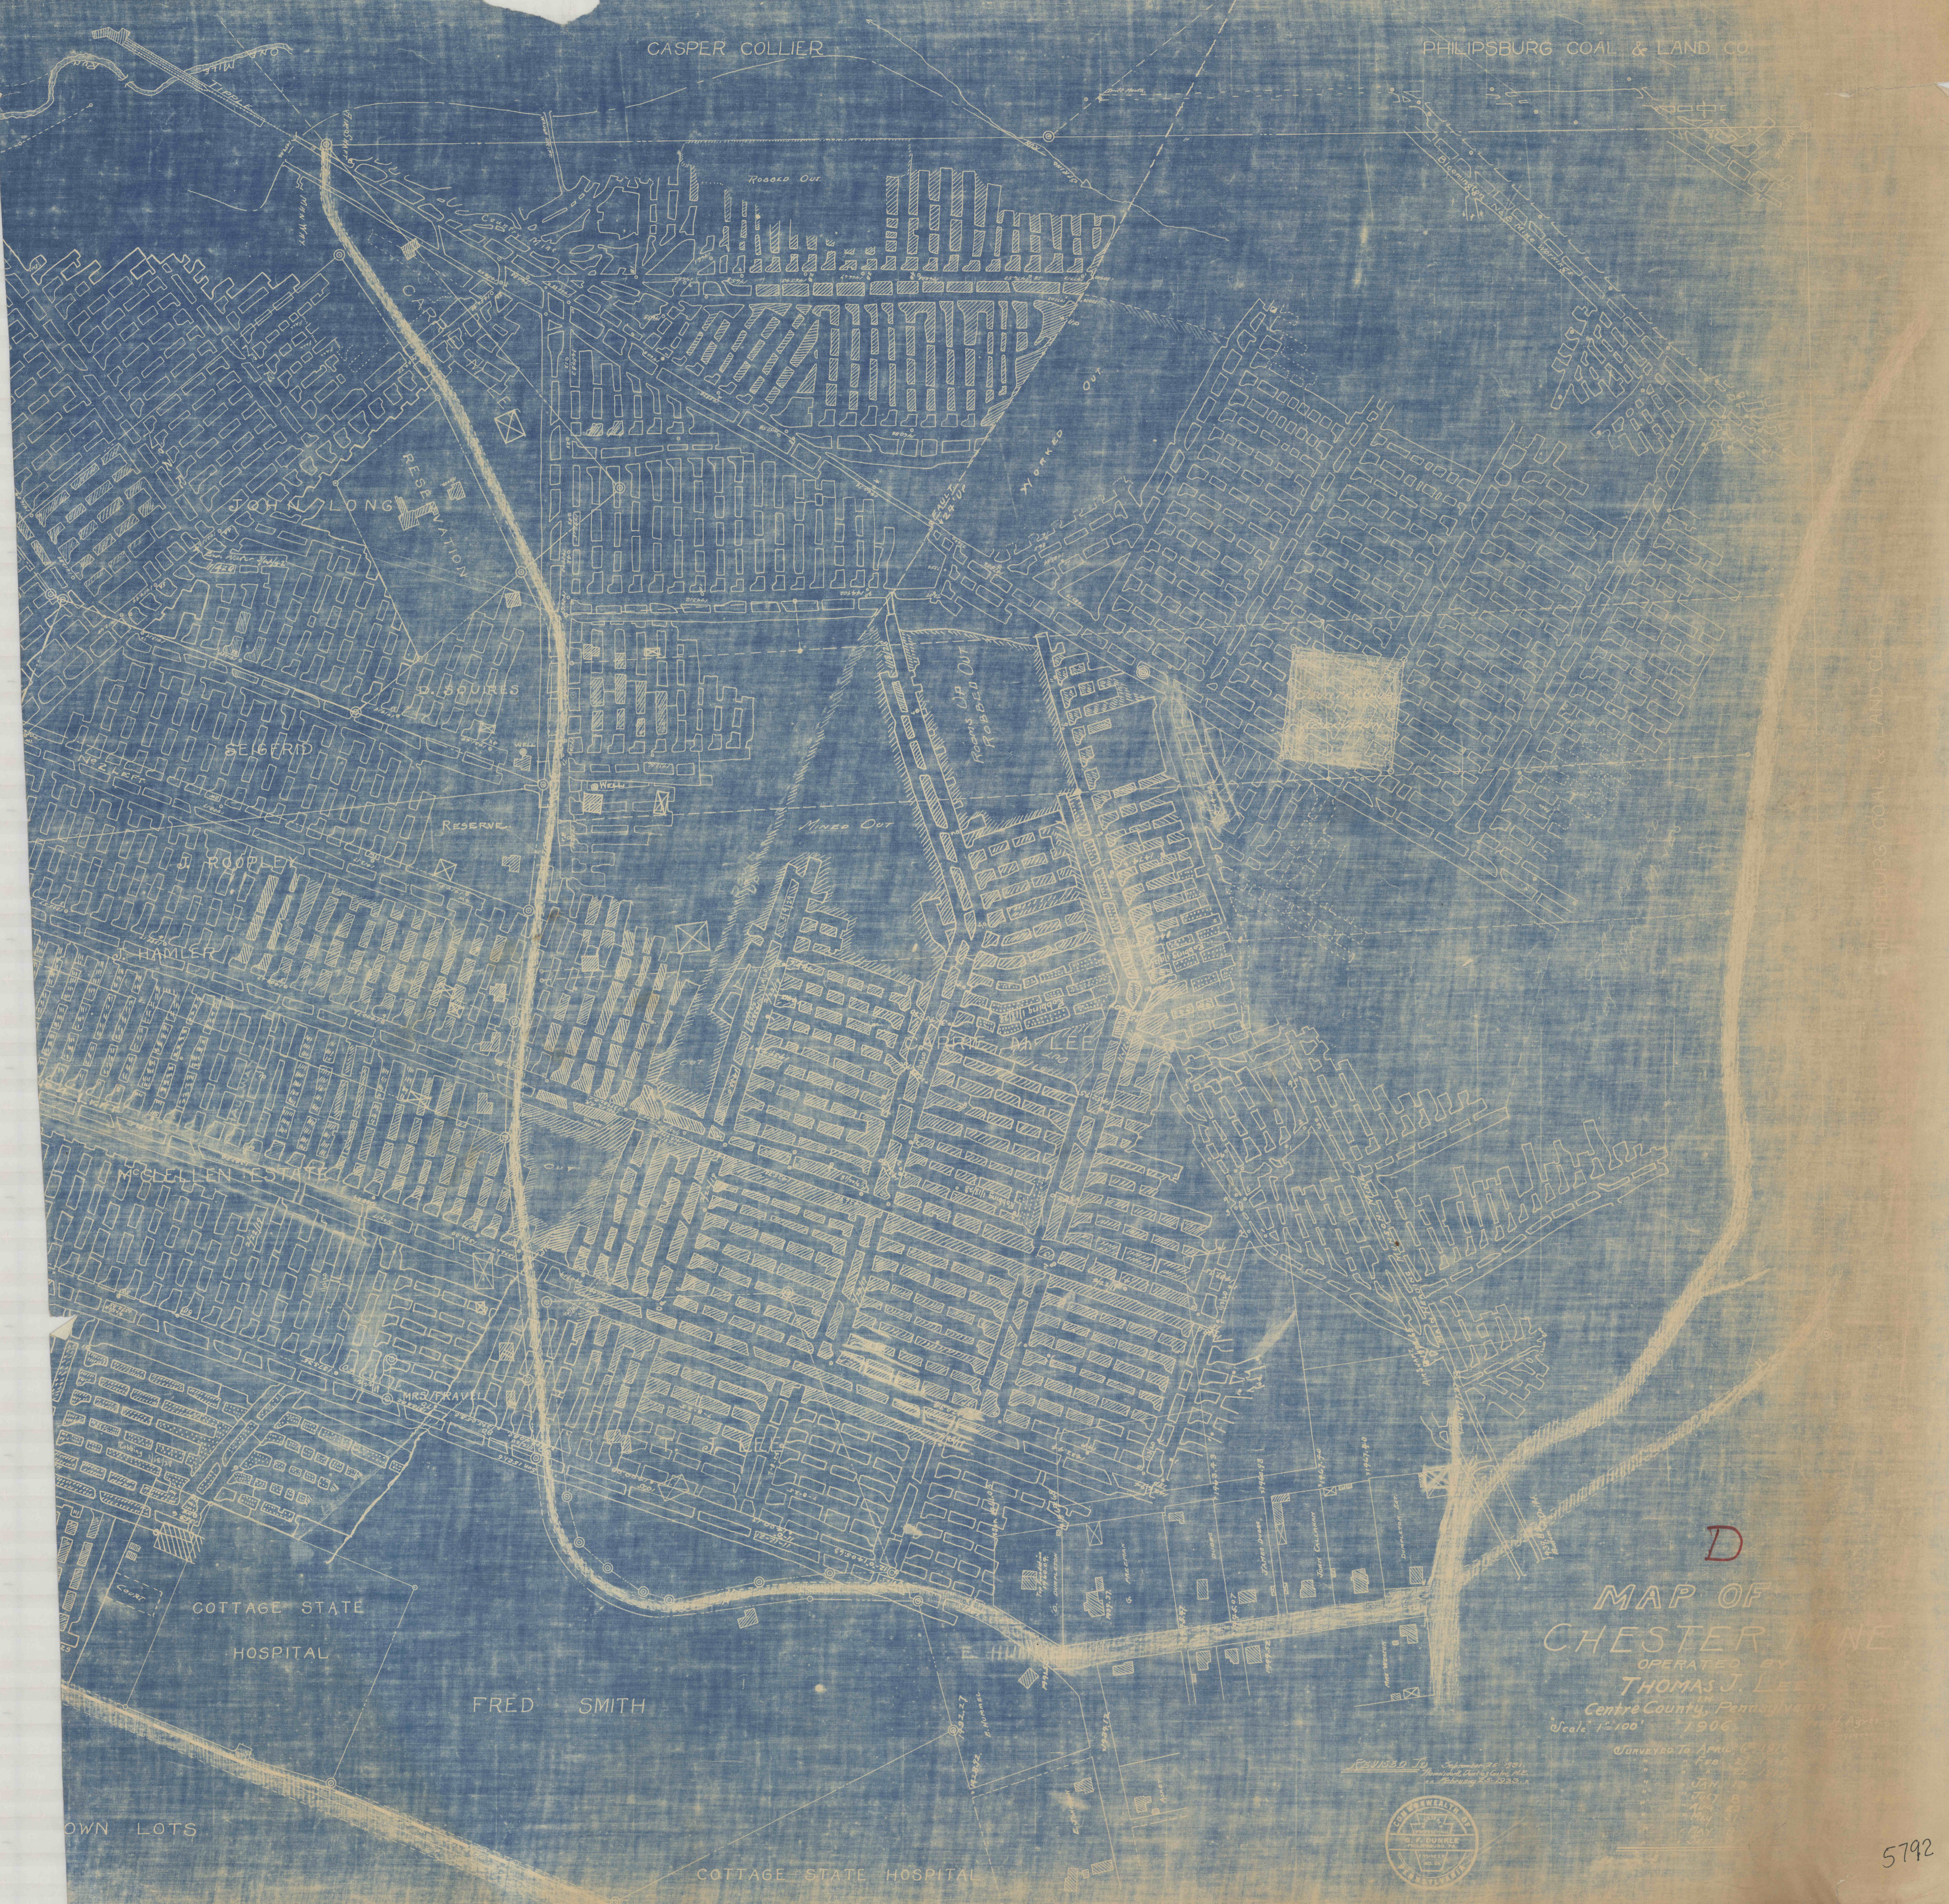

D  
 MAP OF  
 CHESTER MINE  
 OPERATED BY  
 THOMAS J. LEE  
 IN  
 Centre County, Pennsylvania  
 Scale 1"=100' 1906

REVISED TO September 25, 1911  
 Showing Changes Made  
 Between 1906 and 1911



SURVEYED BY APRIL 6, 1906  
 BY  
 THOMAS J. LEE  
