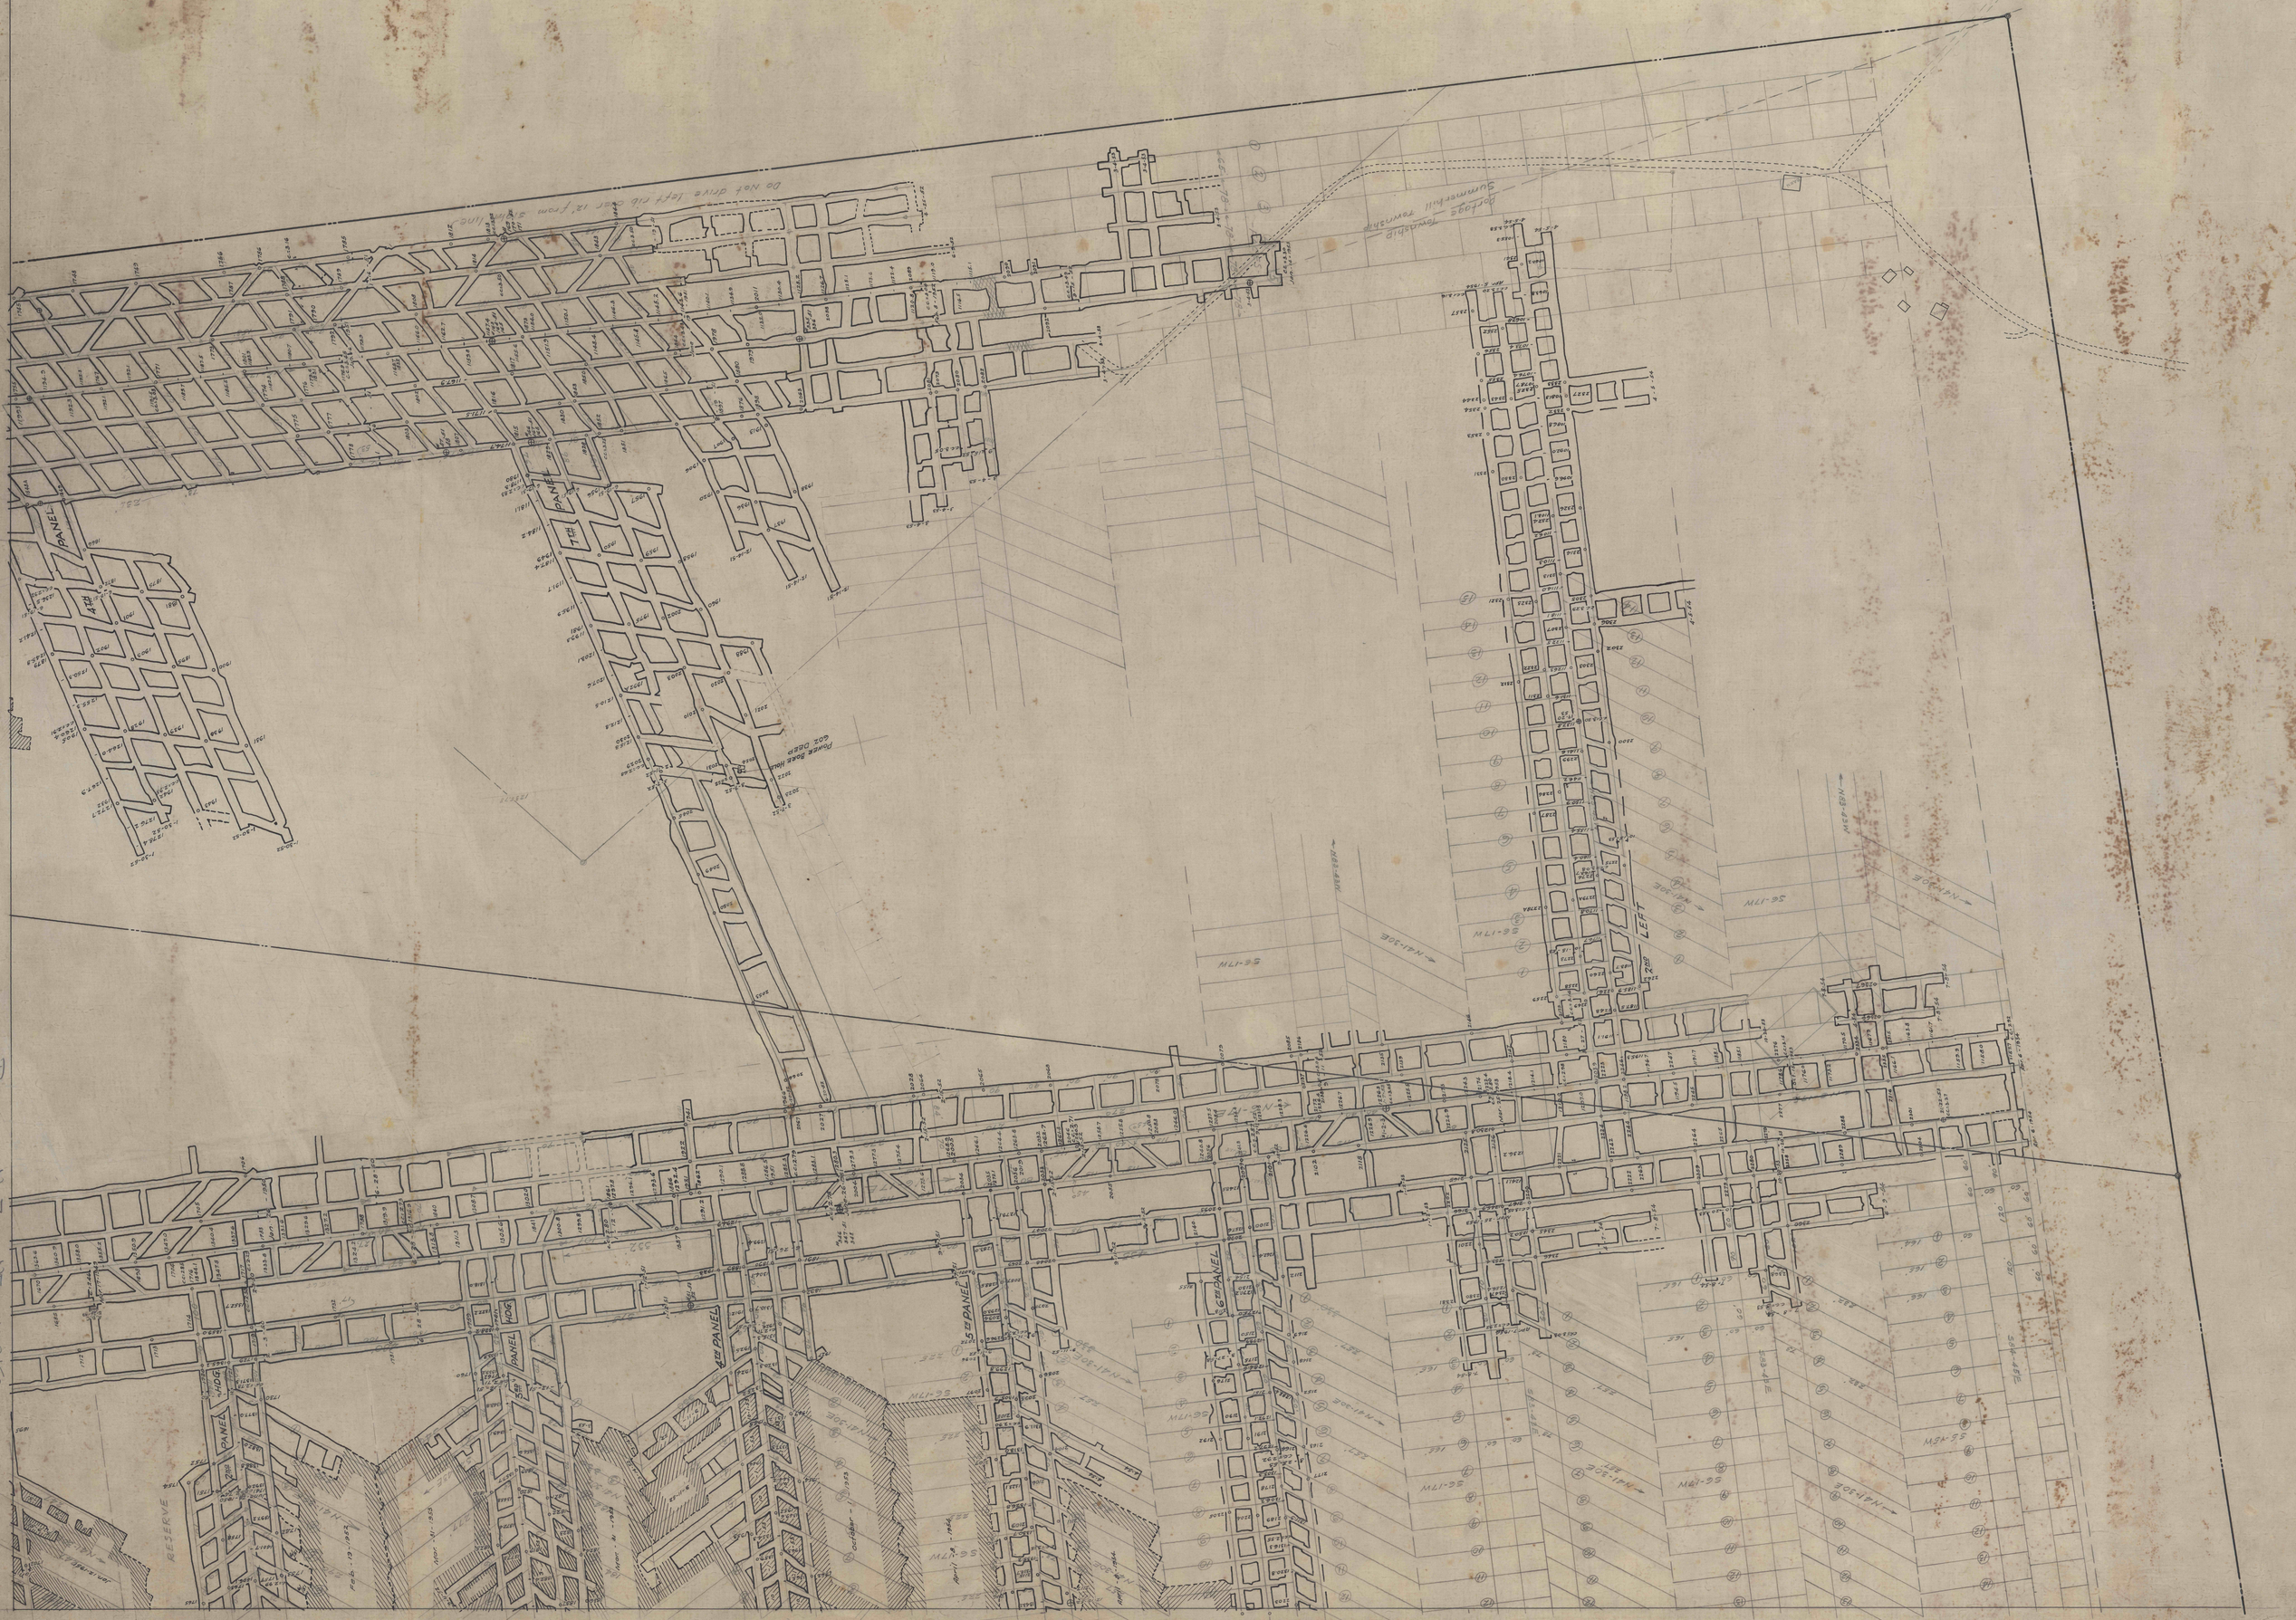
Do Not drive left kerb or 12' from 3rd line
Portage No 2
New Works
4th PANEL
5th PANEL
6th PANEL
7th PANEL
HOG PANEL
RESERVE
LEFT
MLI-3SE
MLI-3SW
