


1183
1182

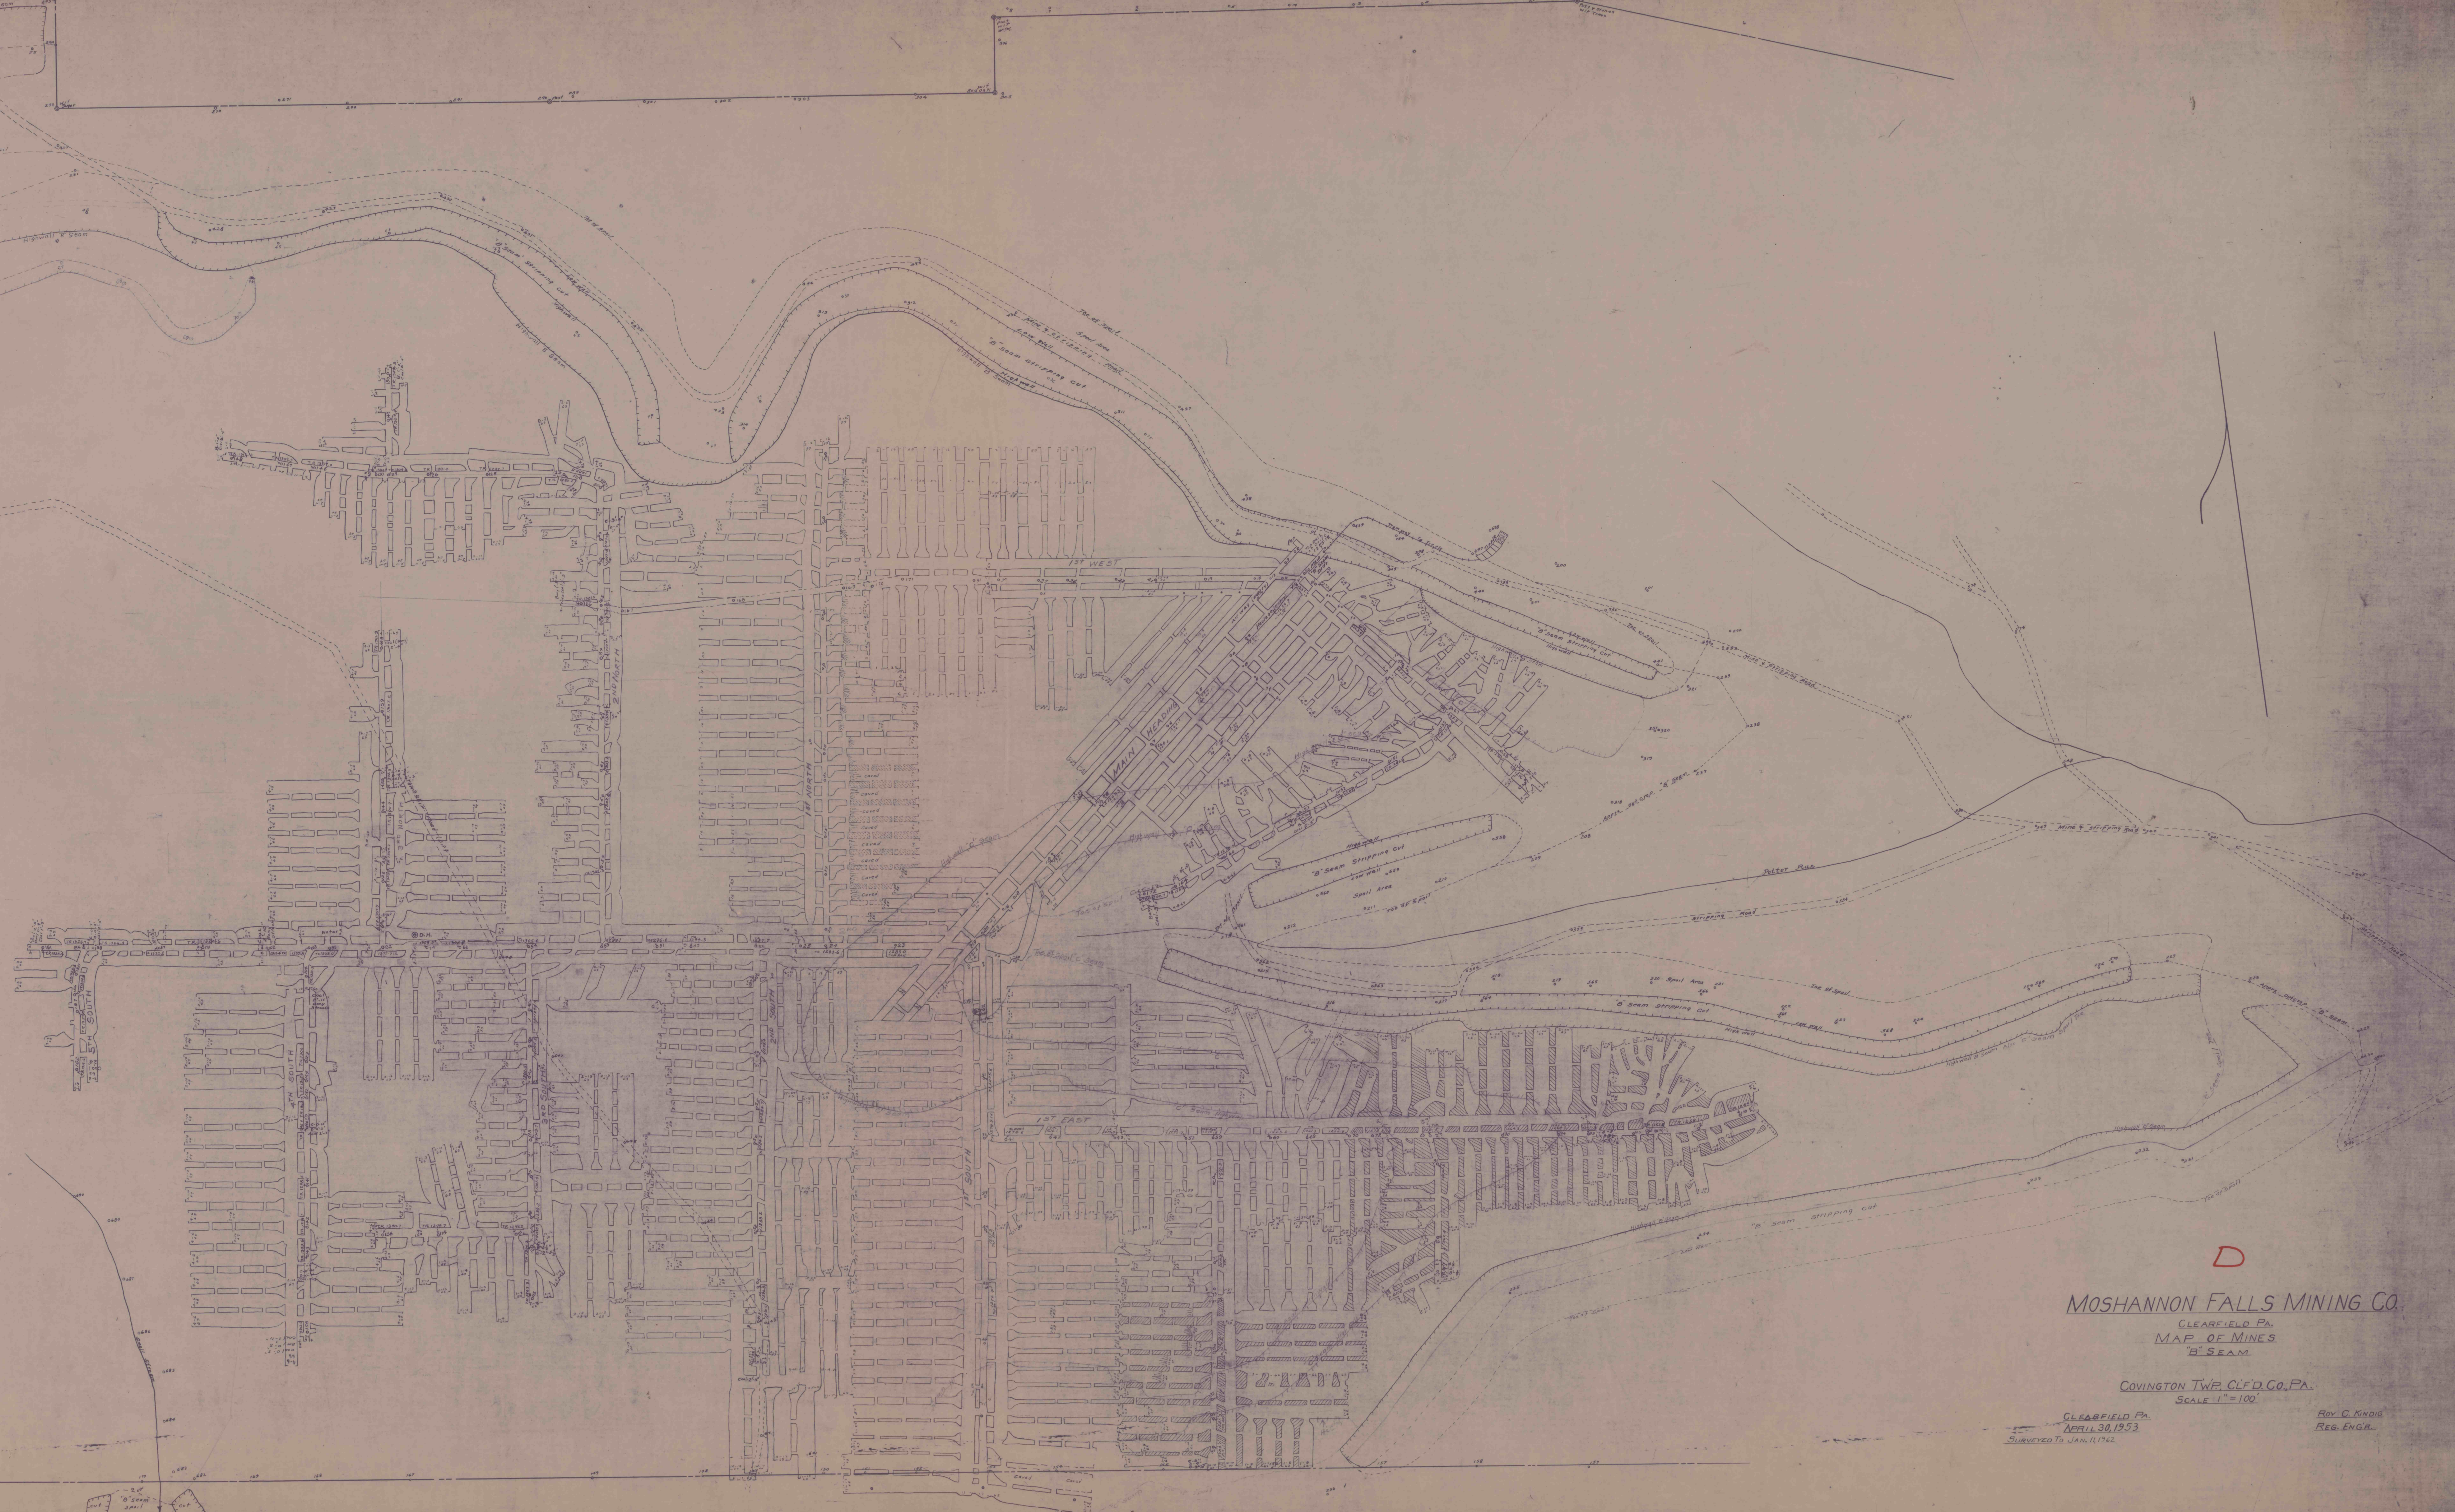

D
MOSHANNON FALLS MINING CO.
CLEARFIELD PA.
MAP OF MINES
"B" SEAM
COVINGTON TWP. CLFD. CO. PA.
SCALE 1" = 100'
CLEARFIELD PA.
APRIL 28, 1953
SURVEYED BY J. H. K. H. C.

ROY C. KNOX
REG. ENGR.

5846
5847