

PAUL M. HARTZFELD

PAUL M. HARTZFELD
NARGO CLAY LEASE

GEORGE CHARLES


GEORGE CHARLES

V.A. SHUBERT

RALPH THOMAS

NORTH AMERICAN REFRACTORIES
CO.

NOTE: ALL ELEVATIONS
REFERENCED TO U.S.G.S.
DATUM.

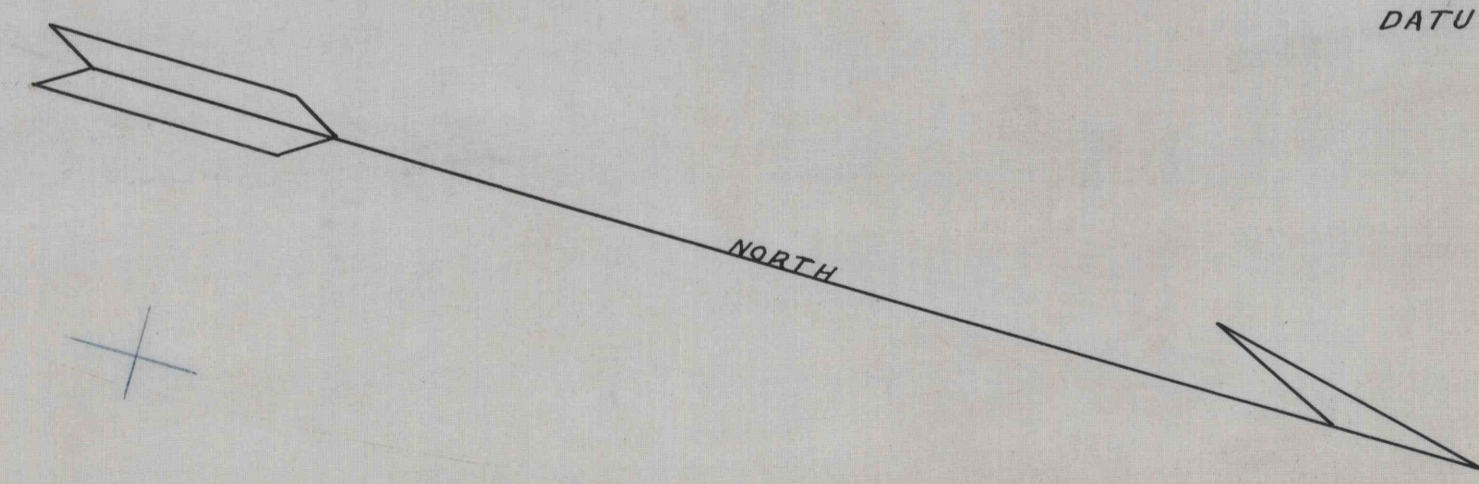

REVISED - 10-18-50 - J.R.H. Jr.
REVISED - 3-6-51 - J.R.H. Jr.
REVISED - 12-12-51 - J.R.H. Jr.
REVISED - 6-16-52 - J.R.H. Jr.
REVISED - 1-1-53 - M.W.D.
REVISED - 3-27-53 - M.W.D.
REVISED - 6-15-53 - J.R.H. Jr.
REVISED - 1-2-54 - J.R.H. Jr.

NORTH AMERICAN REFRACTORIES CO. 1012 NATIONAL CITY BANK BUILDING CLEVELAND, OHIO	
MAP OF CLAY MINE WORKINGS IN RELATION TO HIGHWAY NO. 322 RANKIN MINE - NARGO BLOOM TOWNSHIP, CLEARFIELD CO., PA.	
DRAWN J.R.H. Jr. CHECKED J.R.H. Jr. REFERENCE MAP	SCALE 1" = 100' DATE 2-2-50 TRACED BY J.R.H. Jr.
	59-2-20