


6027

M 318
150

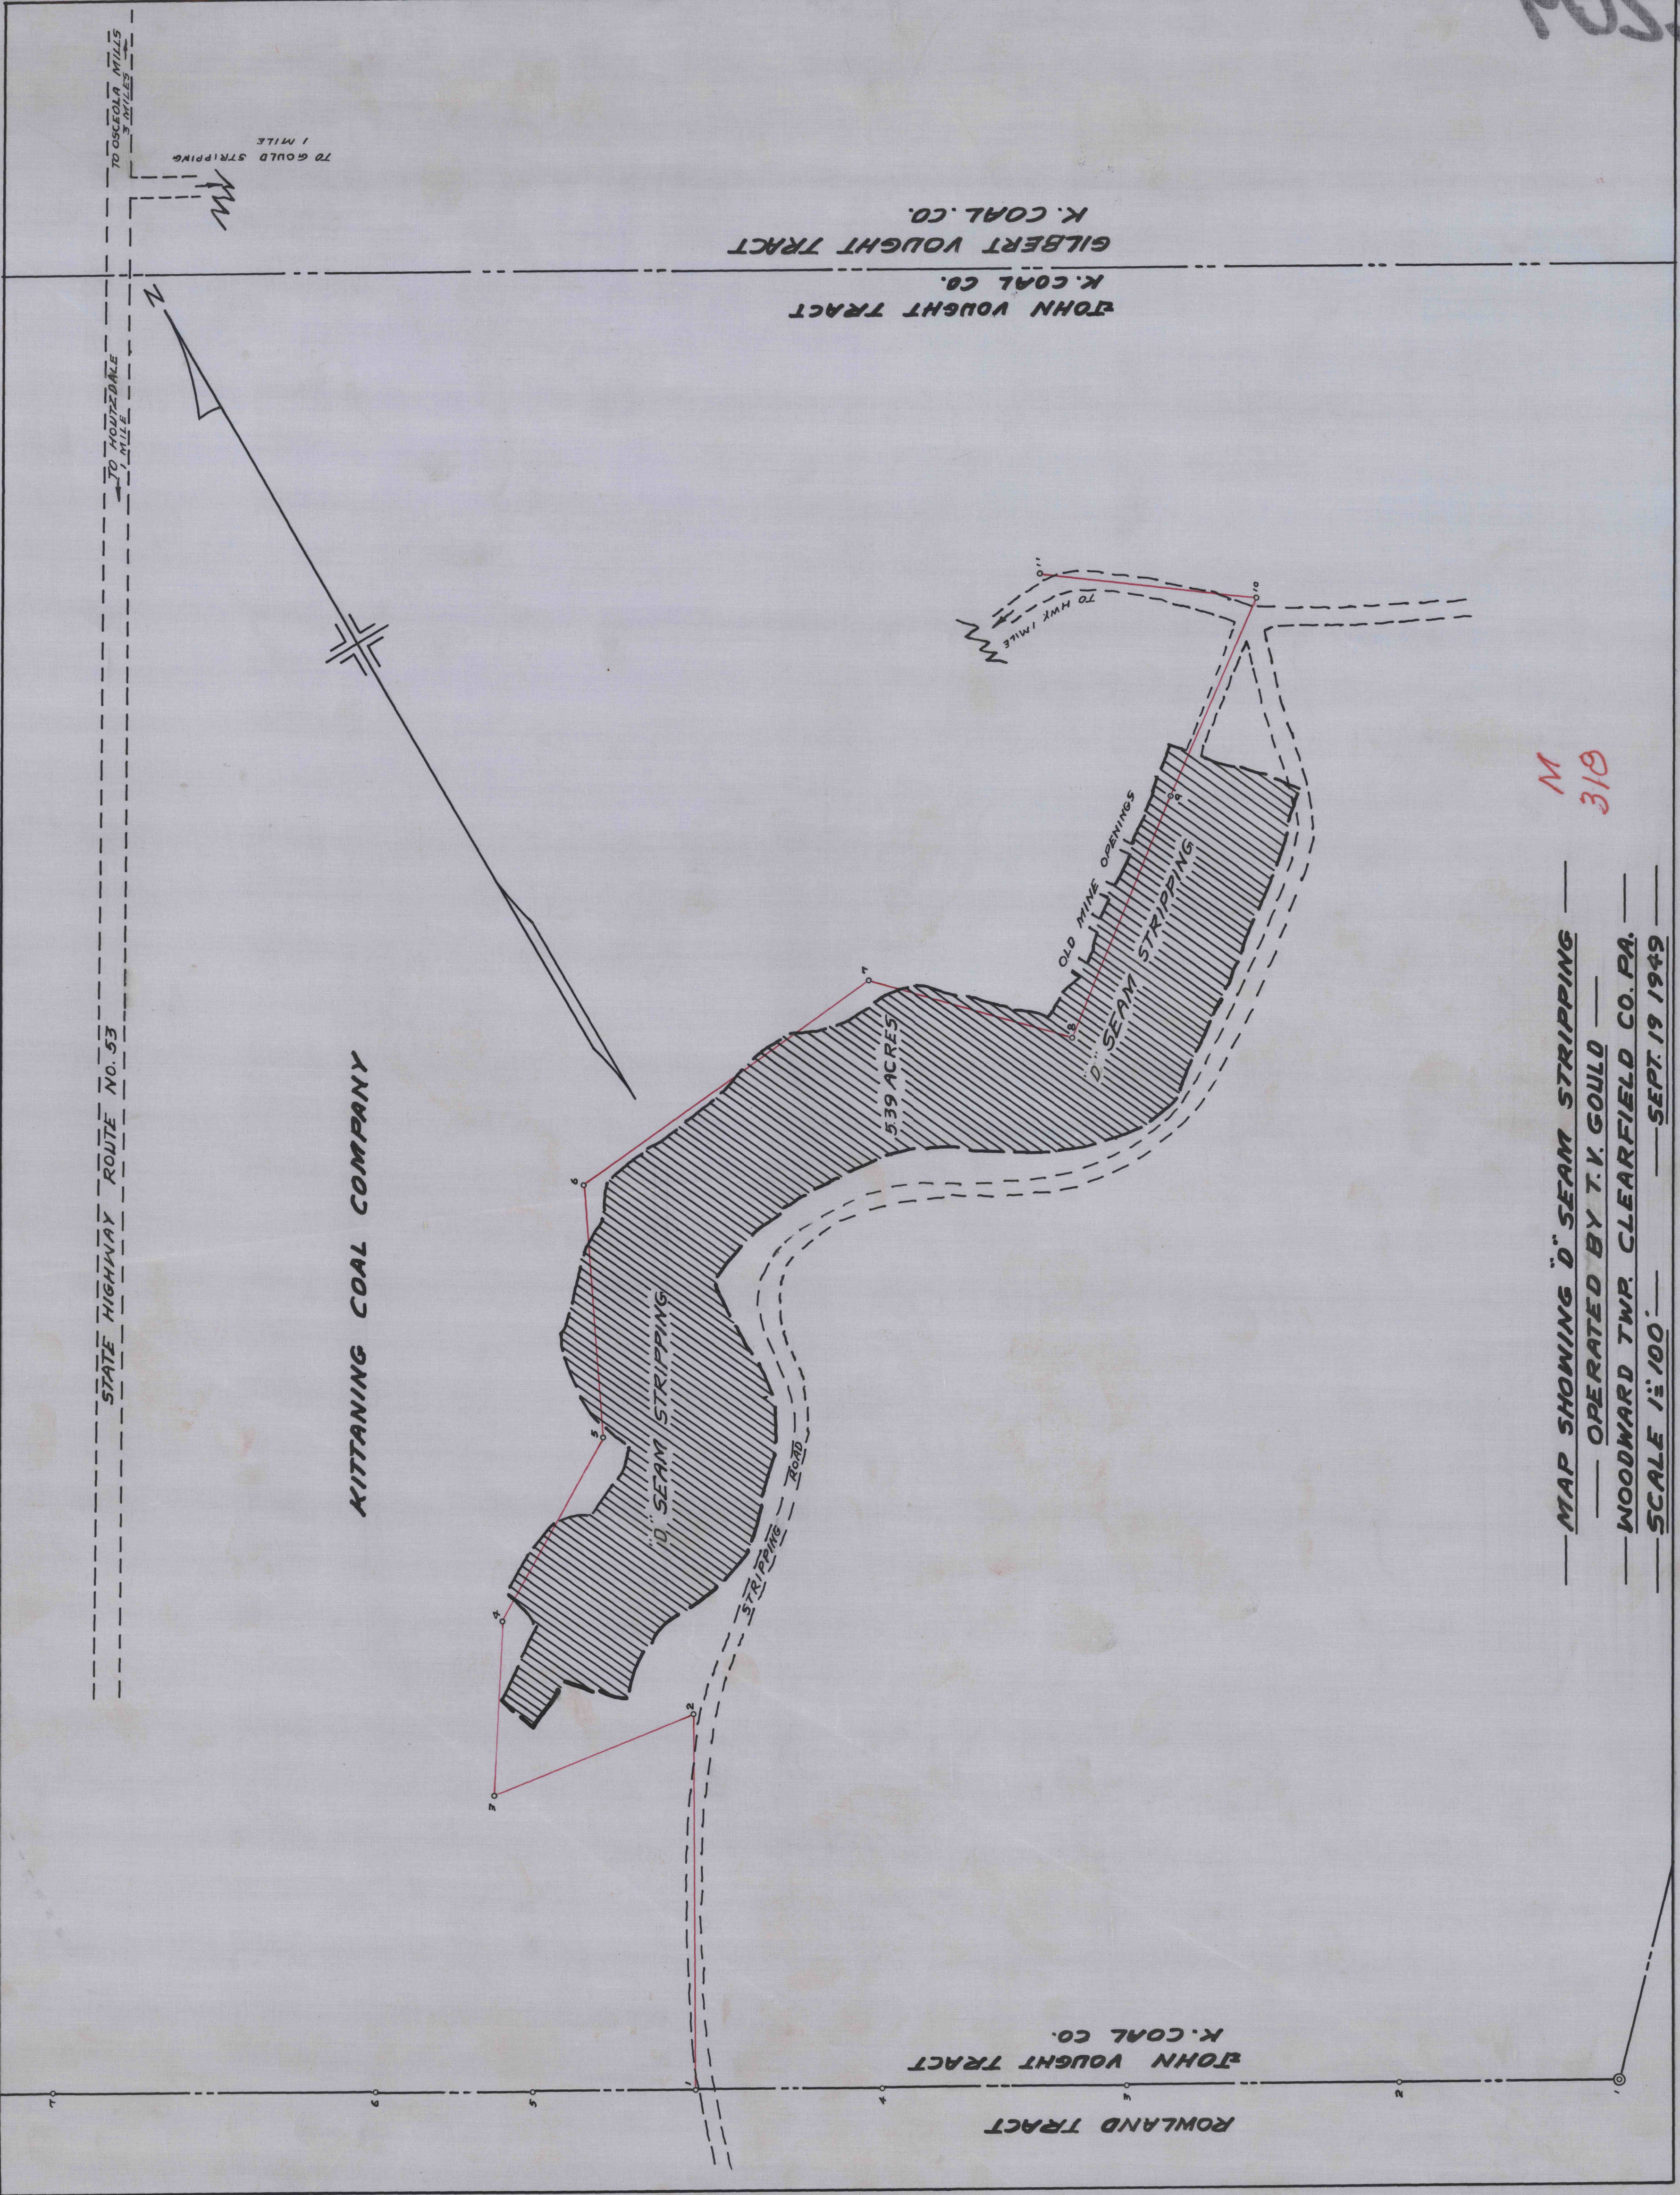

KITTANING COAL COMPANY

M 310

MAP SHOWING "D" SEAM STRIPPING
 OPERATED BY T. V. GOULD
 WOODWARD TWP. CLEARFIELD CO. PA.
 SCALE 1" = 100' SEPT. 19 1949

M 318